


SOUTH END
SCALE: 1" = 20'



NORTH END
SCALE: 1" = 20'

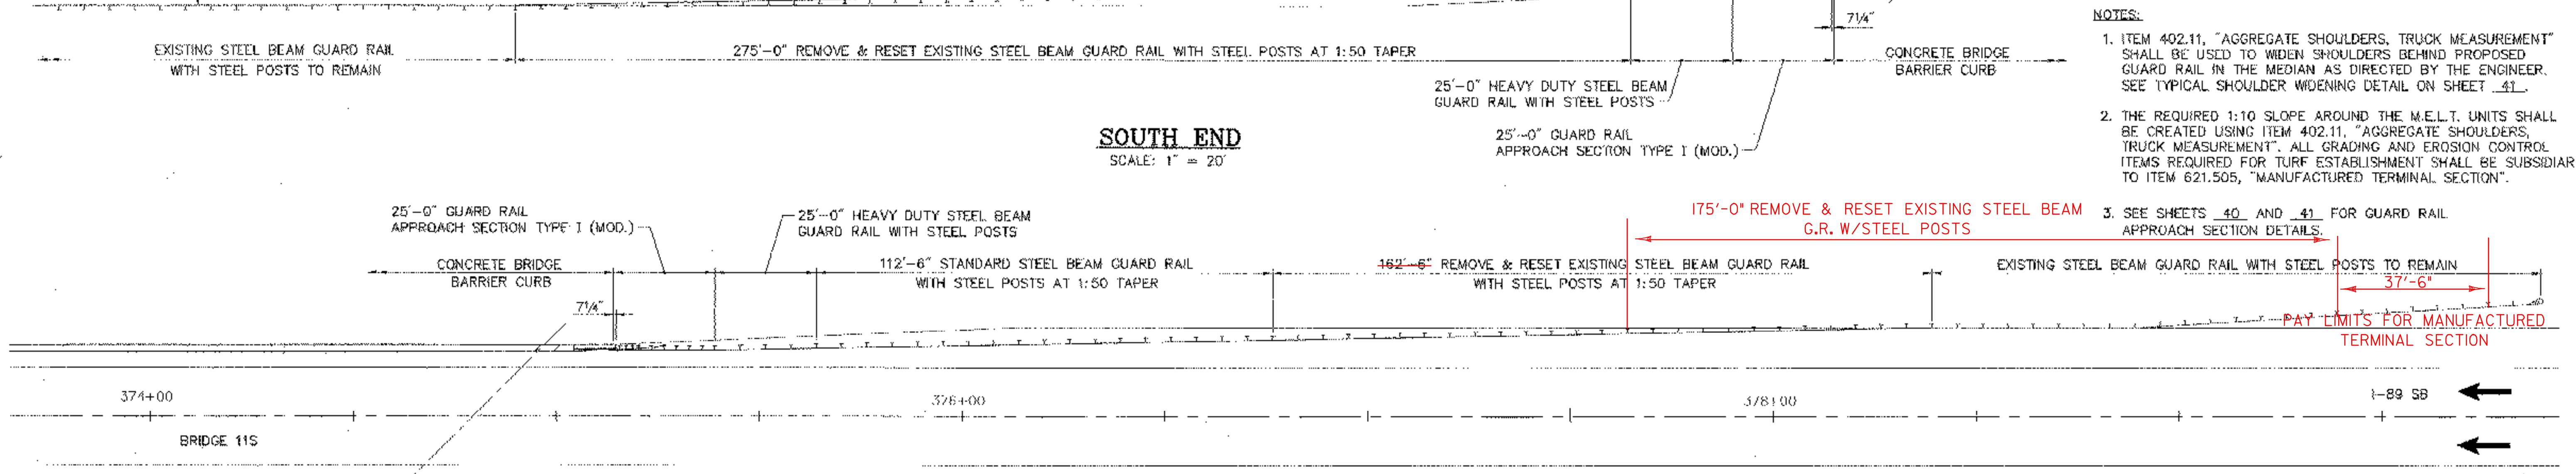

VANASSE HANGEN BRUSTLIN, INC.

STATE OF VERMONT AGENCY OF TRANSPORTATION			
Town Of	HARTFORD	Bridge No.	11N & 11S
Highway No.	I-89 NB & SB	Log Sta.	
I-89 NB & 11 SB OVER WHITE RIVER, VT 14 & NECR			
GUARD RAIL APPROACHES LAYOUT			
Designed By	T.S. BRYANT	Drawn By	B.J. MASSE
Checked By	S.M. HODGDON	Date	9/98
		Bridge Design Supervisor	C.D. BAKER
		Date	9/98
PROJECT	HARTFORD	PROJECT NO.	IR 089-1(13)
VHB Cad Filename 50899GRL		Sheet 45 of 101	
Bridge Sheet No. 45			