




TYPICAL DECK SECTION
Scale 3/4 in = 1 ft

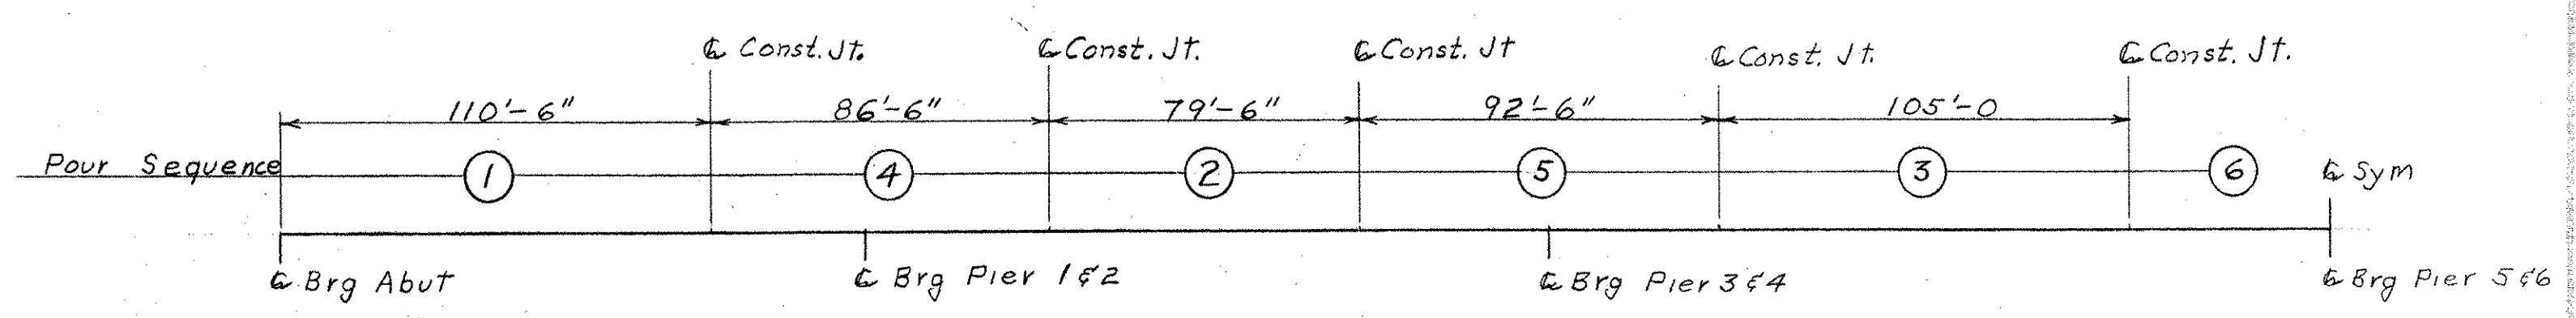

DECK POUR PLAN
Not To Scale

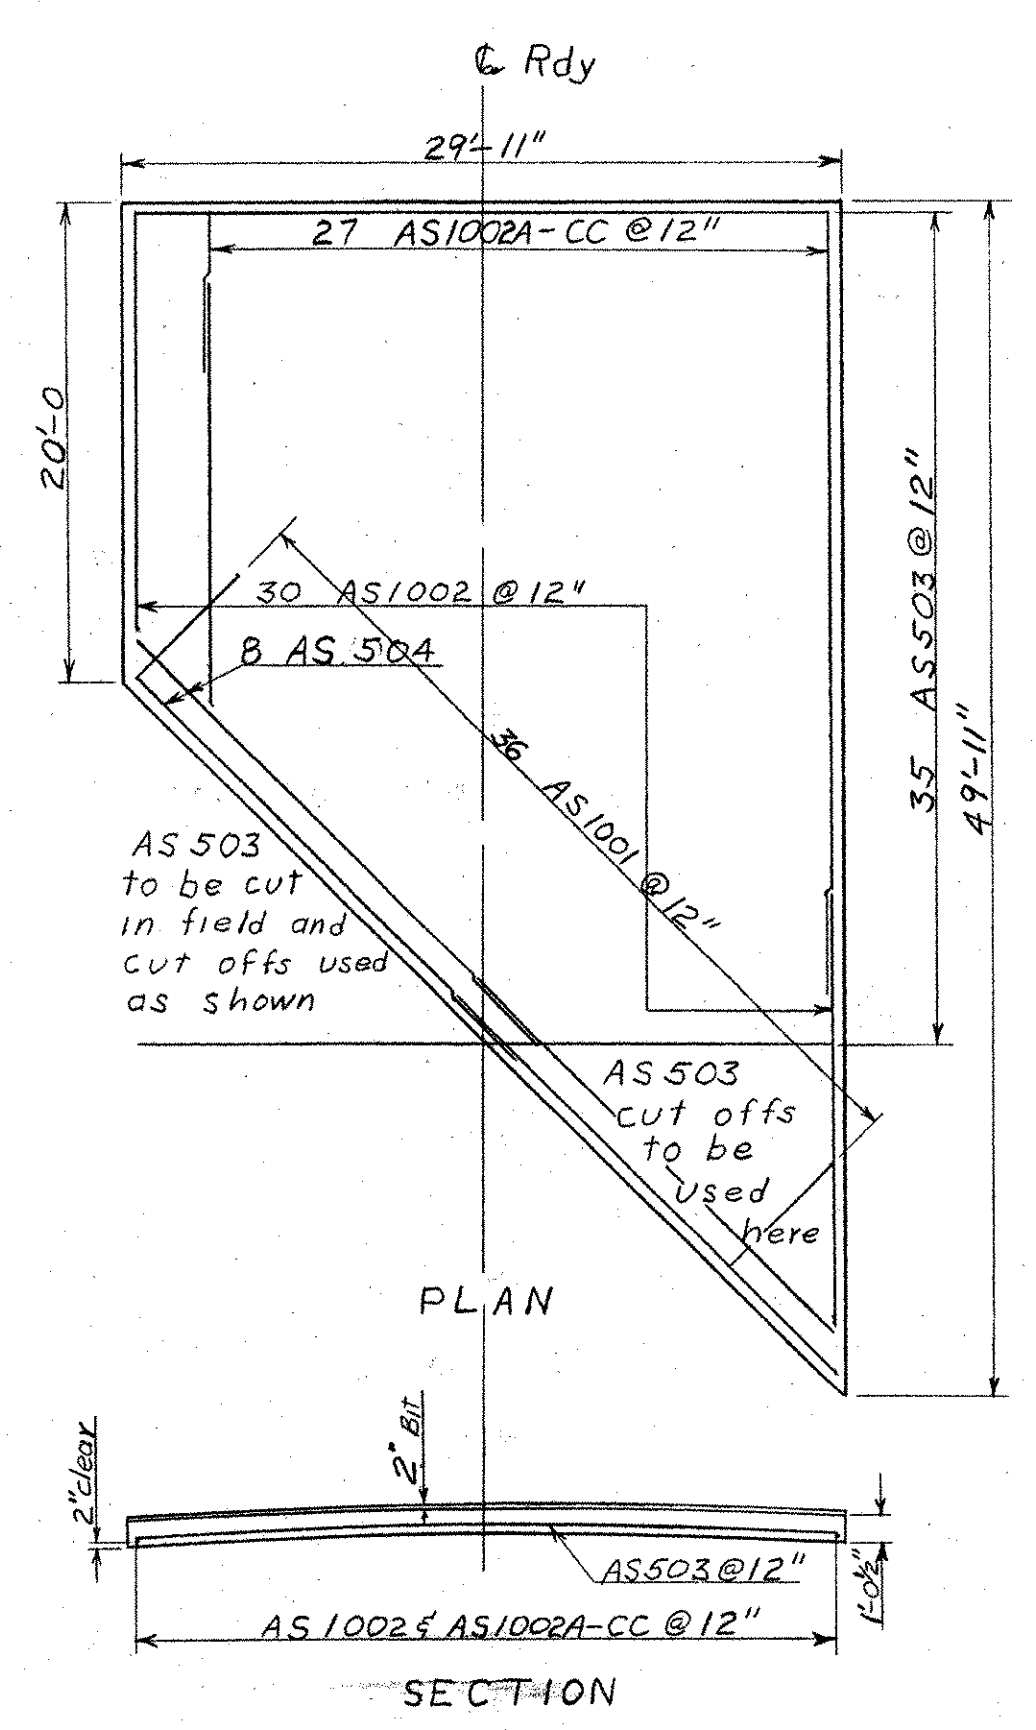

APPROACH SLAB DETAILS
Scale 1/8 in = 1 ft

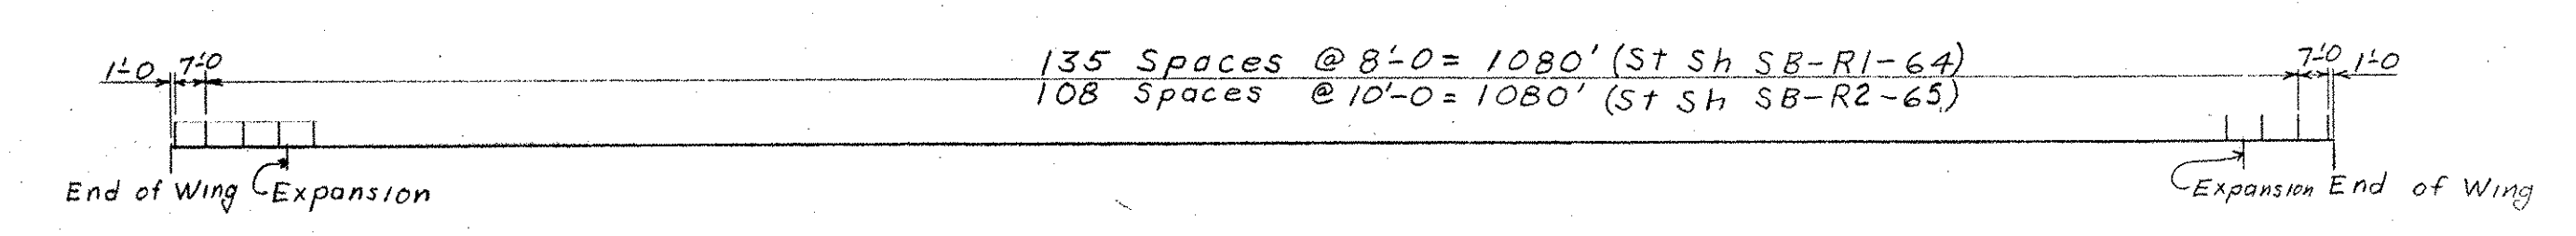

Note: All rails to be spliced at expansion points with a 4" gap at the splice.
For Railing Details See Std Sh SB R1 64 sh 1 & 2 and SB R2 65.

RAIL POST SPACING
Not To Scale

ITEM NO.	ITEM	UNIT	NET	TOTAL	FINAL
	CHAN. EXCAV. OF EARTH	C. Y.			
	CHAN. EXCAV. OF ROCK	C. Y.			
	UNCLASS. CHAN. EXCAV.	C. Y.			
	STRUCT. EXCAV.	C. Y.			
	CONC. CLASS AA (MOD.)	C. Y.			
	CONC. CLASS B (MOD.)	C. Y.			
	REINF. STEEL	LBS.			
	ASPHALTIC-ASB. COATING	S. Y.			
	TREATED TIMBER PILING	L. F.			
	SPLICES FOR STEEL PILING	EA.			
	STEEL PILING	L. F.			
	UNTREATED TIMBER PILING	L. F.			

IR 089-1(13)
This sheet for information only
BR 11 N & S

BR 107 of 128

STATE OF VERMONT
DEPARTMENT OF HIGHWAYS

TOWN OF HARTFORD
ROUTE No. I-89 LOG STA. 369
I 89 OVER WHITE RIVER, VT #14, CVRR
SLAB DETAILS

SCALE As Shown
SURVEYED BY _____ CHECKED BY W.B.T.
DRAWN BY AGC
PROJECT No. I 89-1(6)
SHEET 15 OF 59