




PLAN
Scale 1/8 in = 1 ft

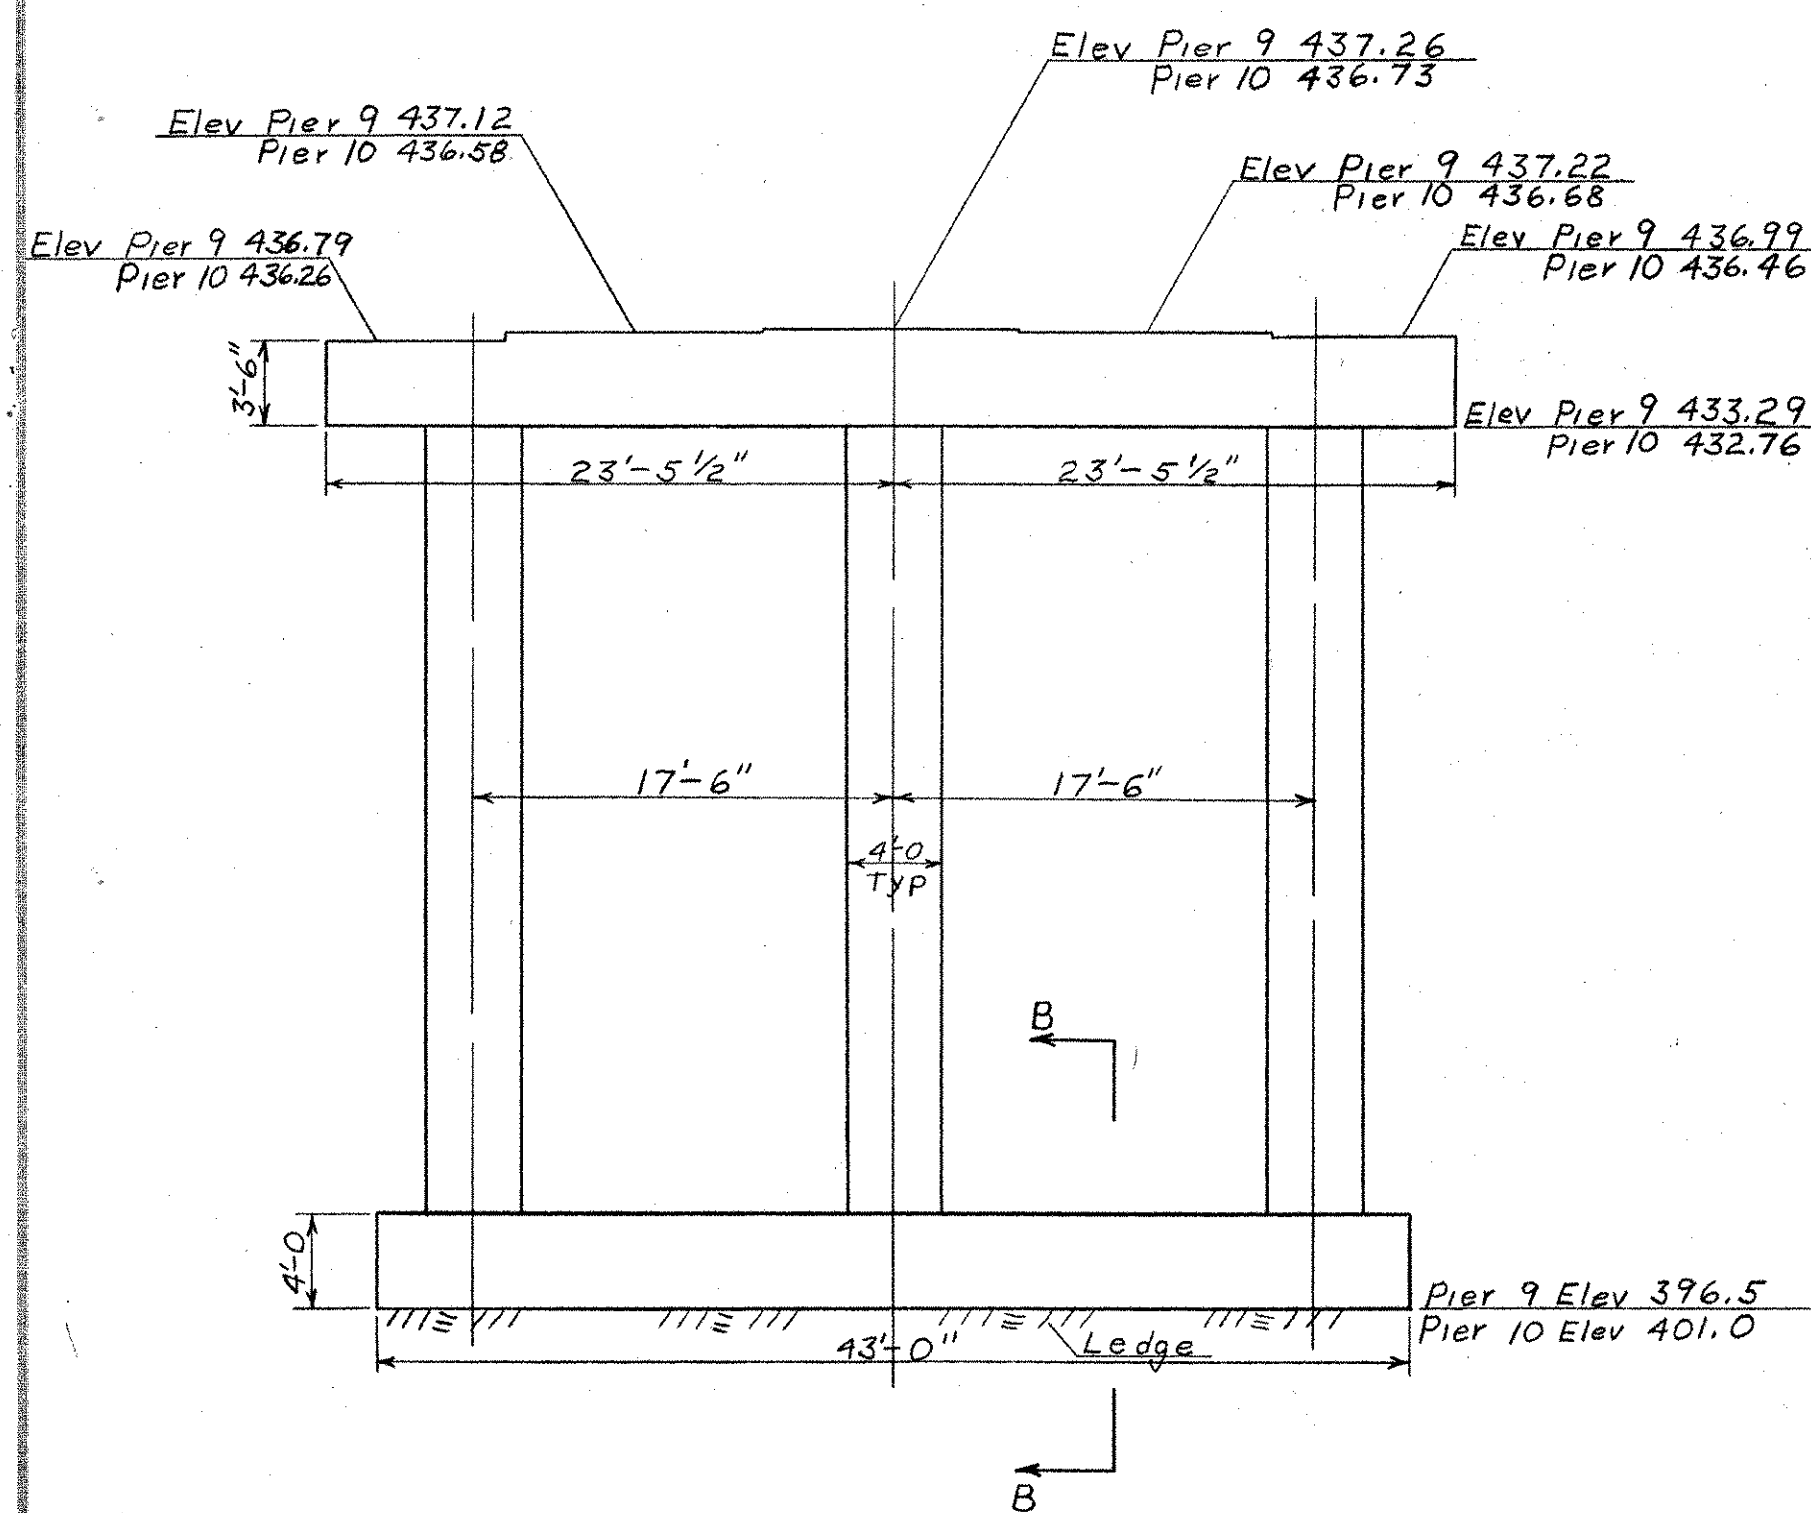


ELEVATION
Scale 1/8 in = 1 ft

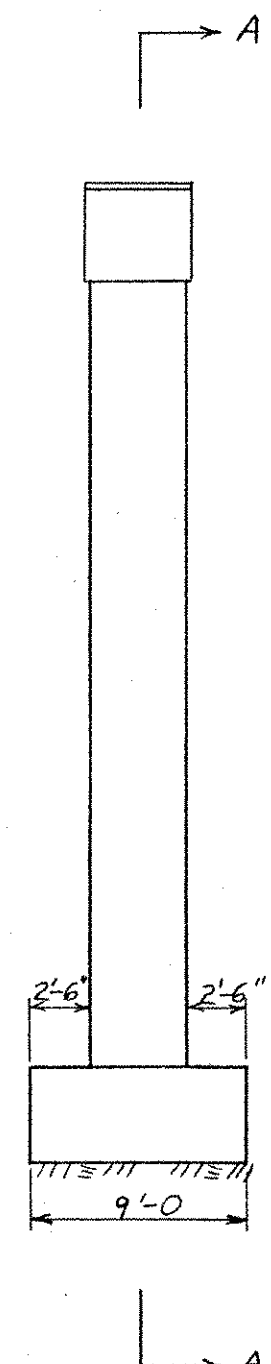


SIDE
Scale 1/8 in = 1 ft

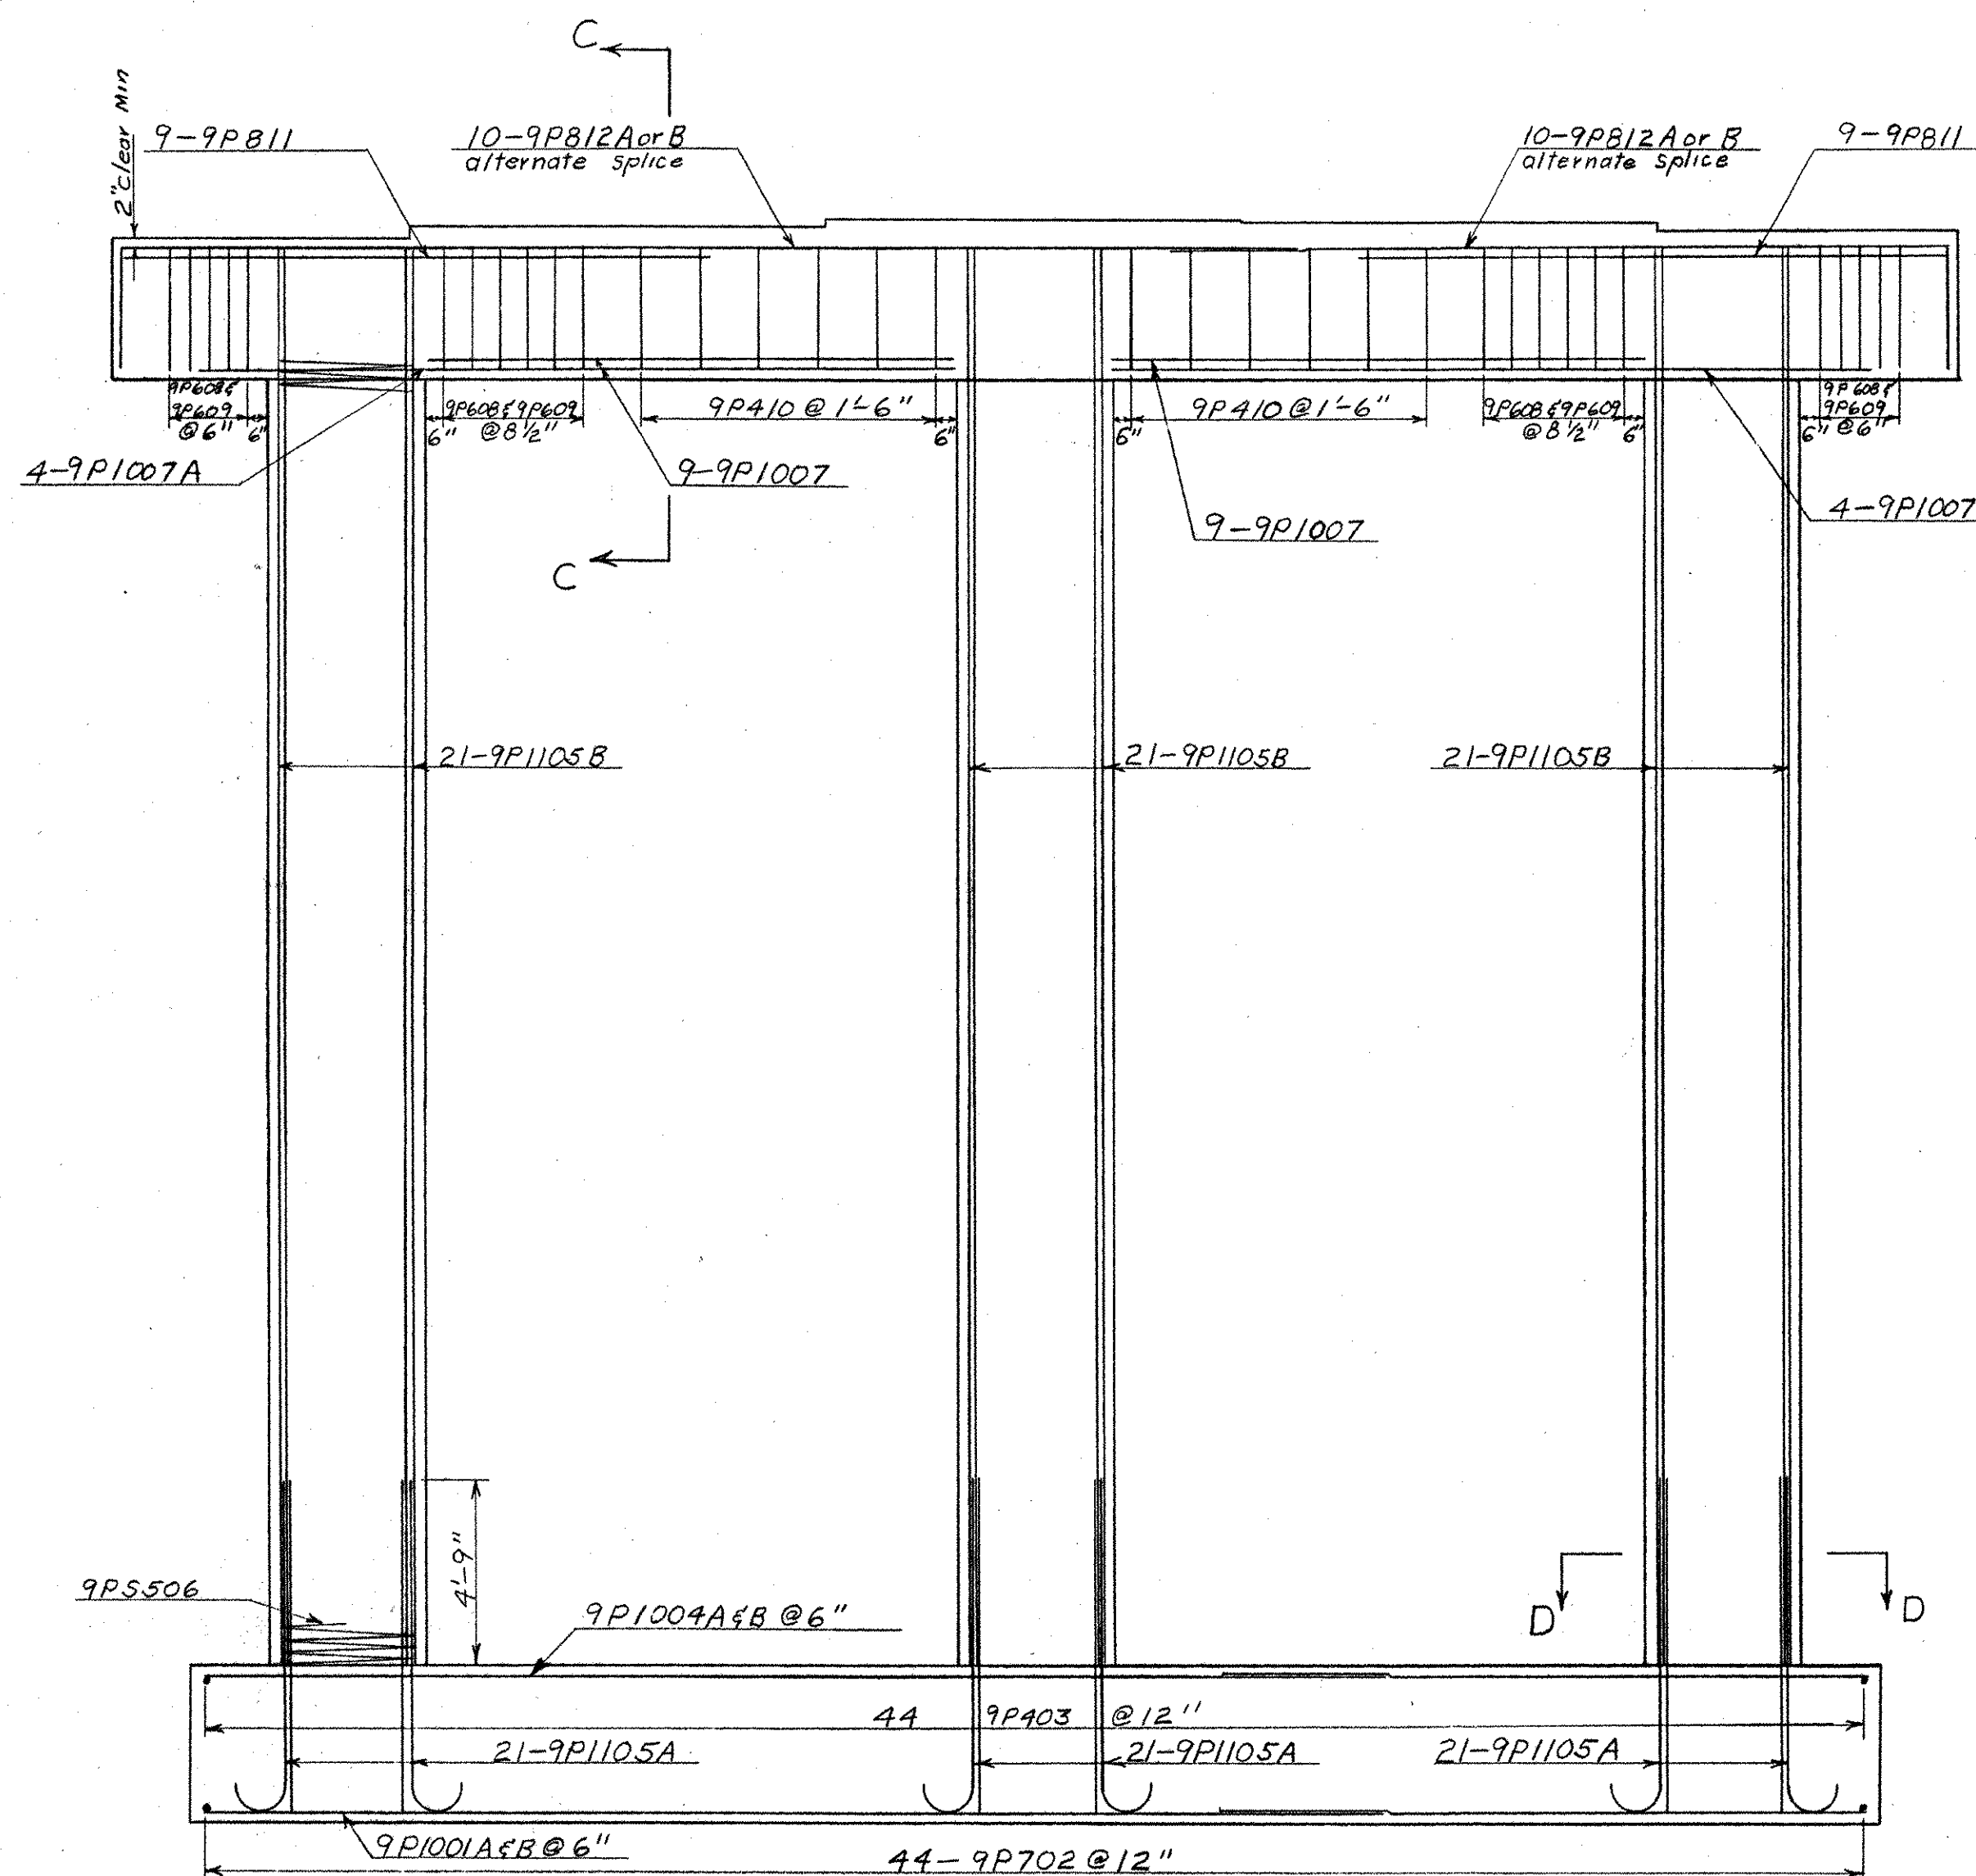


SEC A-A
Scale 1/4 in = 1 ft

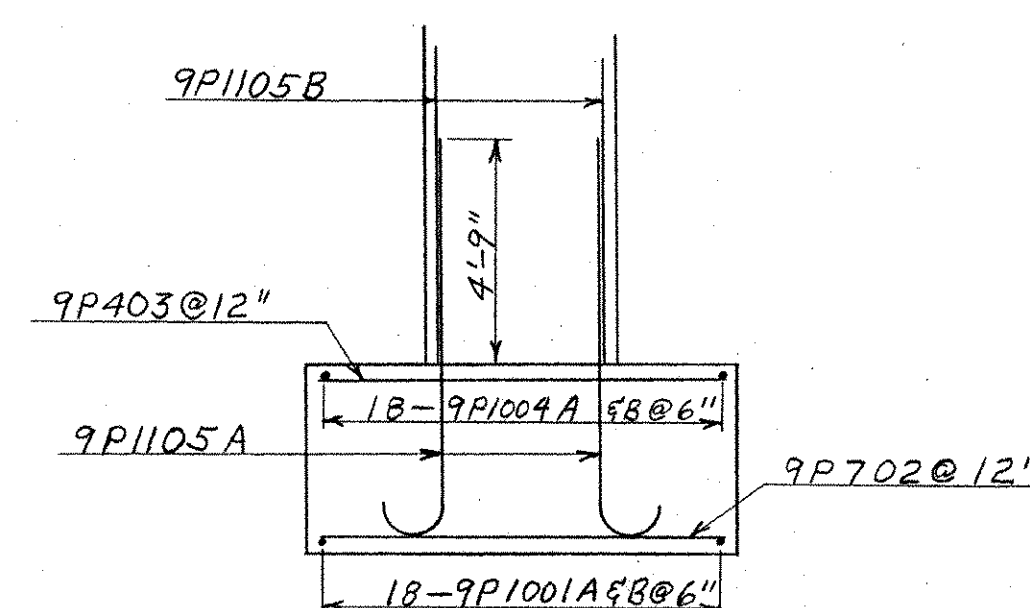

SEC B-B
Scale 1/4 in = 1 ft

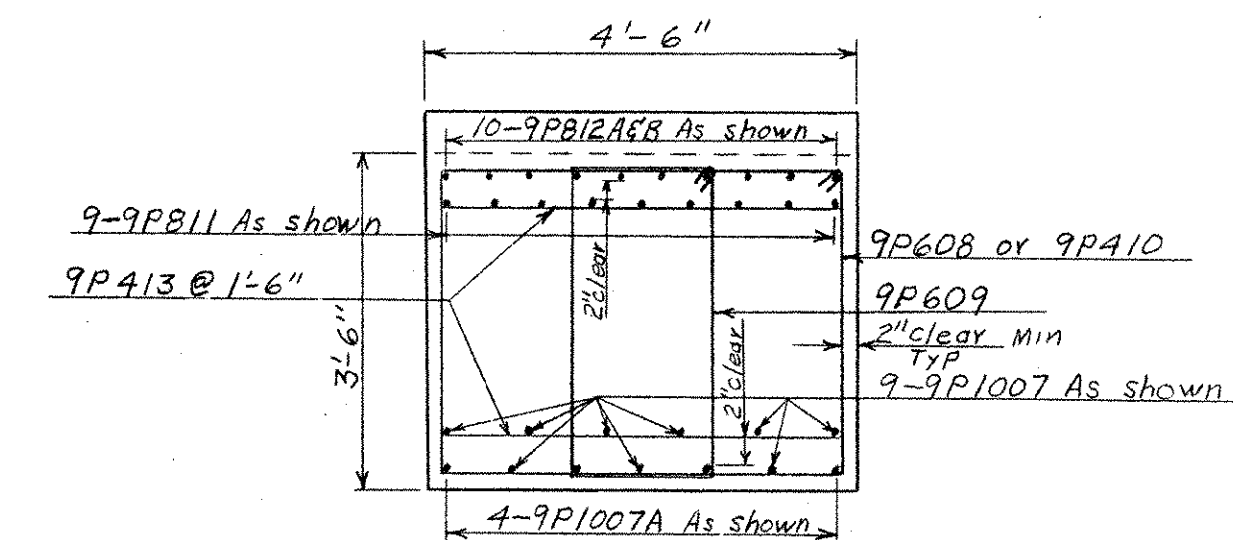

SEC C-C
Scale 1/2 in = 1 ft

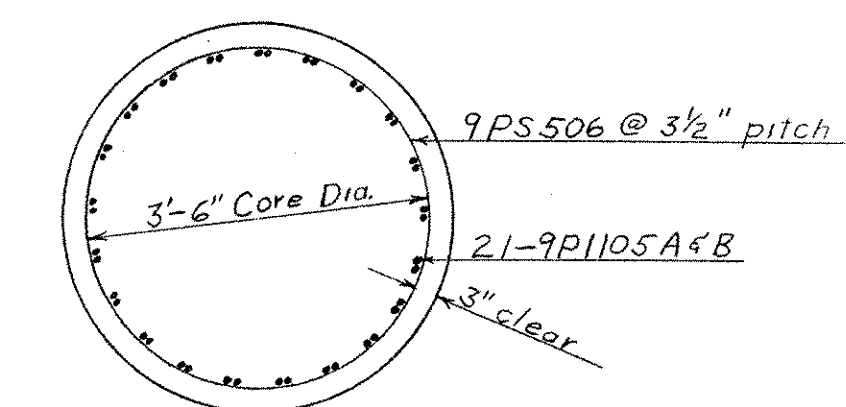

SEC D-D
Scale 1/2 in = 1 ft

NOTES:
1. For Pier notes see Br Sh 118 of 128
2. Pier 10 reinforcing steel similar to Pier 9 except mark is 10P in lieu of 9P.

IR 089-1(13)
This sheet for information only
BR 11 N & S

BR 121 OF 128

STATE OF VERMONT
DEPARTMENT OF HIGHWAYS

TOWN OF HARTFORD
ROUTE No. I-89 LOG STA. 369
I 89 OVER WHITE RIVER, VT #14, CVRR
PIER NO. 9 & 10

SCALE As Shown
SURVEYED BY _____
DRAWN BY AGC CHECKED BY RLO
PROJECT No. I 89-1(6)
SHEET 29 OF 59 SHEET 71 OF 101