


FEDERAL
 SURVEY
 NOTES AND
 TAPES
 TO
 BE
 USED
 IN
 THE
 FIELD

FEDERAL
 SURVEY
 NOTES AND
 TAPES
 TO
 BE
 USED
 IN
 THE
 FIELD

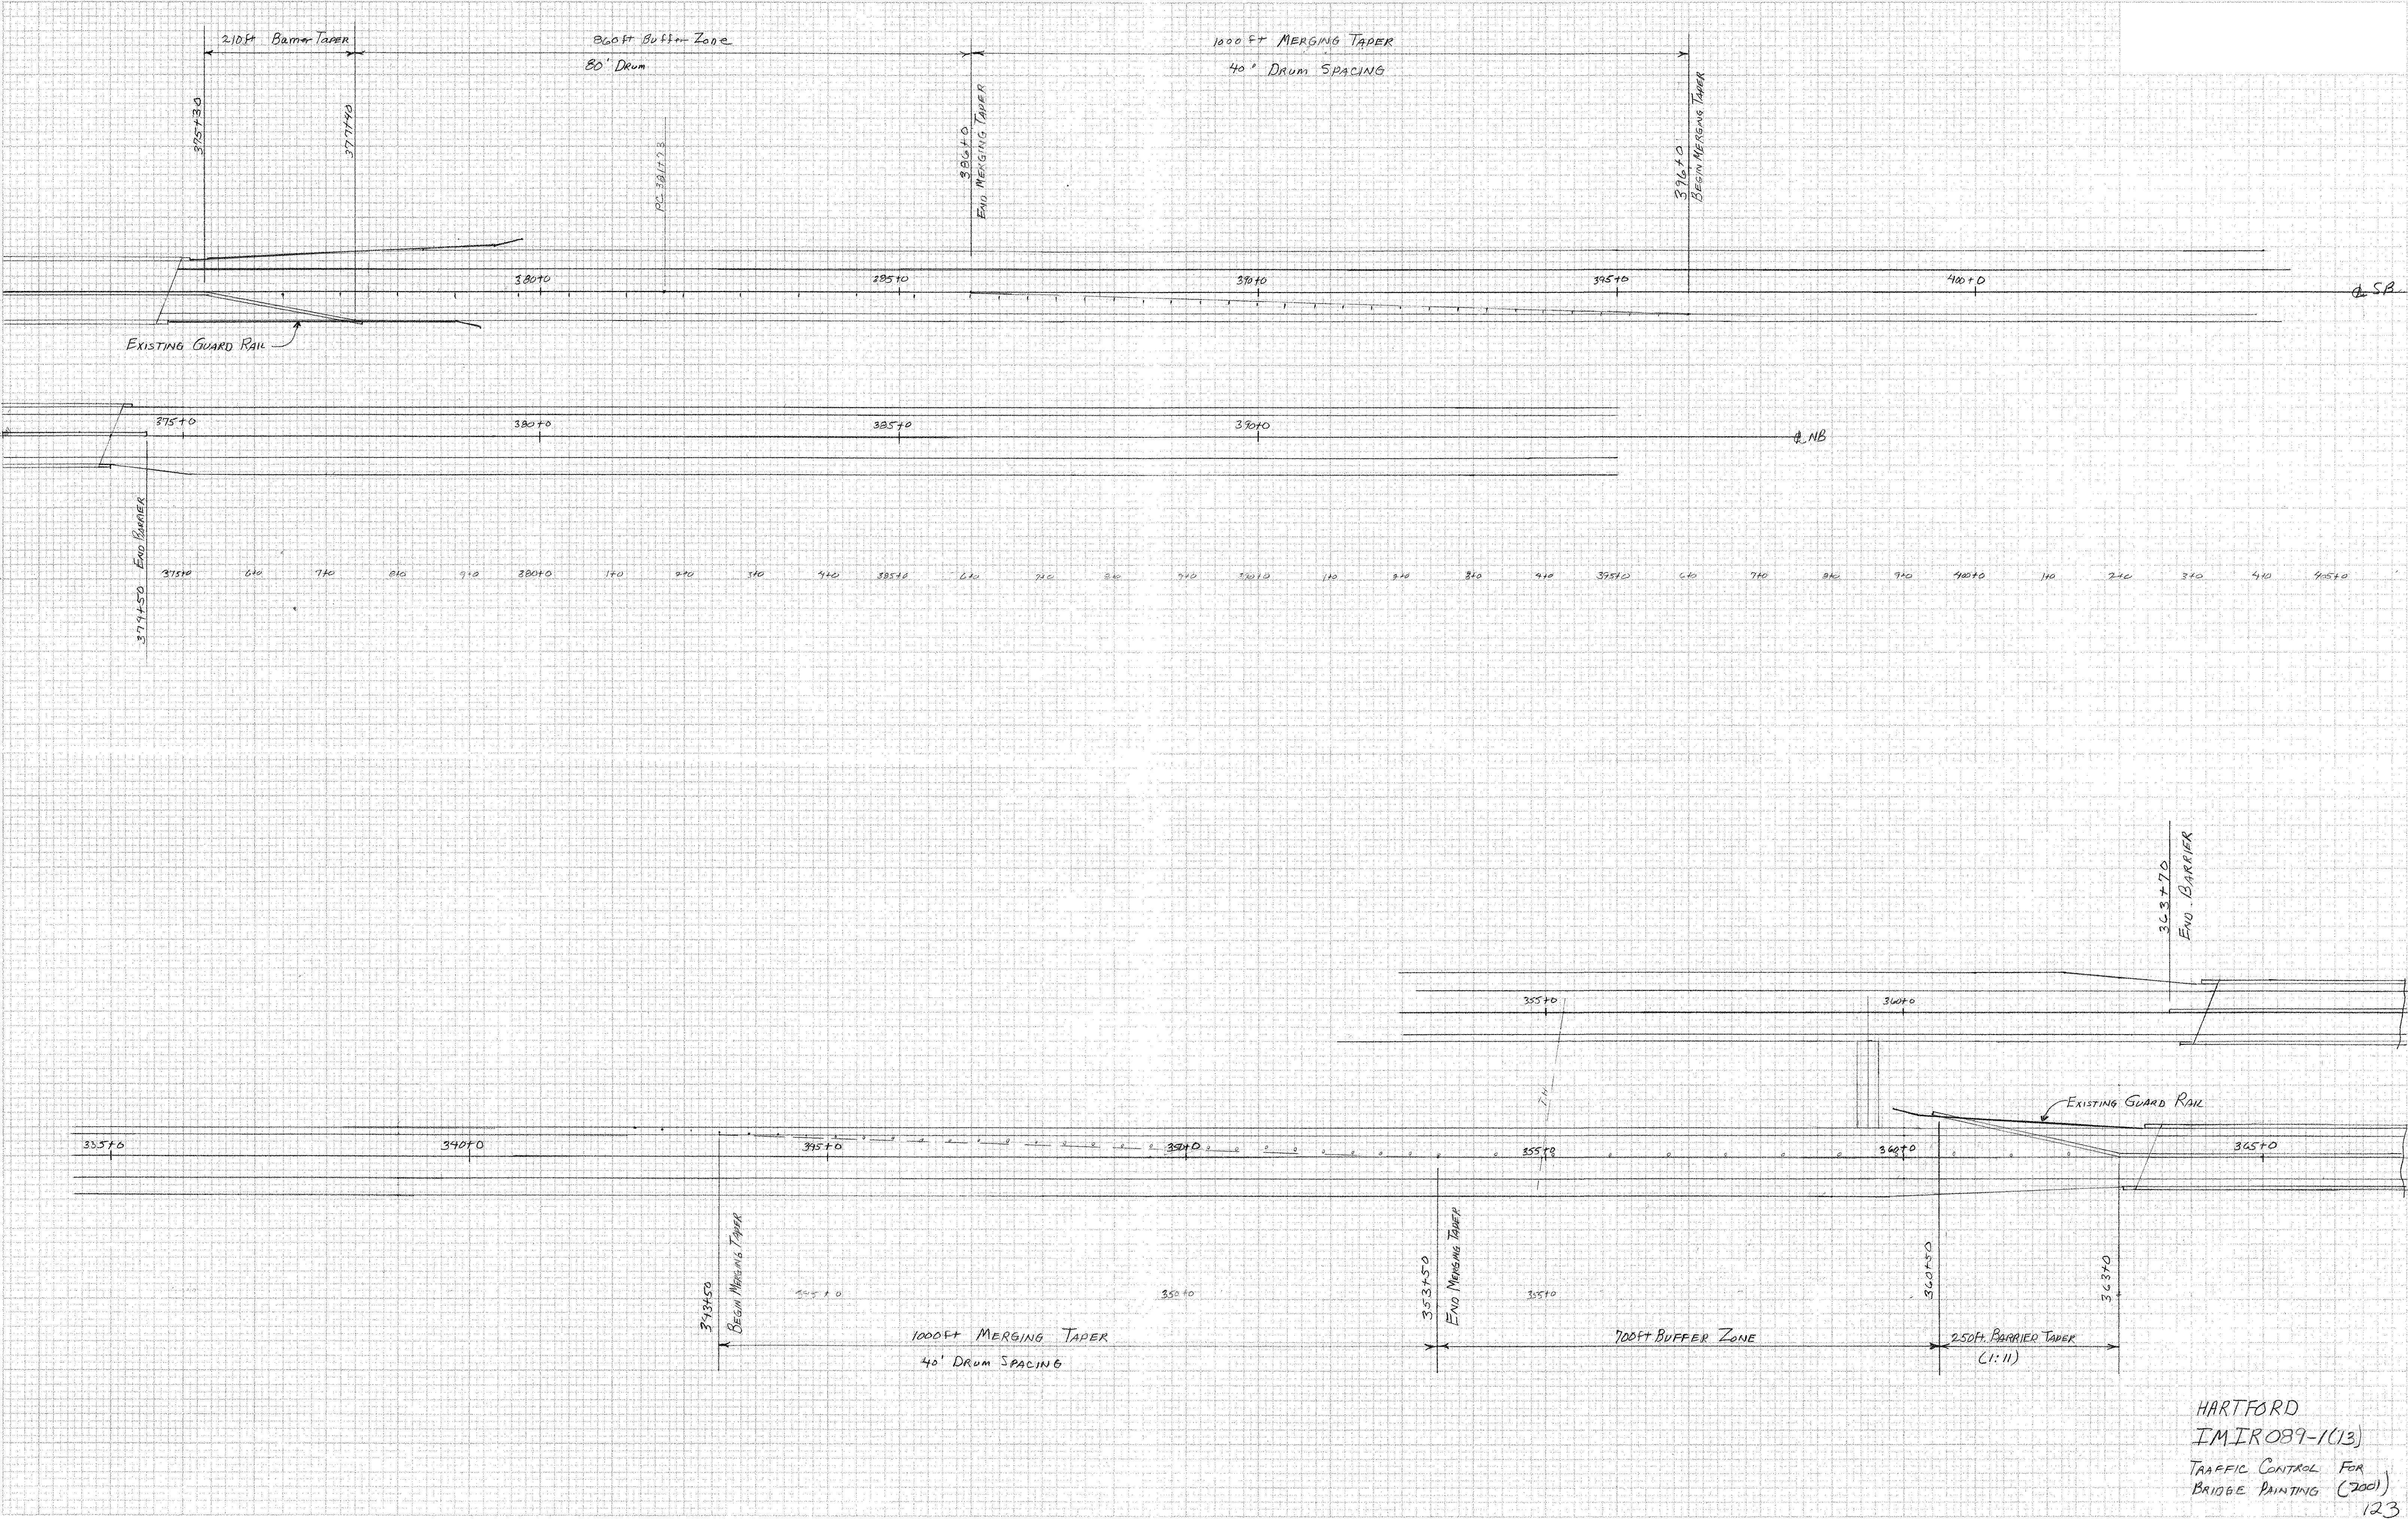

HARTFORD
 IMIRO89-1(13)
 TRAFFIC CONTROL FOR
 BRIDGE PAINTING (700)
 123