


TYPICAL SECTION


1.5" TYPE IVS - WEARING COURSE
 2.5" TYPE IIS - INTERMEDIATE COURSE
 2.5" TYPE IIS - BASE COURSE
 24" SUBBASE OF DENSE GRADED CRUSHED STONE
 24" SAND BORROW

EMULSIFIED ASPHALT TYPE CRS-IH OR RS-IH SHALL BE APPLIED AS A TACK COAT IN BETWEEN ALL BITUMINOUS PAVEMENT COURSES (WHERE APPLICABLE) AT THE RATE OF 0.025 TO 0.040 GAL/SY, AND 0.080 GAL/SY ON MILLED SURFACES OR AS DIRECTED BY THE ENGINEER. PAYMENT WILL BE UNDER ITEM 900.683, "SPECIAL PROVISION (EMULSIFIED ASPHALT) (RS-IH OR CRS-IH)".

*AS PER C.O.D./S.A #1, DATED 04/14/14, THIS PROPOSED WORK WAS REVISED TO REMOVE ALL PAVEMENT AND PAVE THE AREA AT A DEPTH OF 6.5".

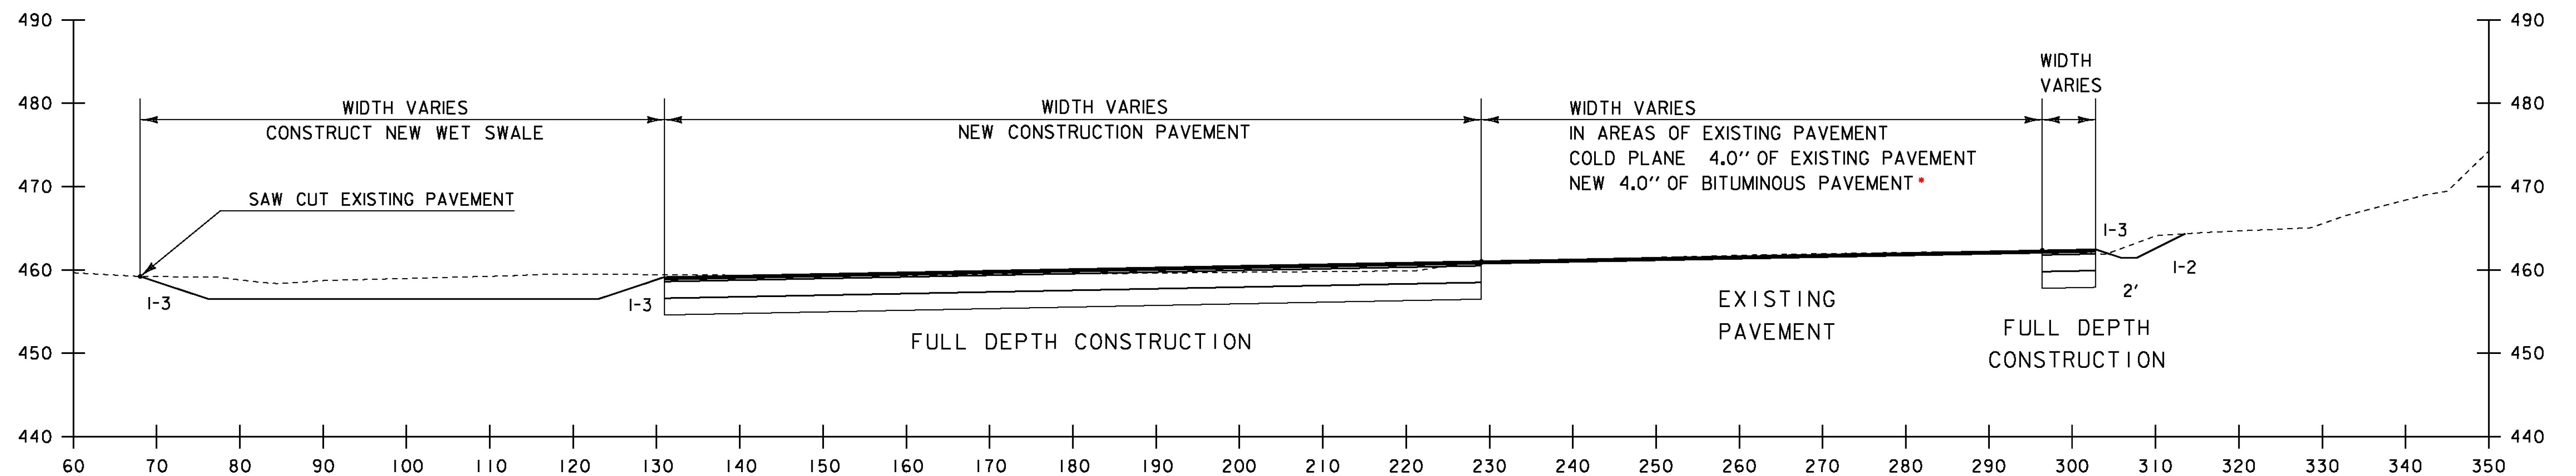

SAMPLE LOCATION (150+80)

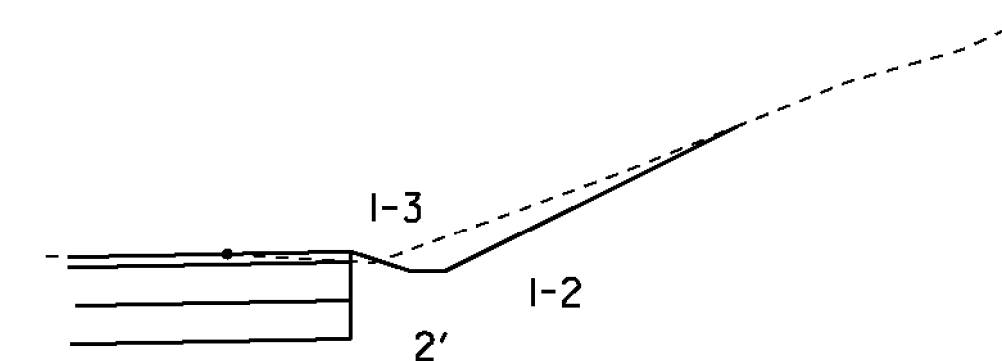

THE DITCH RELATED SLOPES AND WIDTHS ARE PERPENDICULAR TO THE OUTSIDE ALIGNMENT (INSPECTION AREA)

STATIONING, OFFSET, AND ELEVATIONS IN FEET

PROJECT NAME:	GUILFORD	PLOT DATE:	22-JUL-2013
PROJECT NUMBER:	IM-IR 091-(125)	DRAWN BY:	BEYOR
FILE NAME:	D9IA222_CLOCK_FORMS.DGN	CHECKED BY:	BOMBARDIER
PROJECT LEADER:	LIBBY	SHEET	3 OF 46
DESIGNED BY:	BEYOR		
TYPICAL SECTIONS SHEET			