

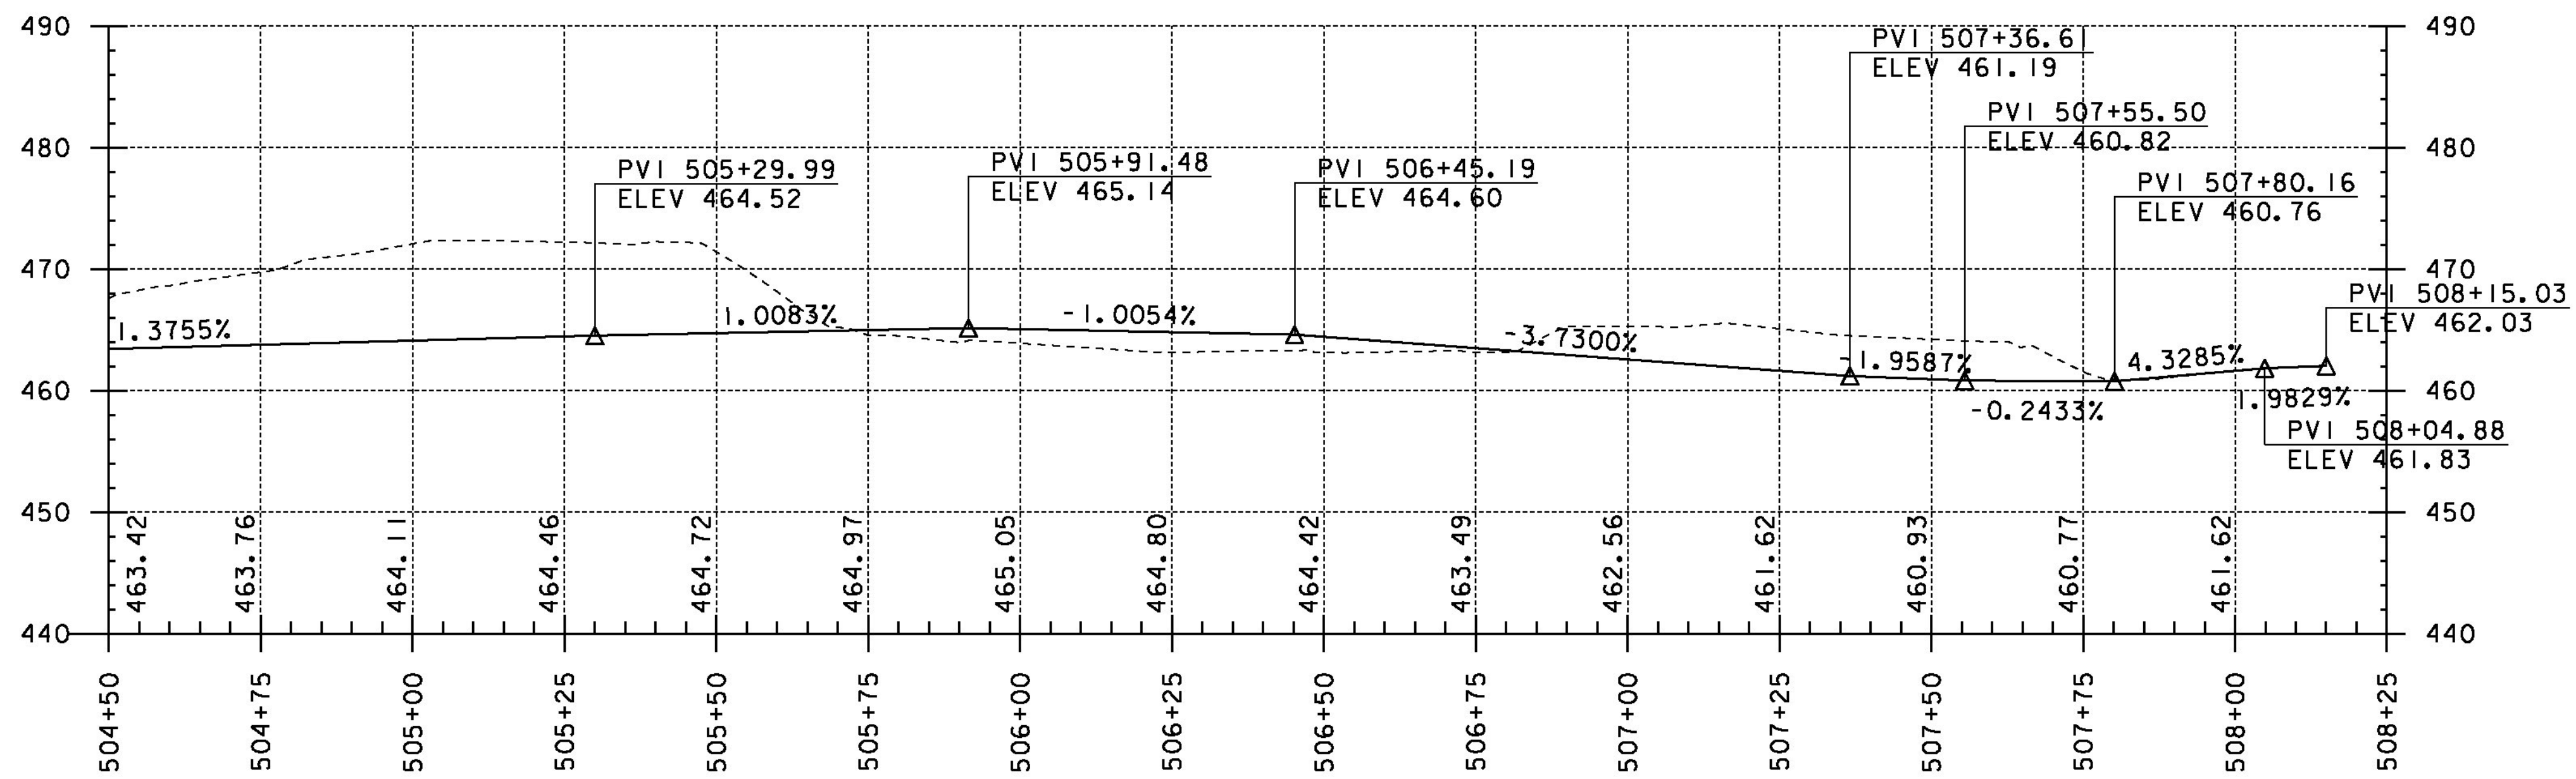


ALIGNMENT PROFILE - OUTSIDE (INSPECTION AREA)

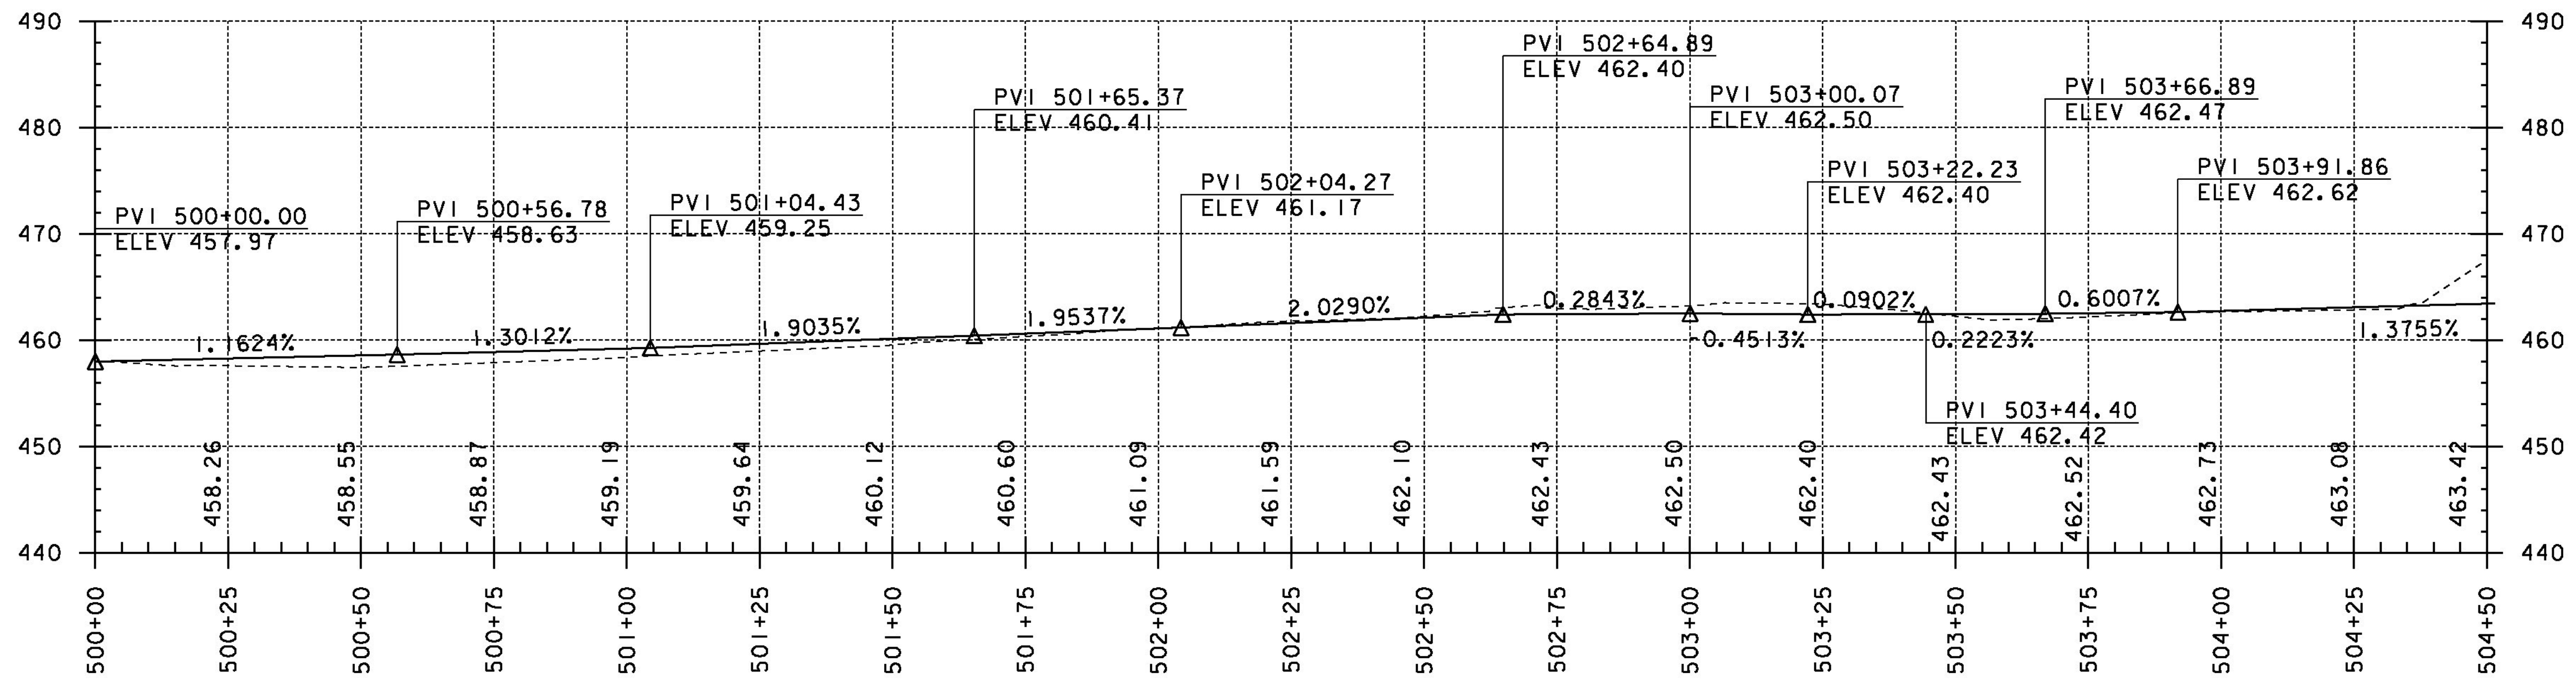

NOTE: THE GRADES SHOWN TO THE NEAREST HUNDREDTH ARE THE FINISHED GRADES ALONG THE PROPOSED ALIGNMENT.

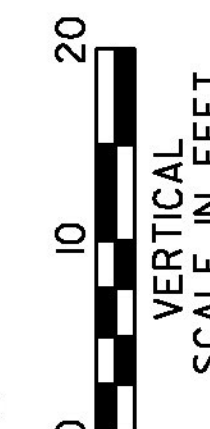

PROJECT NAME: GUILFORD
PROJECT NUMBER: IM-IR 091-1(25)

FILE NAME: D91A222_CLOCK.DGN
PROJECT LEADER: LIBBY
DESIGNED BY: BEYOR
PROFILE SHEET 1

PLOT DATE: 30-AUG-2013
DRAWN BY: BEYOR
CHECKED BY: BOMBARDIER
SHEET 9 OF 46