


SOILS CLASSIFICATION
 LIMERICK SILT LOAM
 K FACTOR = 0.49

SOILS CLASSIFICATION
 MACOMBER-TACONIC COMPLEX,
 8 TO 15 PERCENT SLOPES,
 VERY ROCKY
 K FACTOR = 0.32/0.37

SOILS CLASSIFICATION
 MACOMBER-TACONIC COMPLEX,
 15 TO 25 PERCENT SLOPES,
 VERY ROCKY
 K FACTOR = 0.32/0.37

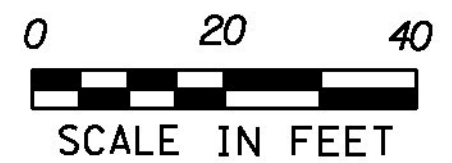

PROJECT NAME: GUILFORD	PLOT DATE: 22-JUL-2013
PROJECT NUMBER: IM-IR 091-I(25)	DRAWN BY: BEYOR
FILE NAME: D9IA222_CLOCK.DGN	CHECKED BY: BOMBARDIER
PROJECT LEADER: LIBBY	SHEET 22 OF 46
DESIGNED BY: BEYOR	
EPSC - EXISTING CONDITIONS	