



149+40

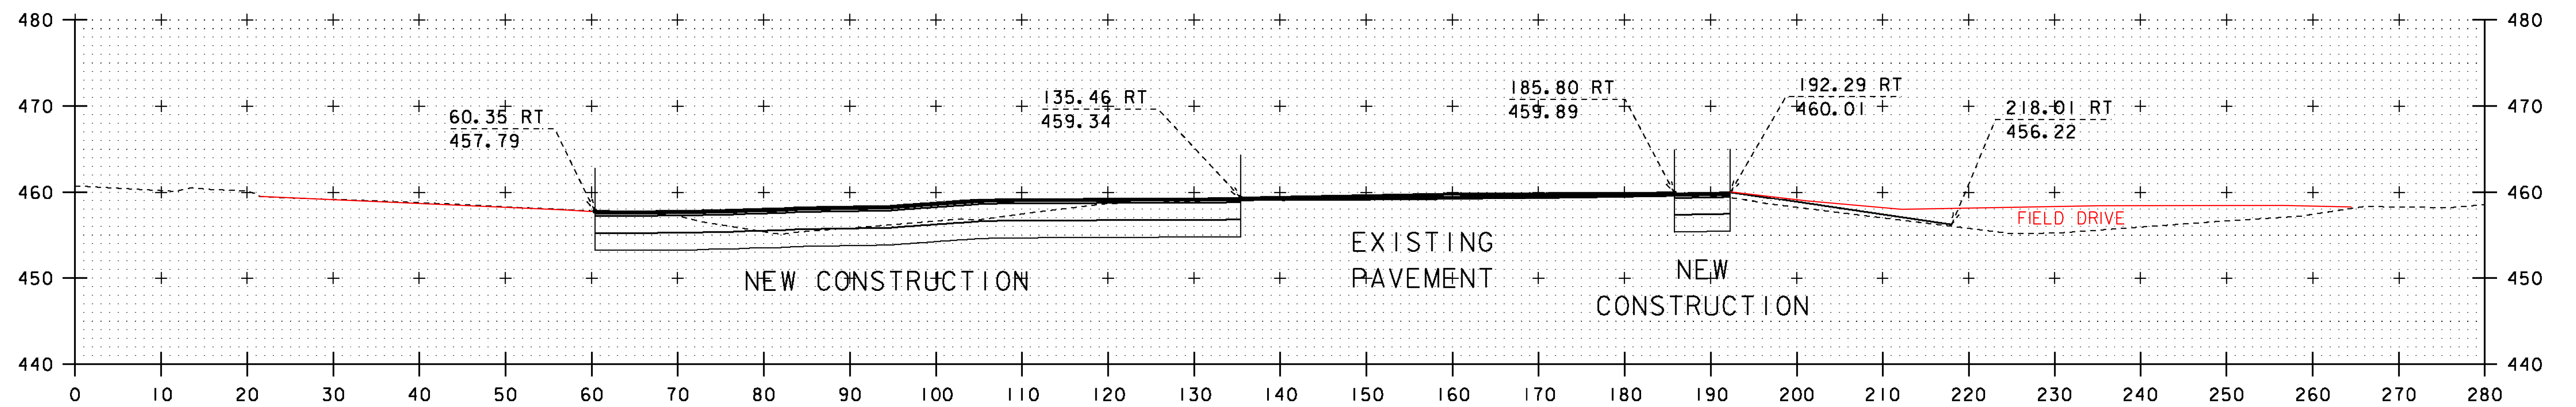

149+20

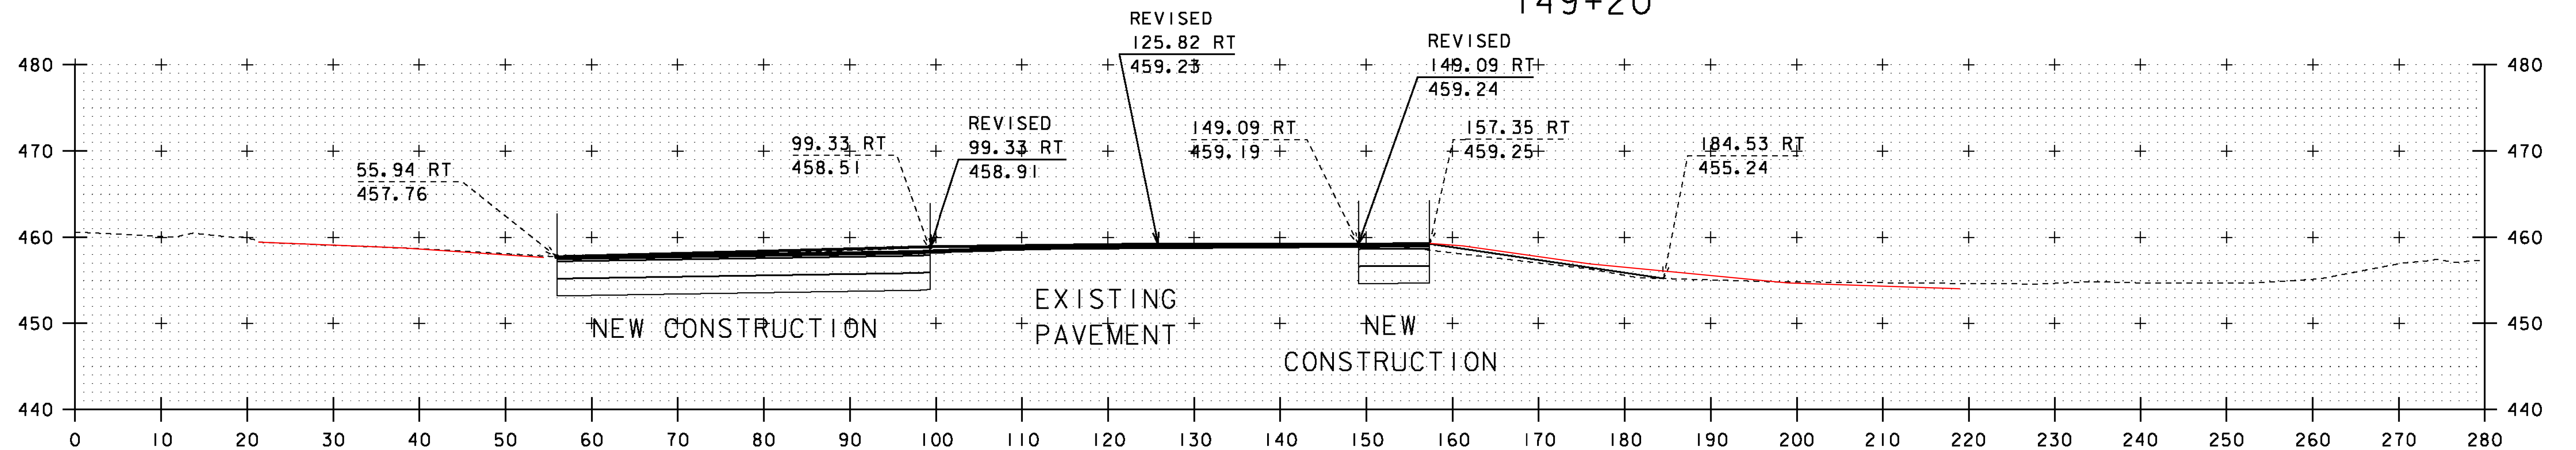

149+00

STA. 149+00 - STA. 149+40

PROJECT NAME:	GUILFORD	PLOT DATE:	05-MAY-2014
PROJECT NUMBER:	IM-IR 091-(25)	DRAWN BY:	BEYOR
FILE NAME:	D91A222_CLOCK_BDR.DGN	CHECKED BY:	BOMBARDIER
PROJECT LEADER:	LIBBY	CROSS SECTION SHEET #2	SHEET 29 OF 46
DESIGNED BY:	BEYOR		