



150+00

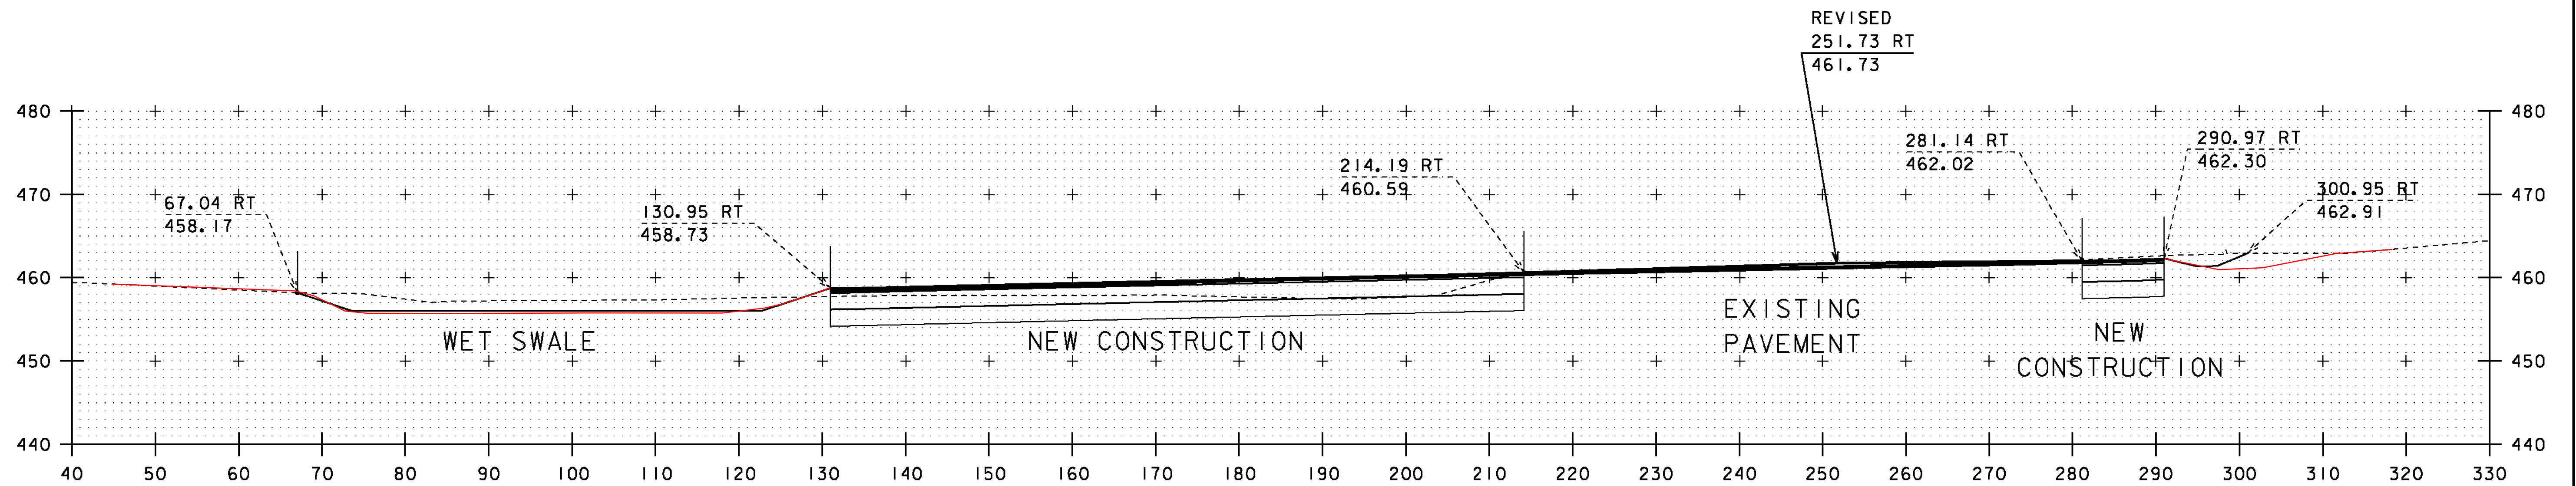

149+80

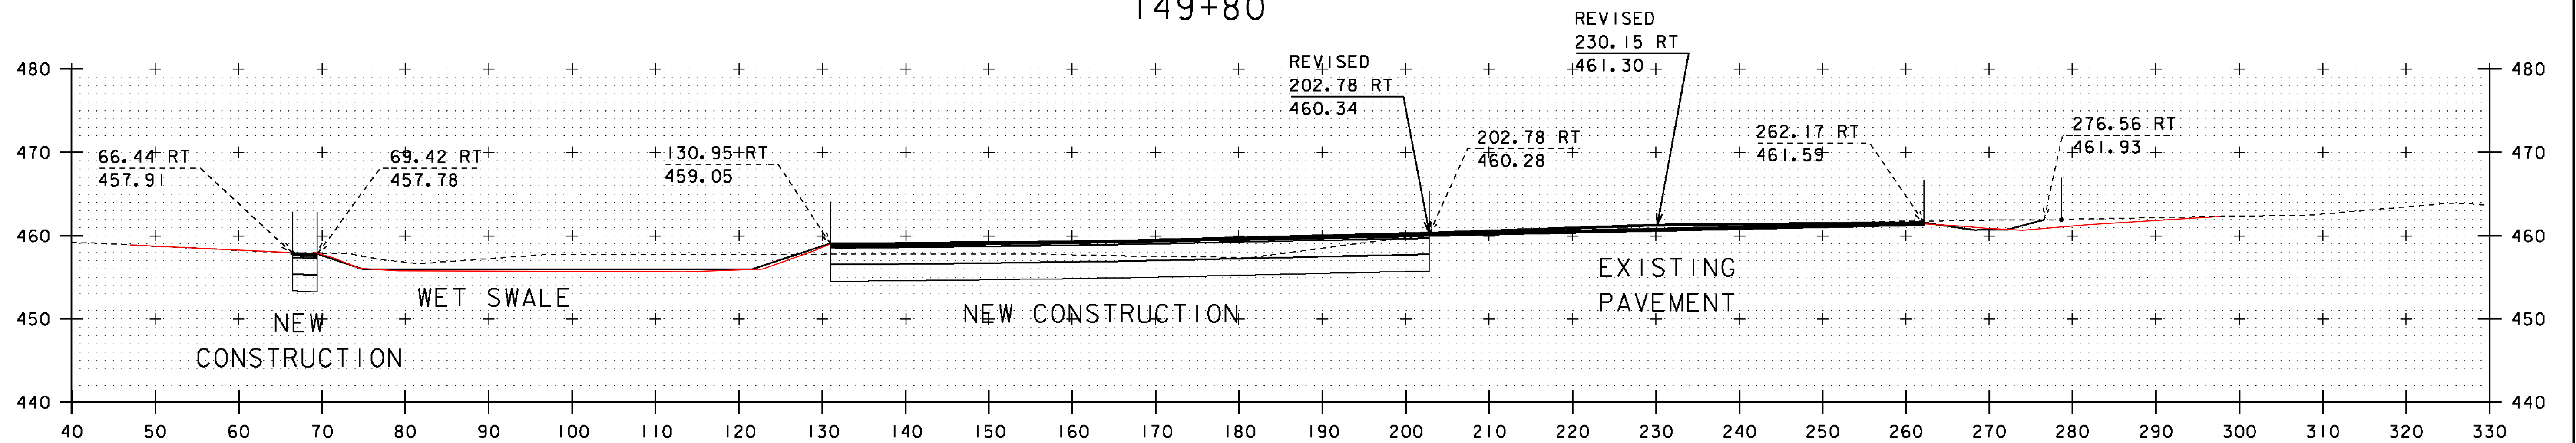

149+60

STA. 149+60 - STA. 150+00

PROJECT NAME:	GUILFORD	PLOT DATE:	05-MAY-2014
PROJECT NUMBER:	IM-IR 091-I(25)	DRAWN BY:	BEYOR
FILE NAME:	D9IA222_CLOCK_BDR.DGN	CHECKED BY:	BOMBARDIER
PROJECT LEADER:	LIBBY	SHEET	30 OF 46
DESIGNED BY:	BEYOR	CROSS SECTION SHEET	#3