



151+20

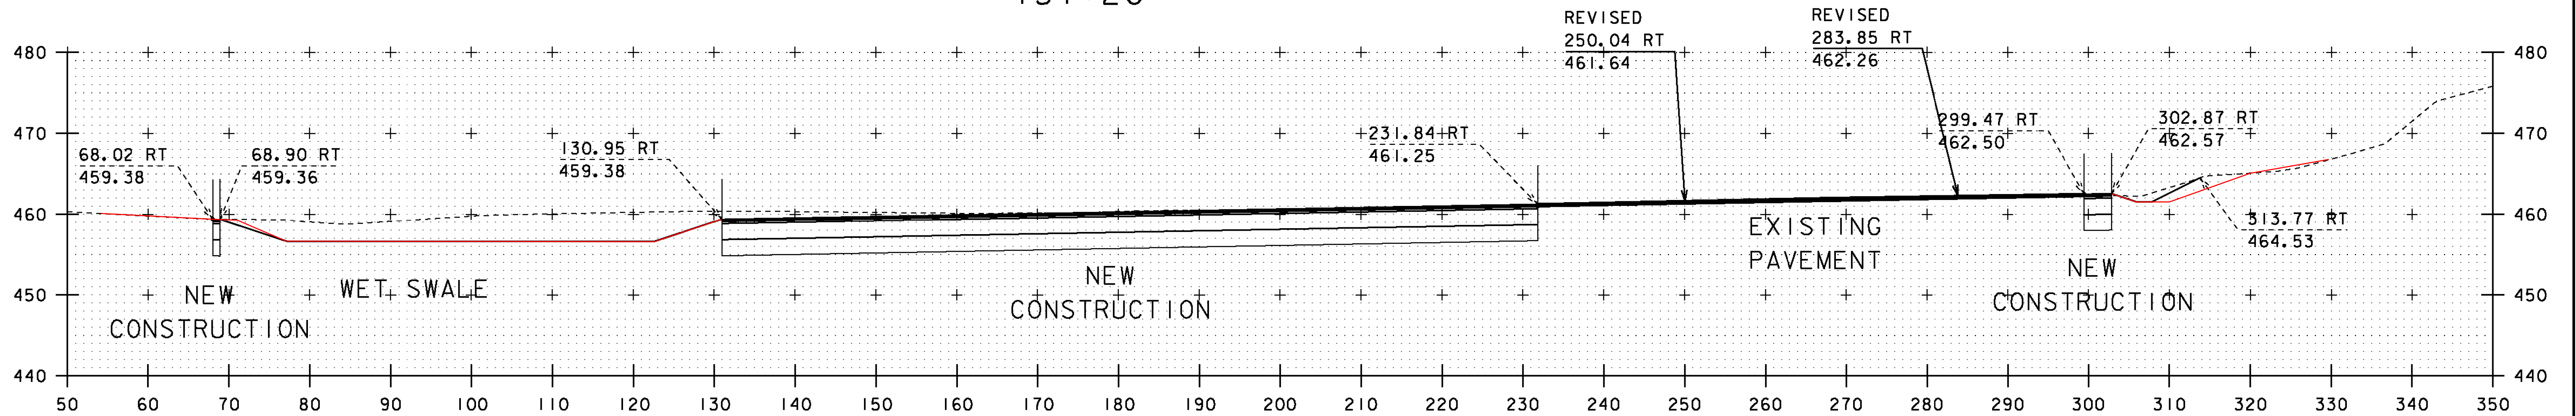

151+00

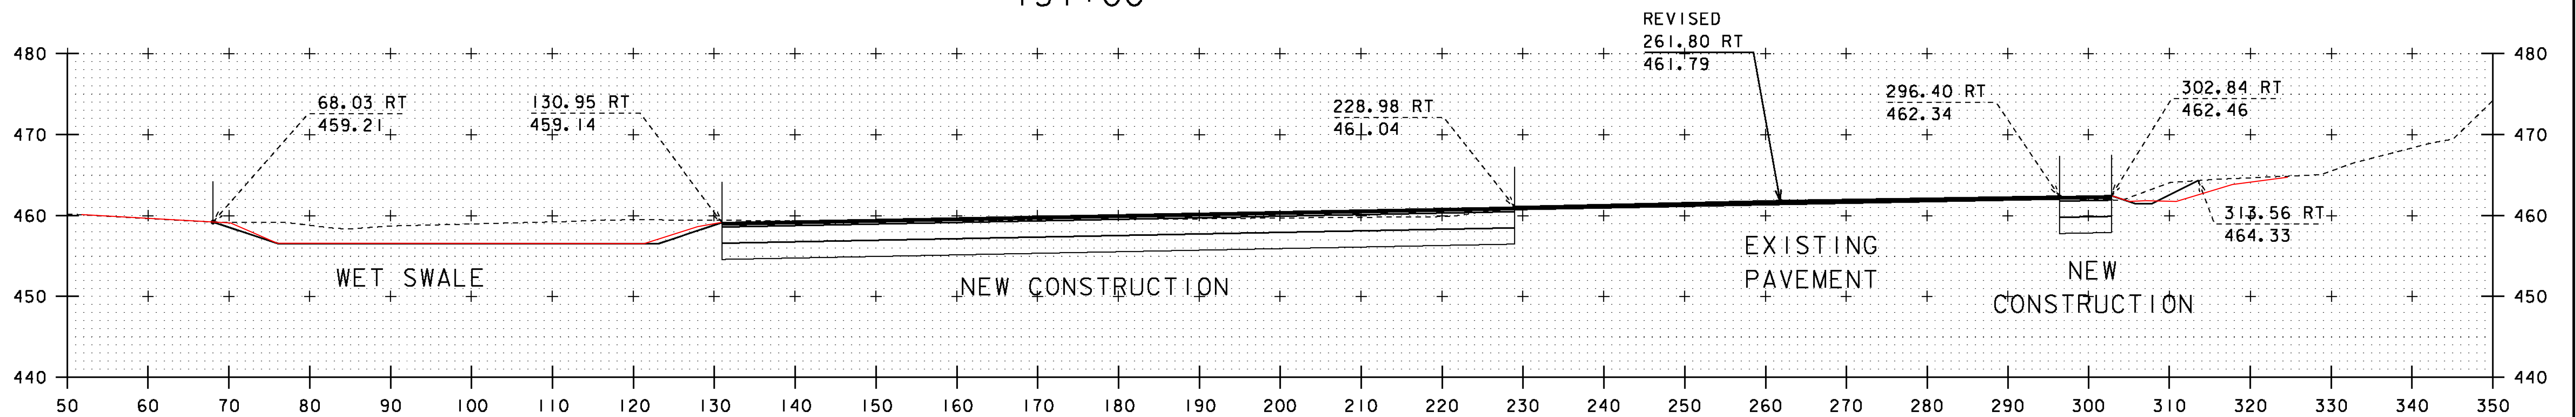

150+80

PROJECT NAME:	GUILFORD	PLOT DATE:	05-MAY-2014
PROJECT NUMBER:	IM-IR 091-(25)	DRAWN BY:	BEYOR
FILE NAME:	D91A222_CLOCK_BDR.DGN	CHECKED BY:	BOMBARDIER
PROJECT LEADER:	LIBBY	SHEET	32 OF 46
DESIGNED BY:	BEYOR		
CROSS SECTION SHEET	#5		

STA. 150+80 - STA. 151+20