



152+40

6" UNDERDRAIN T'S AT STA 152+30
 ELEV = 358.75'
 OFF 310' RT.

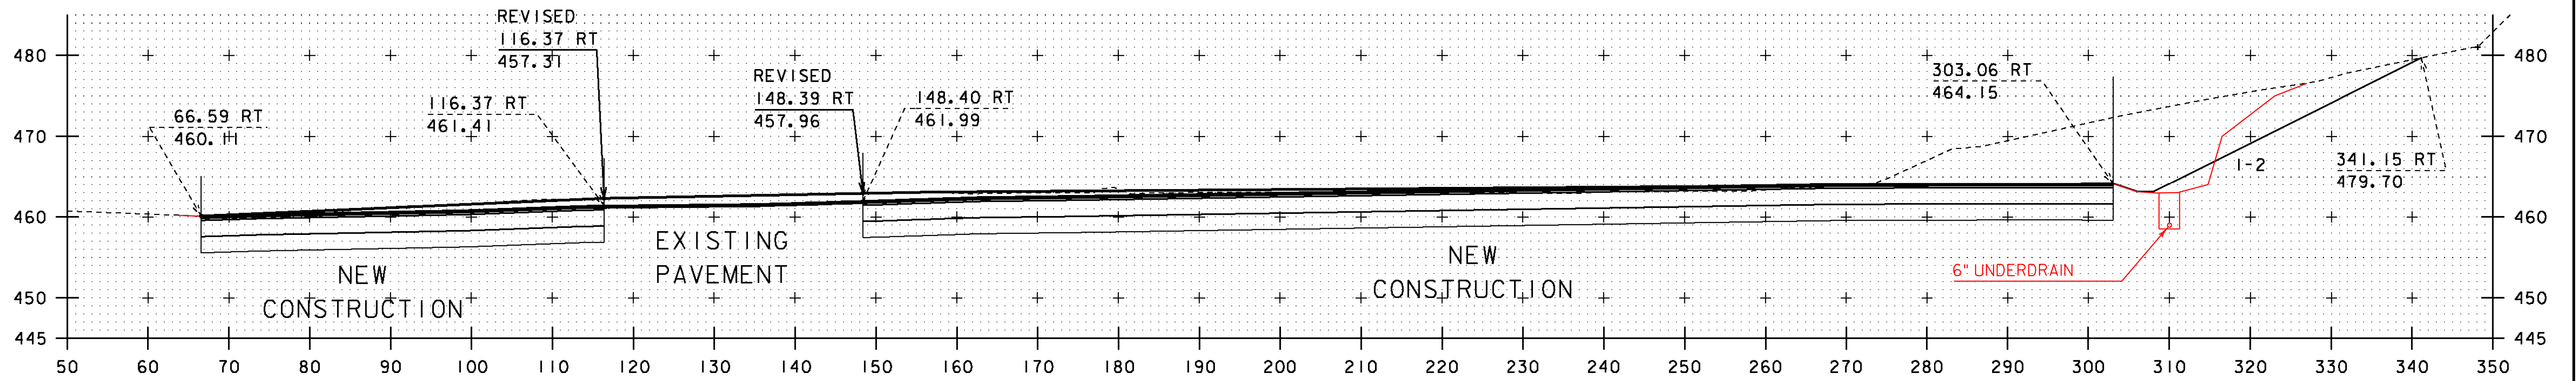

152+20

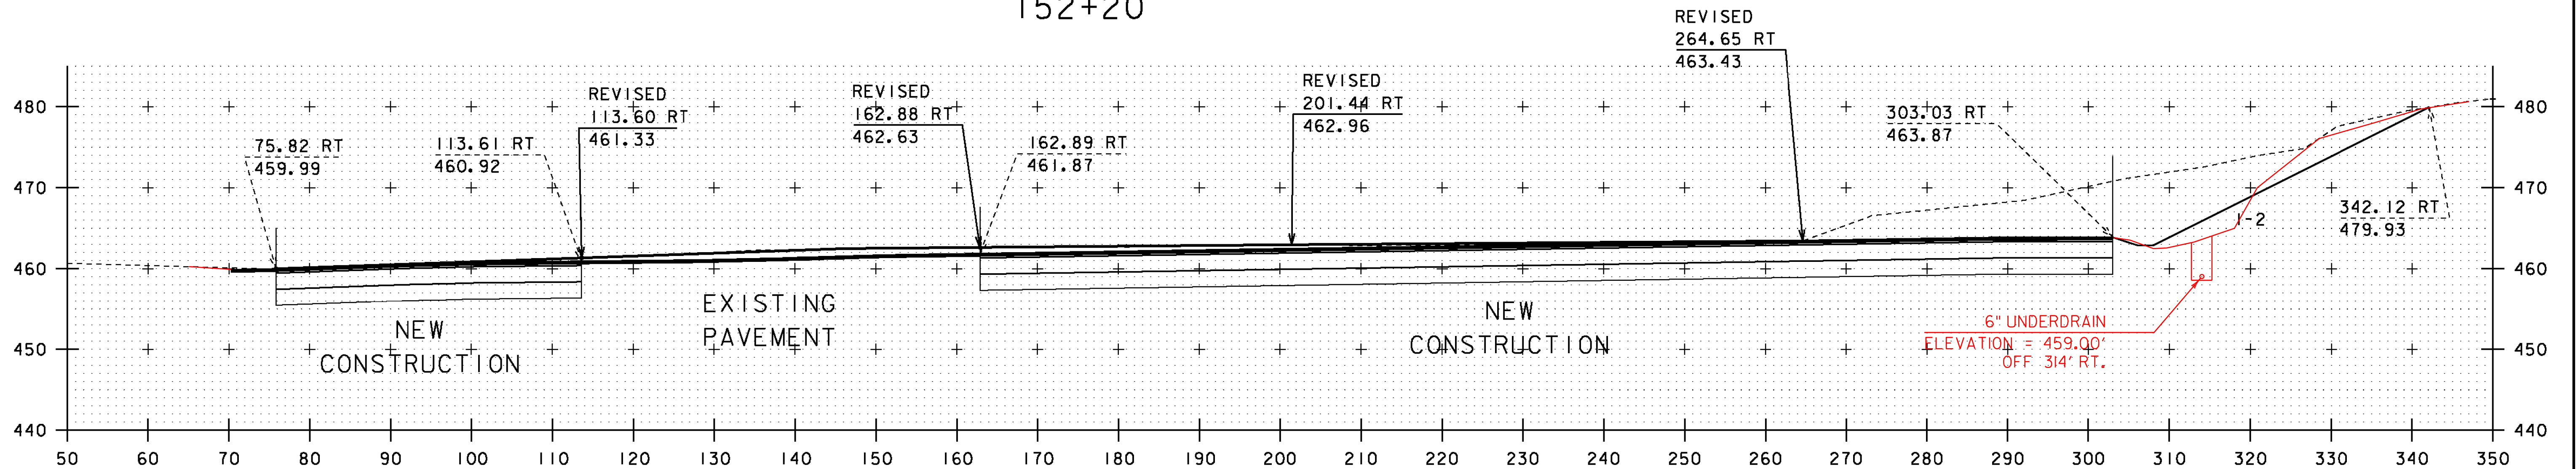

152+00

PROJECT NAME:	GUILFORD	PLOT DATE:	05-MAY-2014
PROJECT NUMBER:	IM-IR 091-(25)	DRAWN BY:	BEYOR
FILE NAME:	D91A222_CLOCK_BDR.DGN	CHECKED BY:	BOMBARDIER
PROJECT LEADER:	LIBBY	SHEET	34 OF 46
DESIGNED BY:	BEYOR		
CROSS SECTION SHEET	#7		

STA. 152+00 - STA. 152+40