



153+00

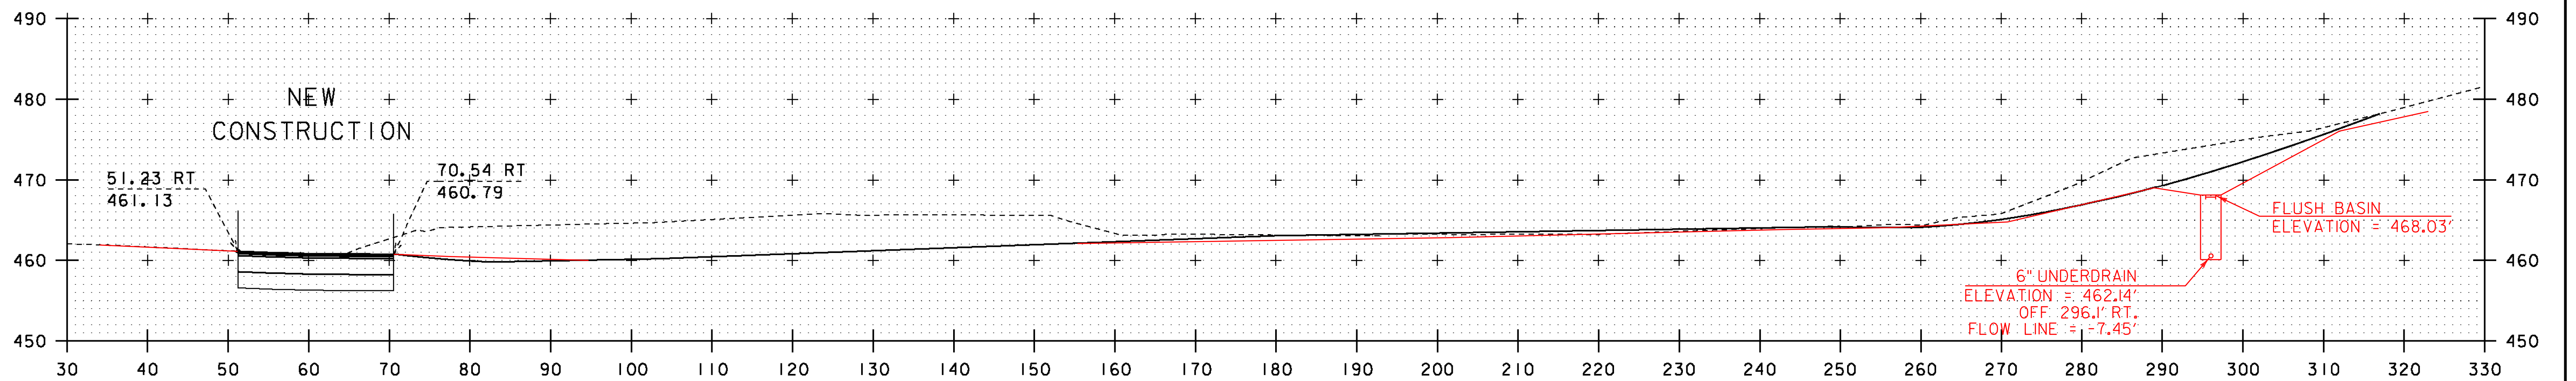

152+74.5
~~152+80~~

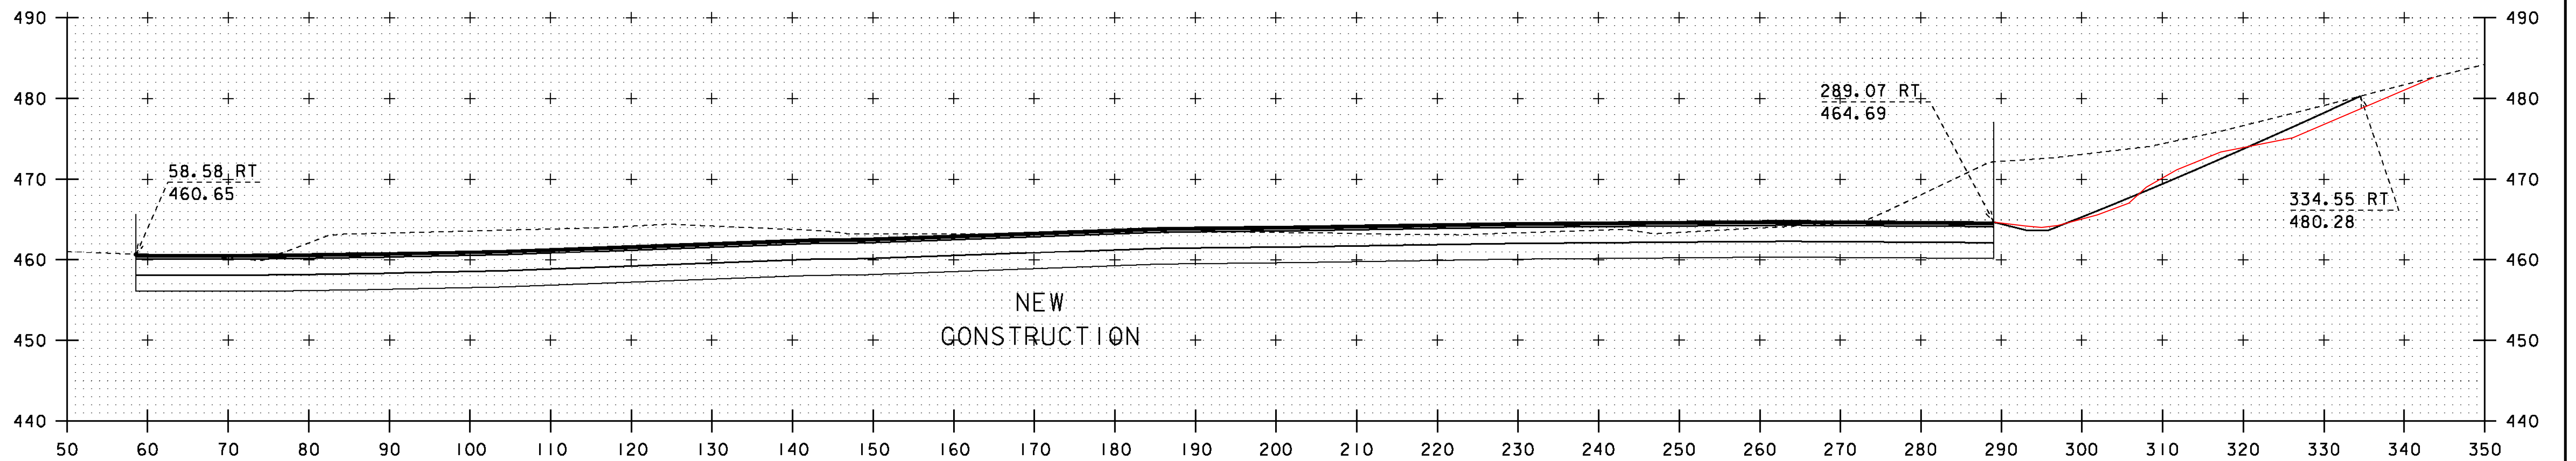

152+60

STA. 152+60 - STA. 153+00

PROJECT NAME:	GUILFORD	PLOT DATE:	05-MAY-2014
PROJECT NUMBER:	IM-IR 091-(25)	DRAWN BY:	BEYOR
FILE NAME:	D9IA222_CLOCK_BDR.DGN	CHECKED BY:	BOMBARDIER
PROJECT LEADER:	LIBBY	SHEET	35 OF 46
DESIGNED BY:	BEYOR	CROSS SECTION SHEET	#8