



D-5

STA 152+84.82 (78.42' RT) - STA 152+32.21 (67.25' RT)  
 NEW 24" X 54" CPEP PERIMETER DITCH - OUTLET CULVERT

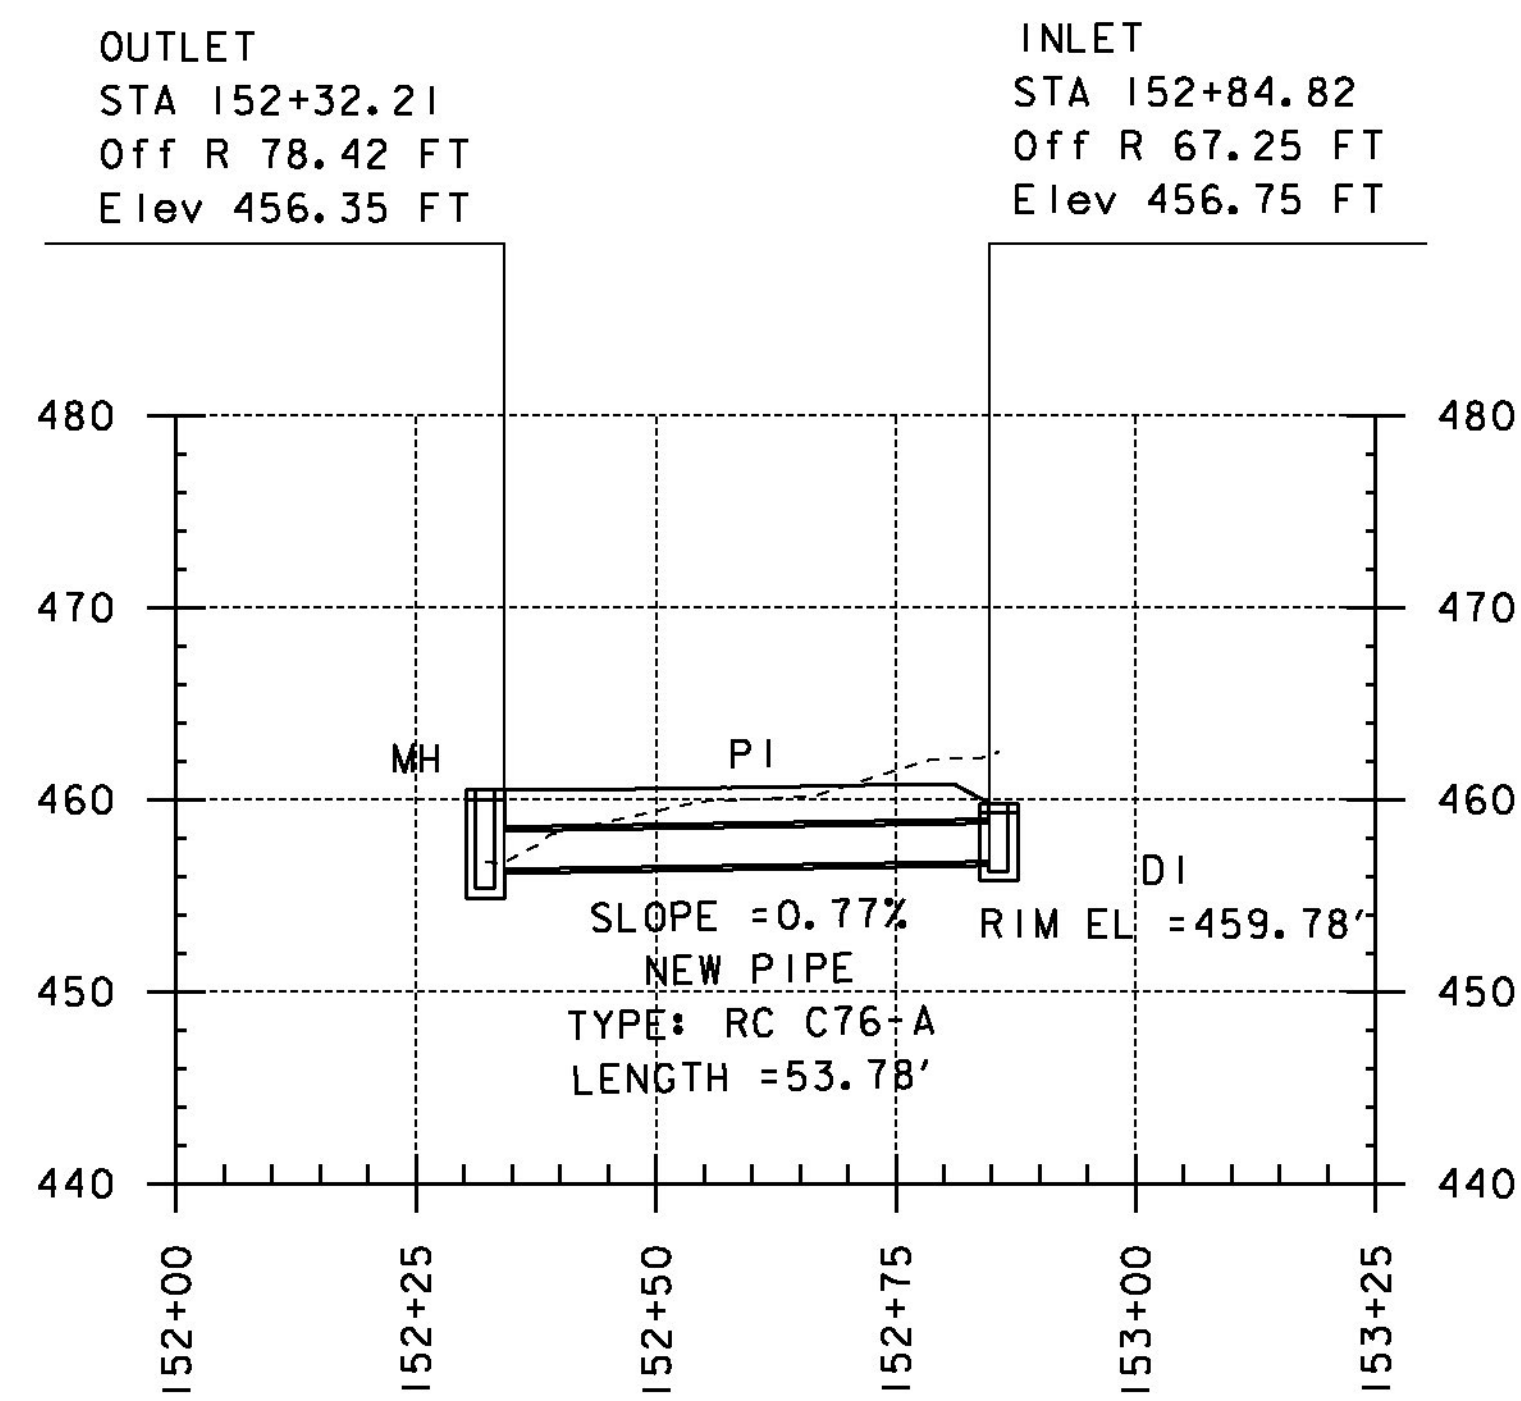


D-4

STA 149+43.13 (242.06' RT) - STA 149+16.82 (218.99' RT)  
 NEW 24" X 38" CPEP DRIVE CULVERT

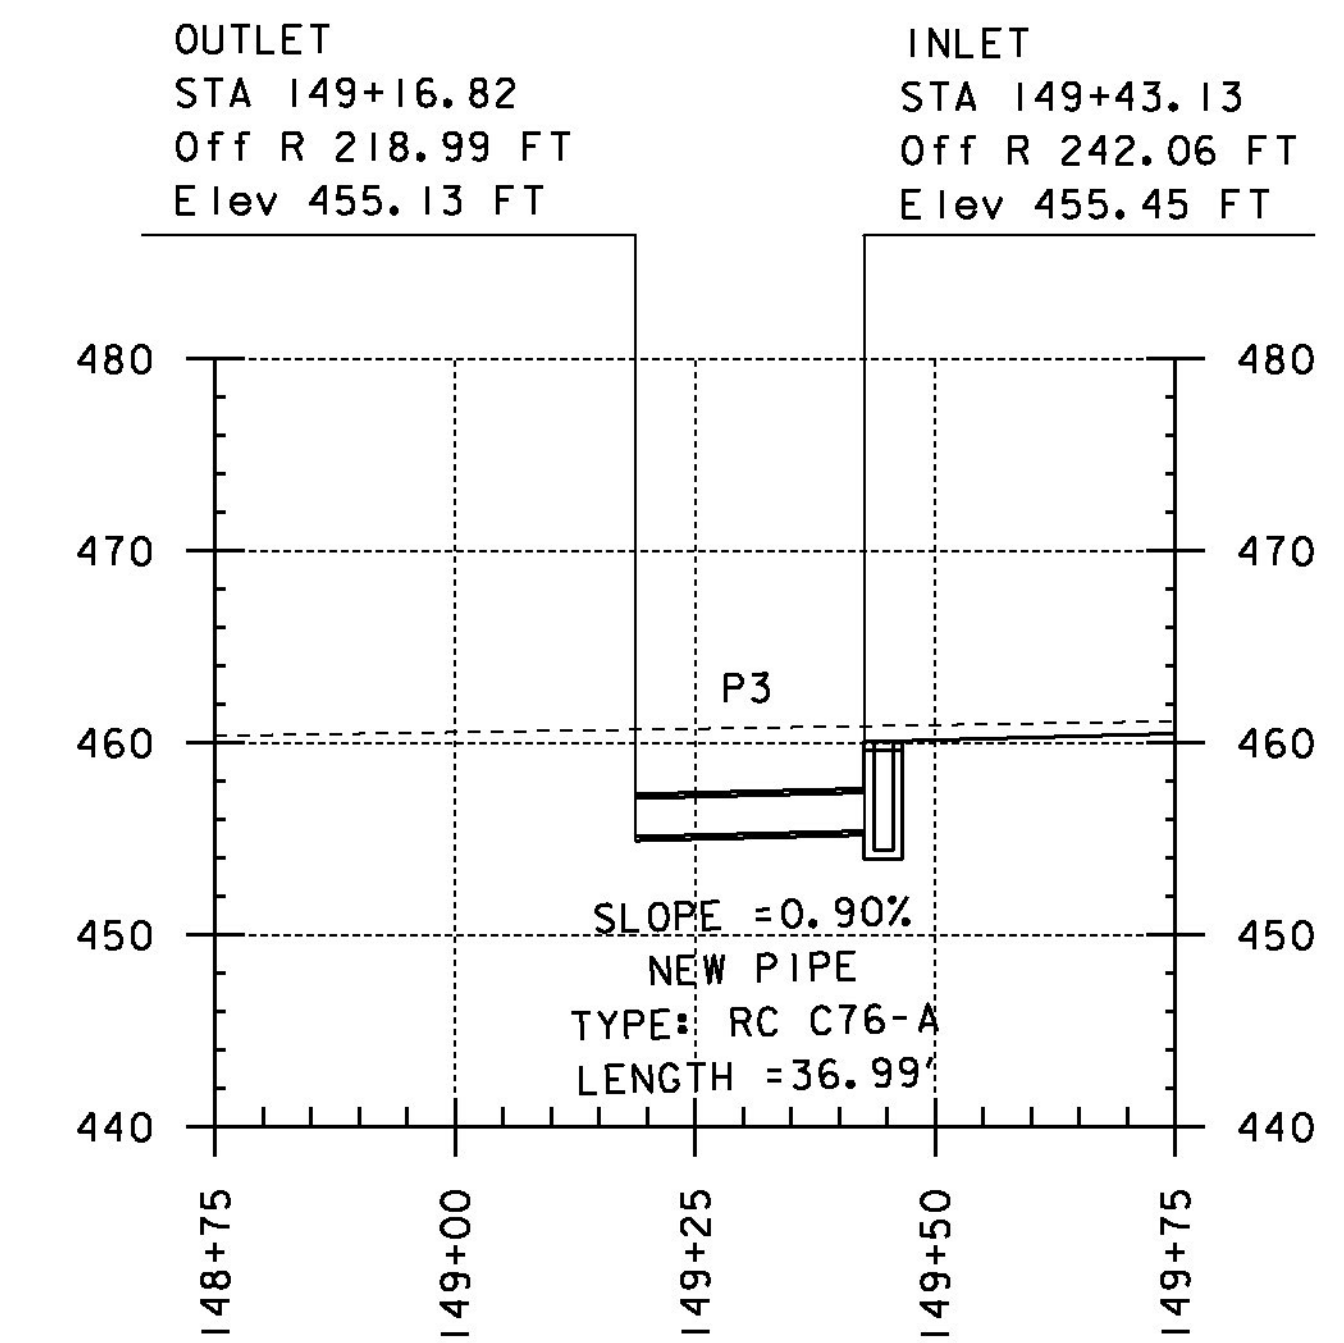

D-3

STA 149+34.82 (95.53' RT) - STA 148+46.48 (95.51' RT)  
 NEW 24" X 88" CPEP DETENTION POND - OUTLET CULVERT

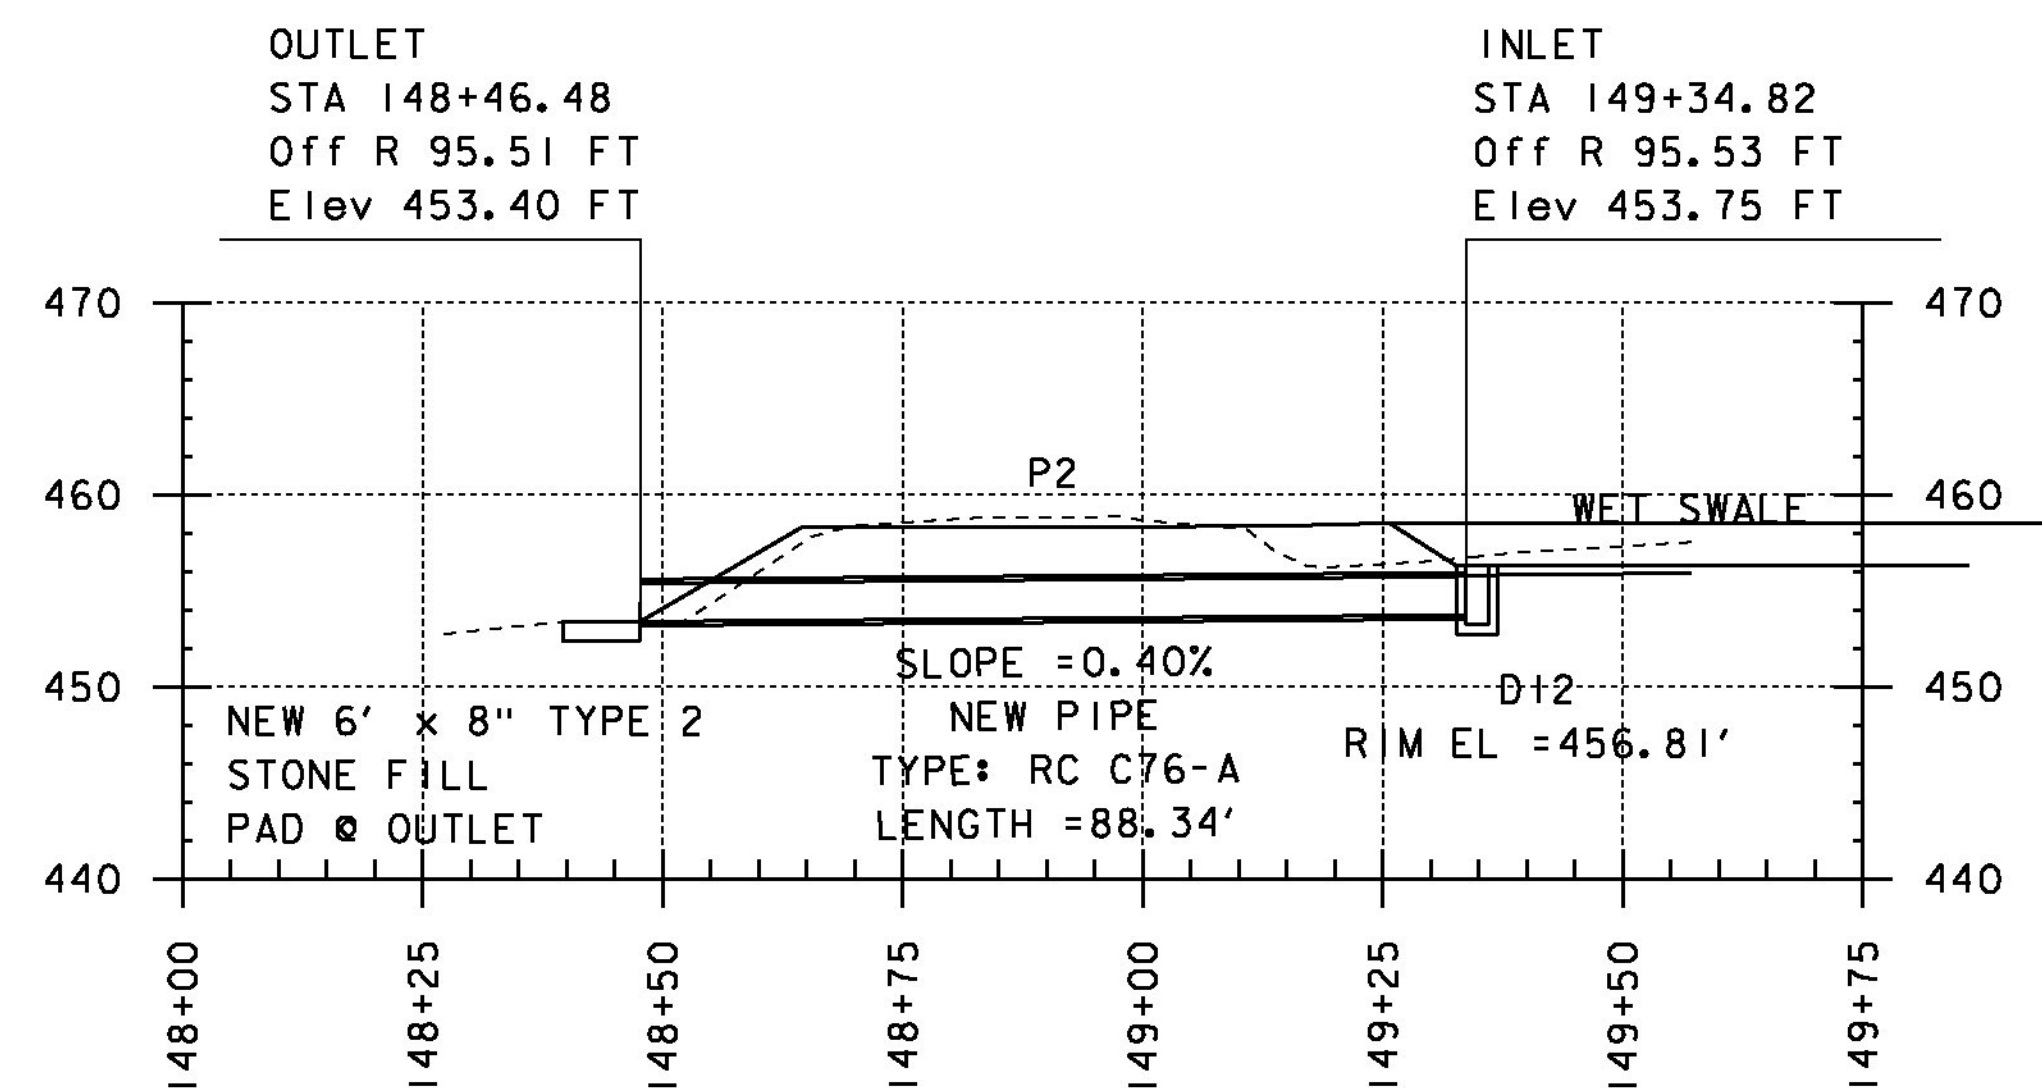

PROJECT NAME: GUILFORD	
PROJECT NUMBER: IM-IR 091-1(25)	
FILE NAME: D91A222_CLOCK.DGN	PLOT DATE: 22-JUL-2013
PROJECT LEADER: LIBBY	DRAWN BY: BEYOR
DESIGNED BY: BEYOR	CHECKED BY: BOMBARDIER
DRAINAGE CROSS SECTIONS	SHEET 36 OF 46