

ITEM 676.10 - DELINEATORS (WHITE) - TYPE I
 SWALE 600+00 (4' LT)
 SWALE 600+25 (4' LT)
 SWALE 601+50 (4' LT)
 SWALE 602+00 (4' LT)
 SWALE 602+50 (4' LT)


ITEM 676.10 - DELINEATORS (WHITE / RED) - TYPE III
 SWALE 600+50 (4' LT)
 SWALE 600+75 (4' LT)
 SWALE 601+00 (4' LT)
 SWALE 603+00 (4' LT)
 SWALE 603+25 (4' LT)
 SWALE 603+50 (4' LT)
 SWALE 603+75 (4' LT)
 SWALE 604+00 (4' LT)
 SWALE 604+25 (4' LT)
 SWALE 604+50 (4' LT)

ITEM 676.10 - DELINEATORS (AMBER) - TYPE I
 INSPECT 501+50 (4' RT)
 INSPECT 502+00 (4' RT)
 INSPECT 502+50 (4' RT)
 INSPECT 503+00 (4' RT)
 INSPECT 503+50 (4' RT)
 INSPECT 504+00 (4' RT)
 INSPECT 504+50 (4' RT)
 INSPECT 505+00 (4' RT)
 INSPECT 505+50 (4' RT)
 INSPECT 506+00 (4' RT)
 INSPECT 506+50 (4' RT)
~~INSPECT 507+00 (4' RT) ELIMINATED - SEE BELOW~~

ITEM 676.10 - DELINEATORS (AMBER / RED) - TYPE III
 INSPECT 500+00 (4' RT)
 INSPECT 500+25 (4' RT)
 INSPECT 500+50 (4' RT)
 INSPECT 500+75 (4' RT)
 INSPECT 501+00 (4' RT)
 INSPECT 507+00 (4' RT)
 INSPECT 507+25 (4' RT)
 INSPECT 507+50 (4' RT)
 INSPECT 507+75 (4' RT)
 INSPECT 508+00 (4' RT)

LEGEND

- DELINEATORS (WHITE) - TYPE I
- DELINEATORS (AMBER) - TYPE I
- DELINEATORS (WHITE / RED) - TYPE III
- DELINEATORS (AMBER / RED) - TYPE III

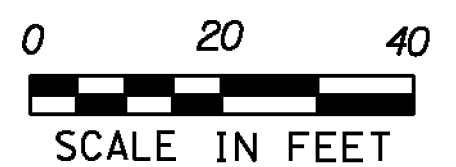

PROJECT NAME: GUILFORD	
PROJECT NUMBER: IM-IR 091-I(25)	
FILE NAME: D9IA222_TRF.dgn	PLOT DATE: 22-JUL-2013
PROJECT LEADER: LIBBY	DRAWN BY: BEYOR
DESIGNED BY: BEYOR	CHECKED BY: BOMBARDIER
DELINEATOR SHEET I	SHEET 45 OF 46