


PAVEMENT MARKING DETAIL

FOR MONTPELIER INTERCHANGE NO. 8

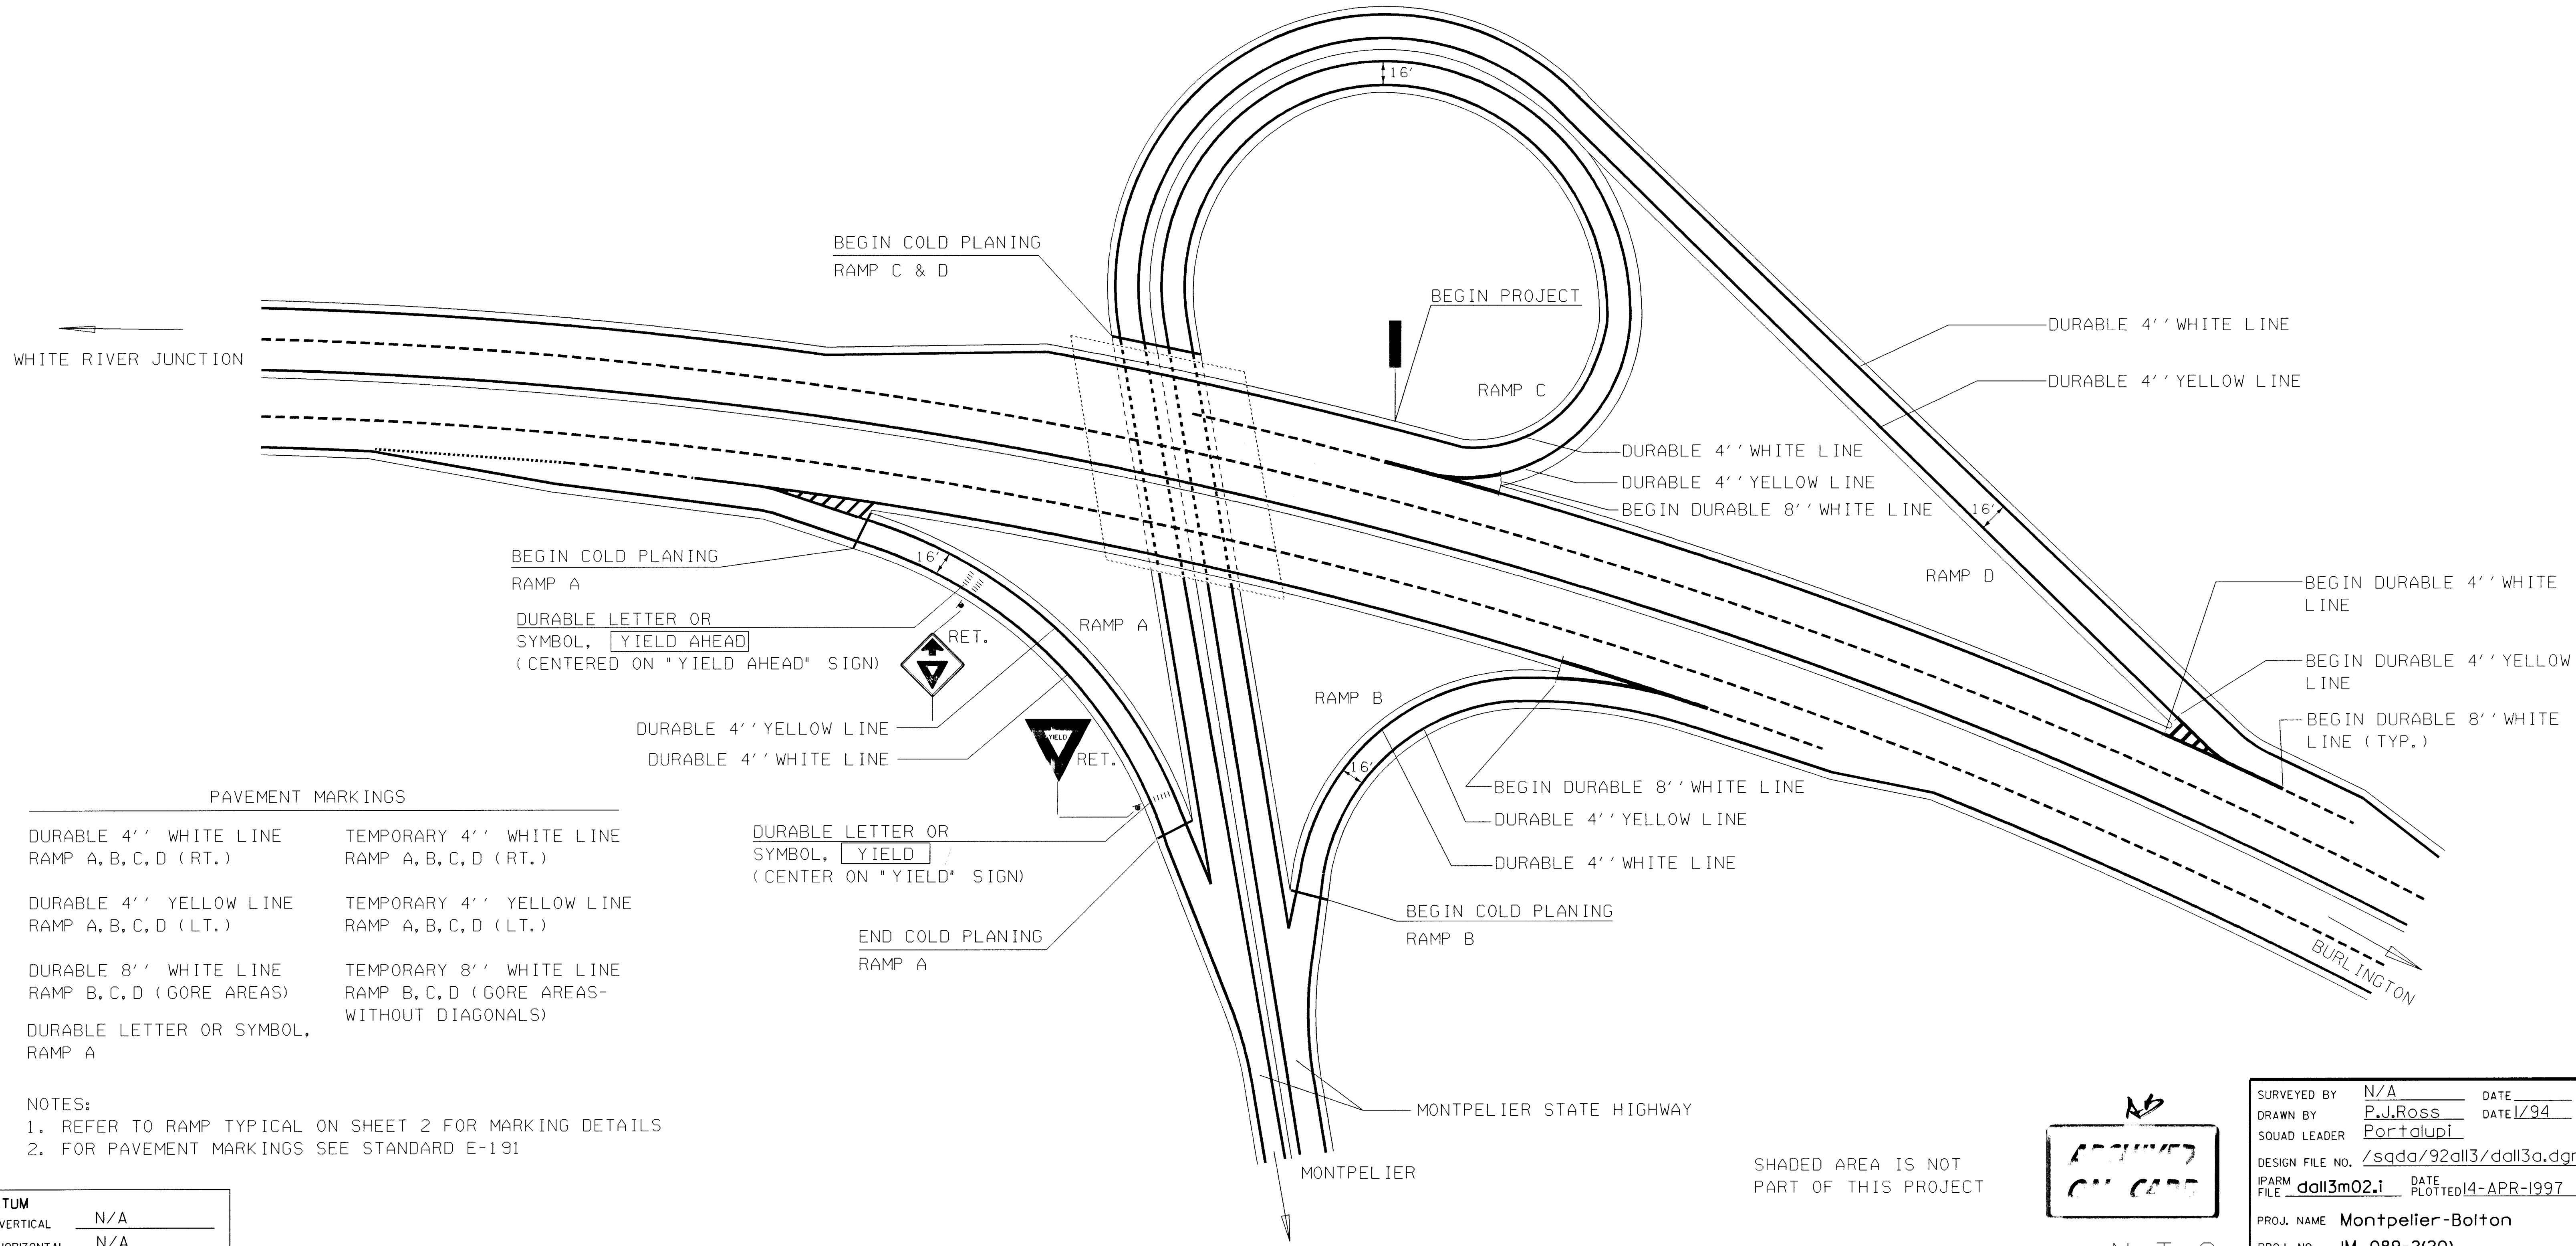


PAVEMENT MARKINGS

DURABLE 4" WHITE LINE RAMP A, B, C, D (RT.)	TEMPORARY 4" WHITE LINE RAMP A, B, C, D (RT.)
DURABLE 4" YELLOW LINE RAMP A, B, C, D (LT.)	TEMPORARY 4" YELLOW LINE RAMP A, B, C, D (LT.)
DURABLE 8" WHITE LINE RAMP B, C, D (GORE AREAS)	TEMPORARY 8" WHITE LINE RAMP B, C, D (GORE AREAS- WITHOUT DIAGONALS)
DURABLE LETTER OR SYMBOL, RAMP A	

- NOTES:**
 1. REFER TO RAMP TYPICAL ON SHEET 2 FOR MARKING DETAILS
 2. FOR PAVEMENT MARKINGS SEE STANDARD E-191

DATUM	
VERTICAL	N/A
HORIZONTAL	N/A

SHADED AREA IS NOT PART OF THIS PROJECT

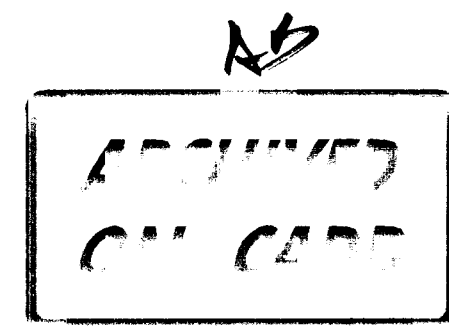

SURVEYED BY	N/A	DATE	
DRAWN BY	P.J. Ross	DATE	1/94
SQUAD LEADER	Portolupi		
DESIGN FILE NO.	/sqda/92all3/dall3a.dgn		
IPARM FILE	dall3m02.i	DATE PLOTTED	14-APR-1997
PROJ. NAME	Montpelier-Bolton		
PROJ. NO.	IM 089-2(20)		
SHEET	12	OF	16 SHEETS

N. T. S.