


PAVEMENT AND MARKING DETAIL

FOR MIDDLESEX INTERCHANGE NO. 9

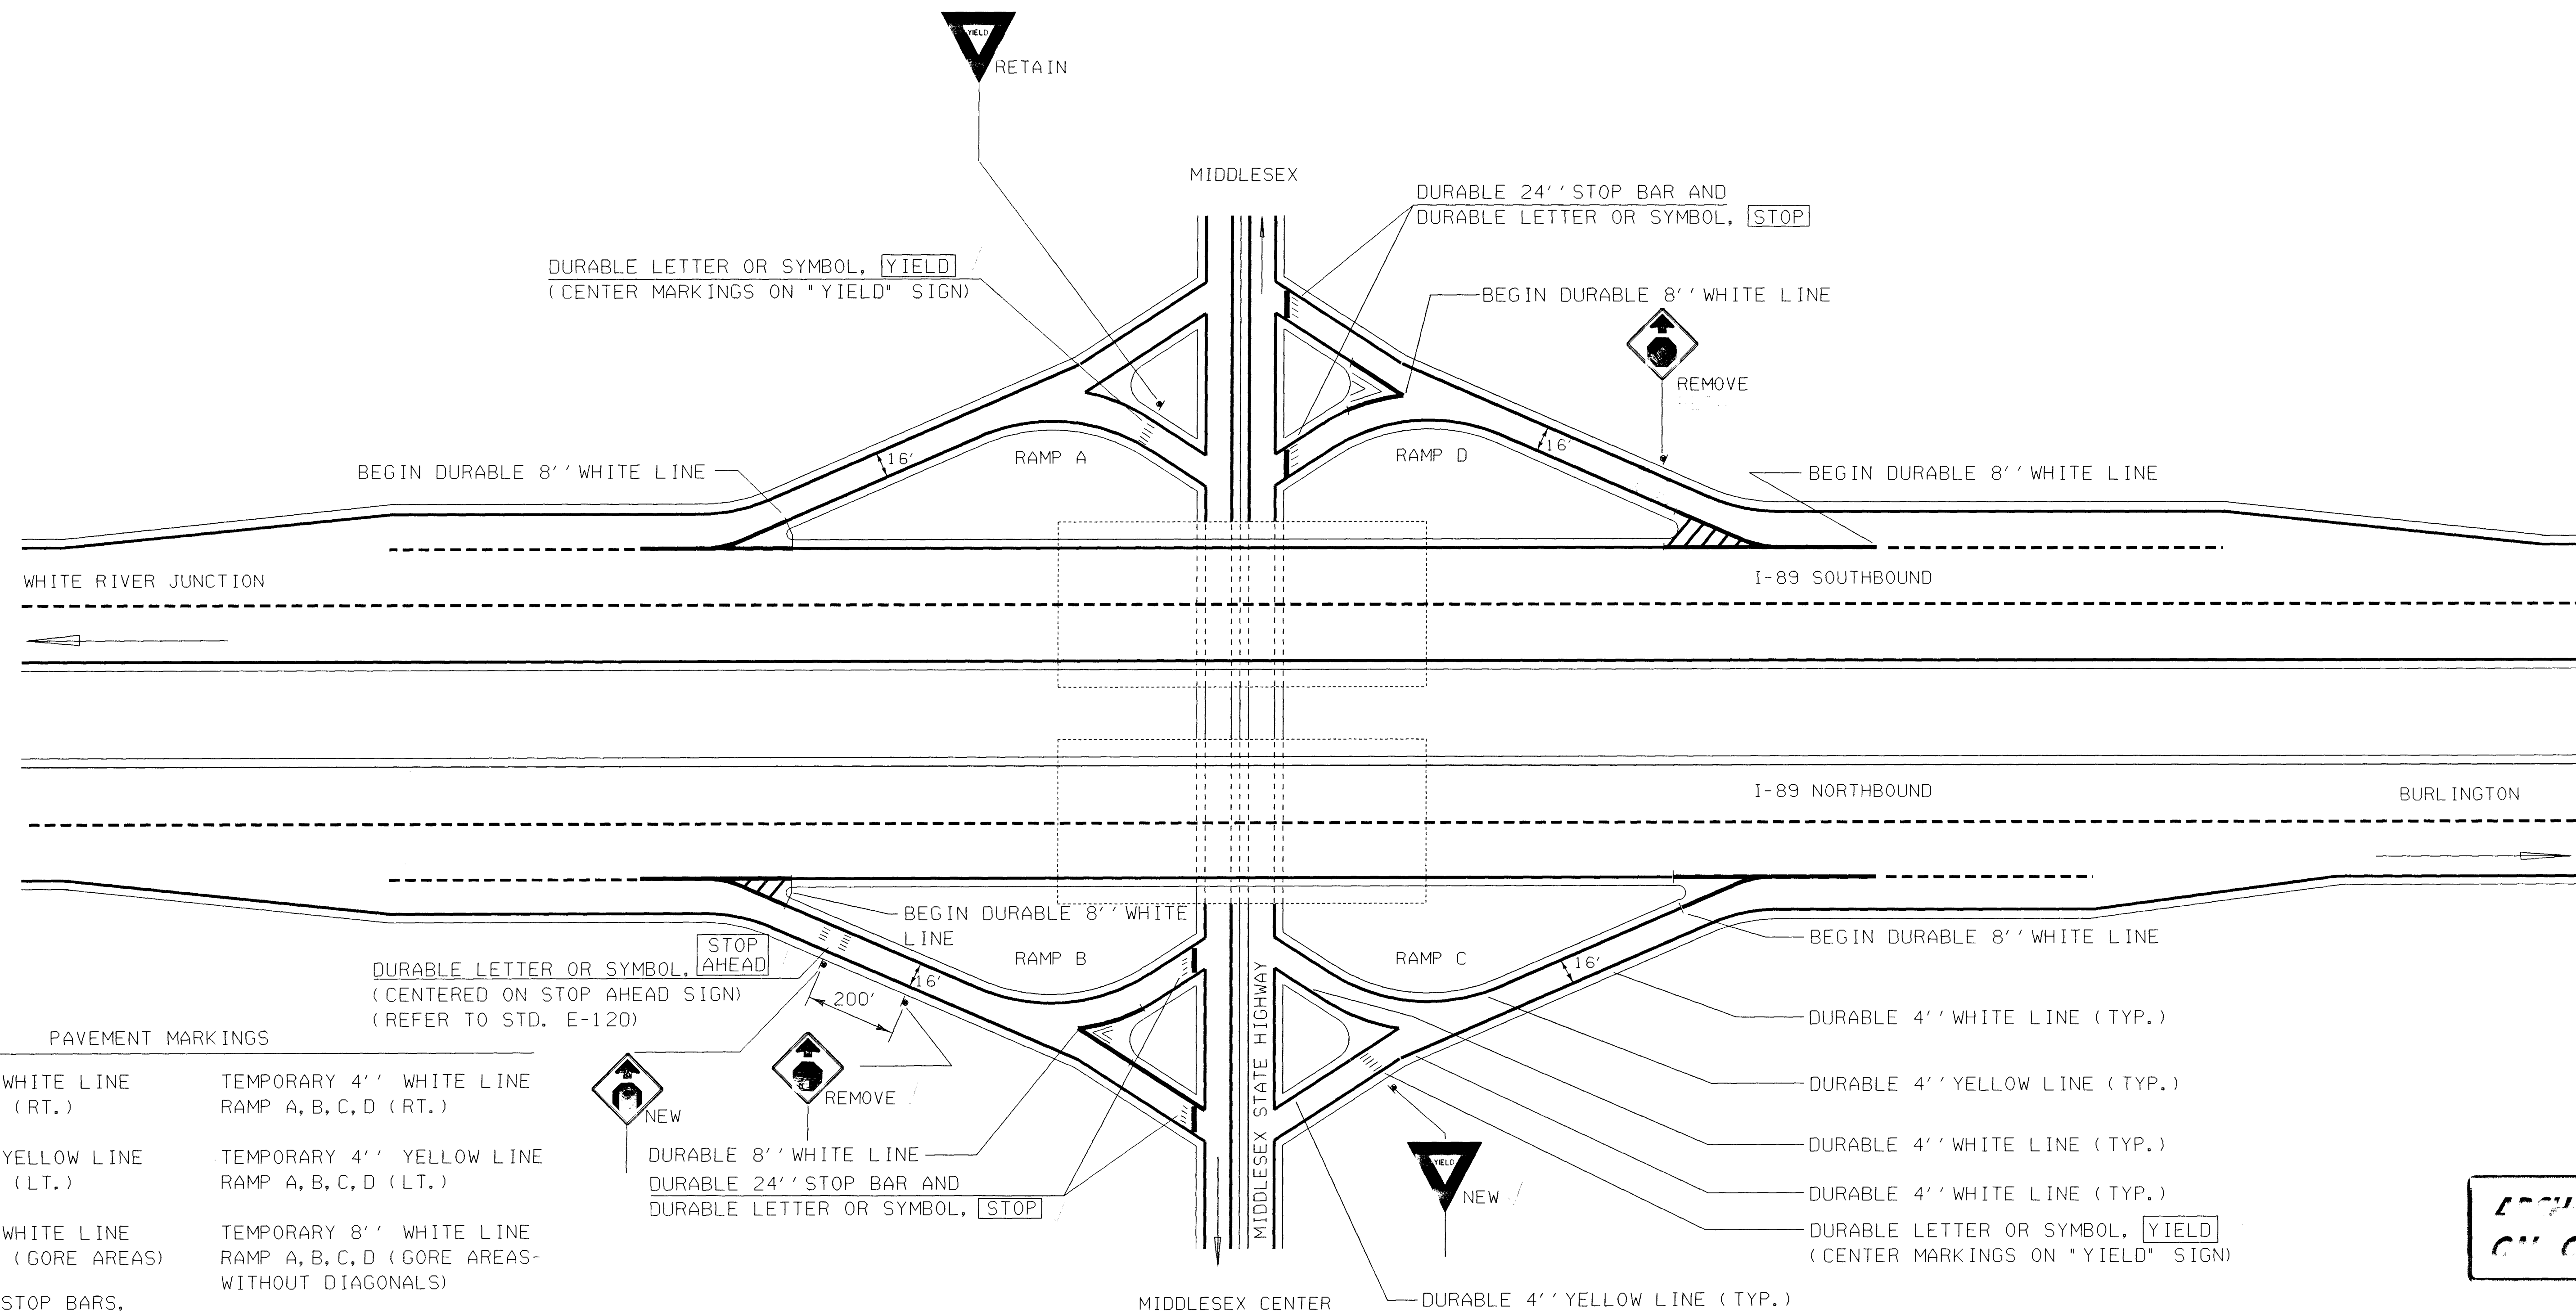

PAVEMENT MARKINGS

DURABLE 4" WHITE LINE
RAMP A, B, C, D (RT.)

TEMPORARY 4" WHITE LINE
RAMP A, B, C, D (RT.)

DURABLE 4" YELLOW LINE
RAMP A, B, C, D (LT.)

TEMPORARY 4" YELLOW LINE
RAMP A, B, C, D (LT.)

DURABLE 8" WHITE LINE
RAMP A, B, C, D (GORE AREAS)

TEMPORARY 8" WHITE LINE
RAMP A, B, C, D (GORE AREAS-
WITHOUT DIAGONALS)

24" DURABLE STOP BARS,
RAMP B, D

DURABLE LETTER OR SYMBOL,
RAMP A, B, C, D

NOTE:

- REFER TO RAMP TYPICAL ON SHEET 2 FOR MARKING DETAILS
- FOR PAVEMENT MARKINGS SEE STANDARD E-191

NOTES:

COLD PLANING AND PAVEMENT WILL END AT THE END RAMP B&D,
AND WILL BEGIN AT BEGINNING OF RAMP A&C.

SHADED AREA IS NOT
PART OF THIS PROJECT

DATUM
VERTICAL N/A
HORIZONTAL N/A

SURVEYED BY	<u>N/A</u>	DATE	<u> </u>
DRAWN BY	<u>P.J. Ross</u>	DATE	<u>1/94</u>
SQUAD LEADER	<u>Portugal</u>		
DESIGN FILE NO.	<u>/sqda/92all3/dall3a.dgn</u>		
IPARM FILE	<u>dall3m03.i</u>	DATE PLOTTED	<u>14-APR-1997</u>
PROJ. NAME	<u>Montpelier-Bolton</u>		
PROJ. NO.	<u>IM 089-2(20)</u>		
SHEET	<u>13</u>	OF	<u>16</u> SHEETS

N. T. S.