



CONSTRUCTION APPROACH SIGNING


MAINLINE*

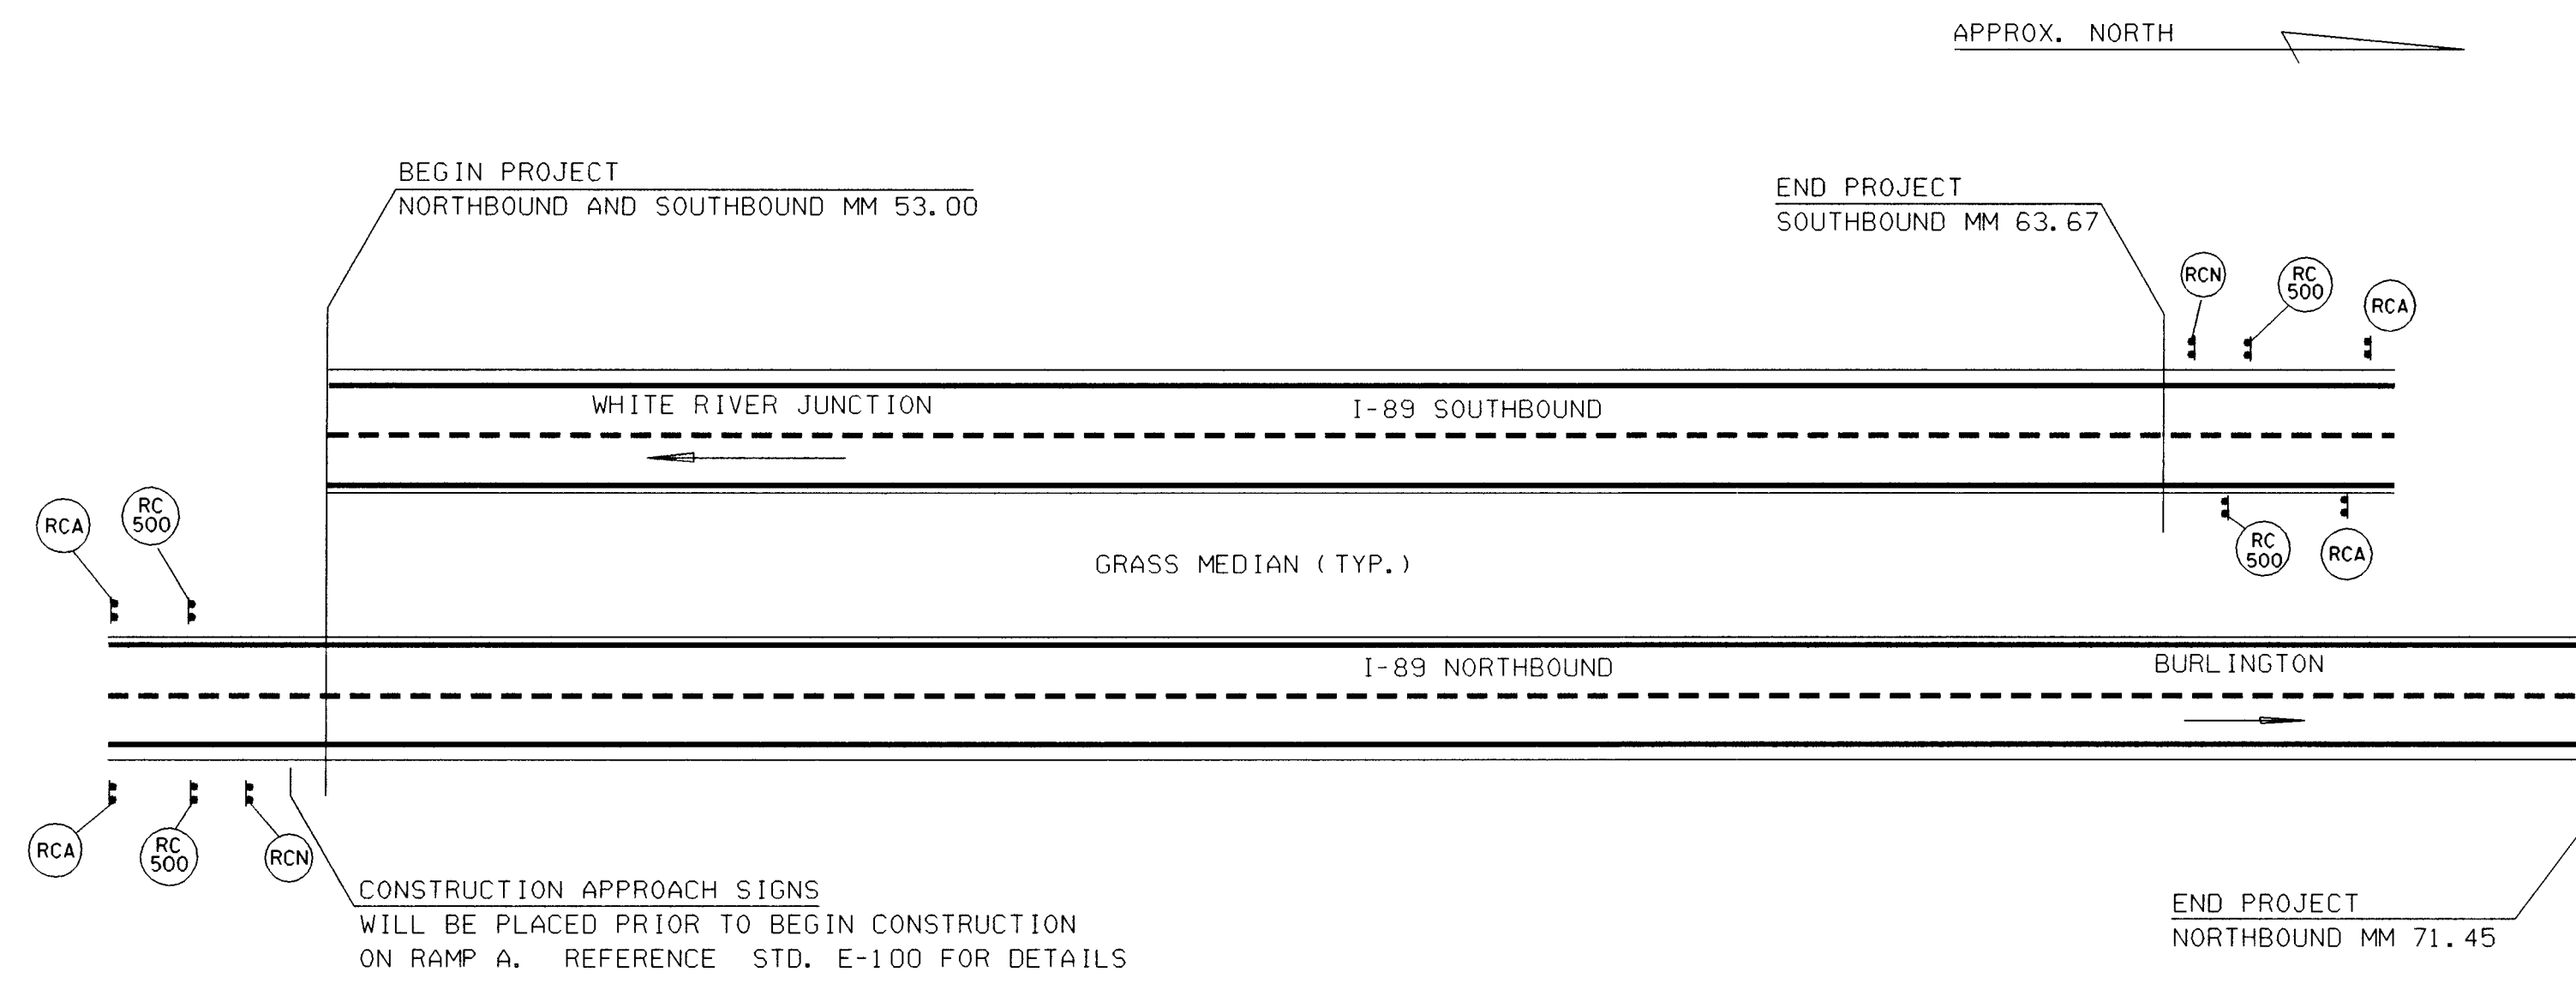


MONTPELIER INTERCHANGE*

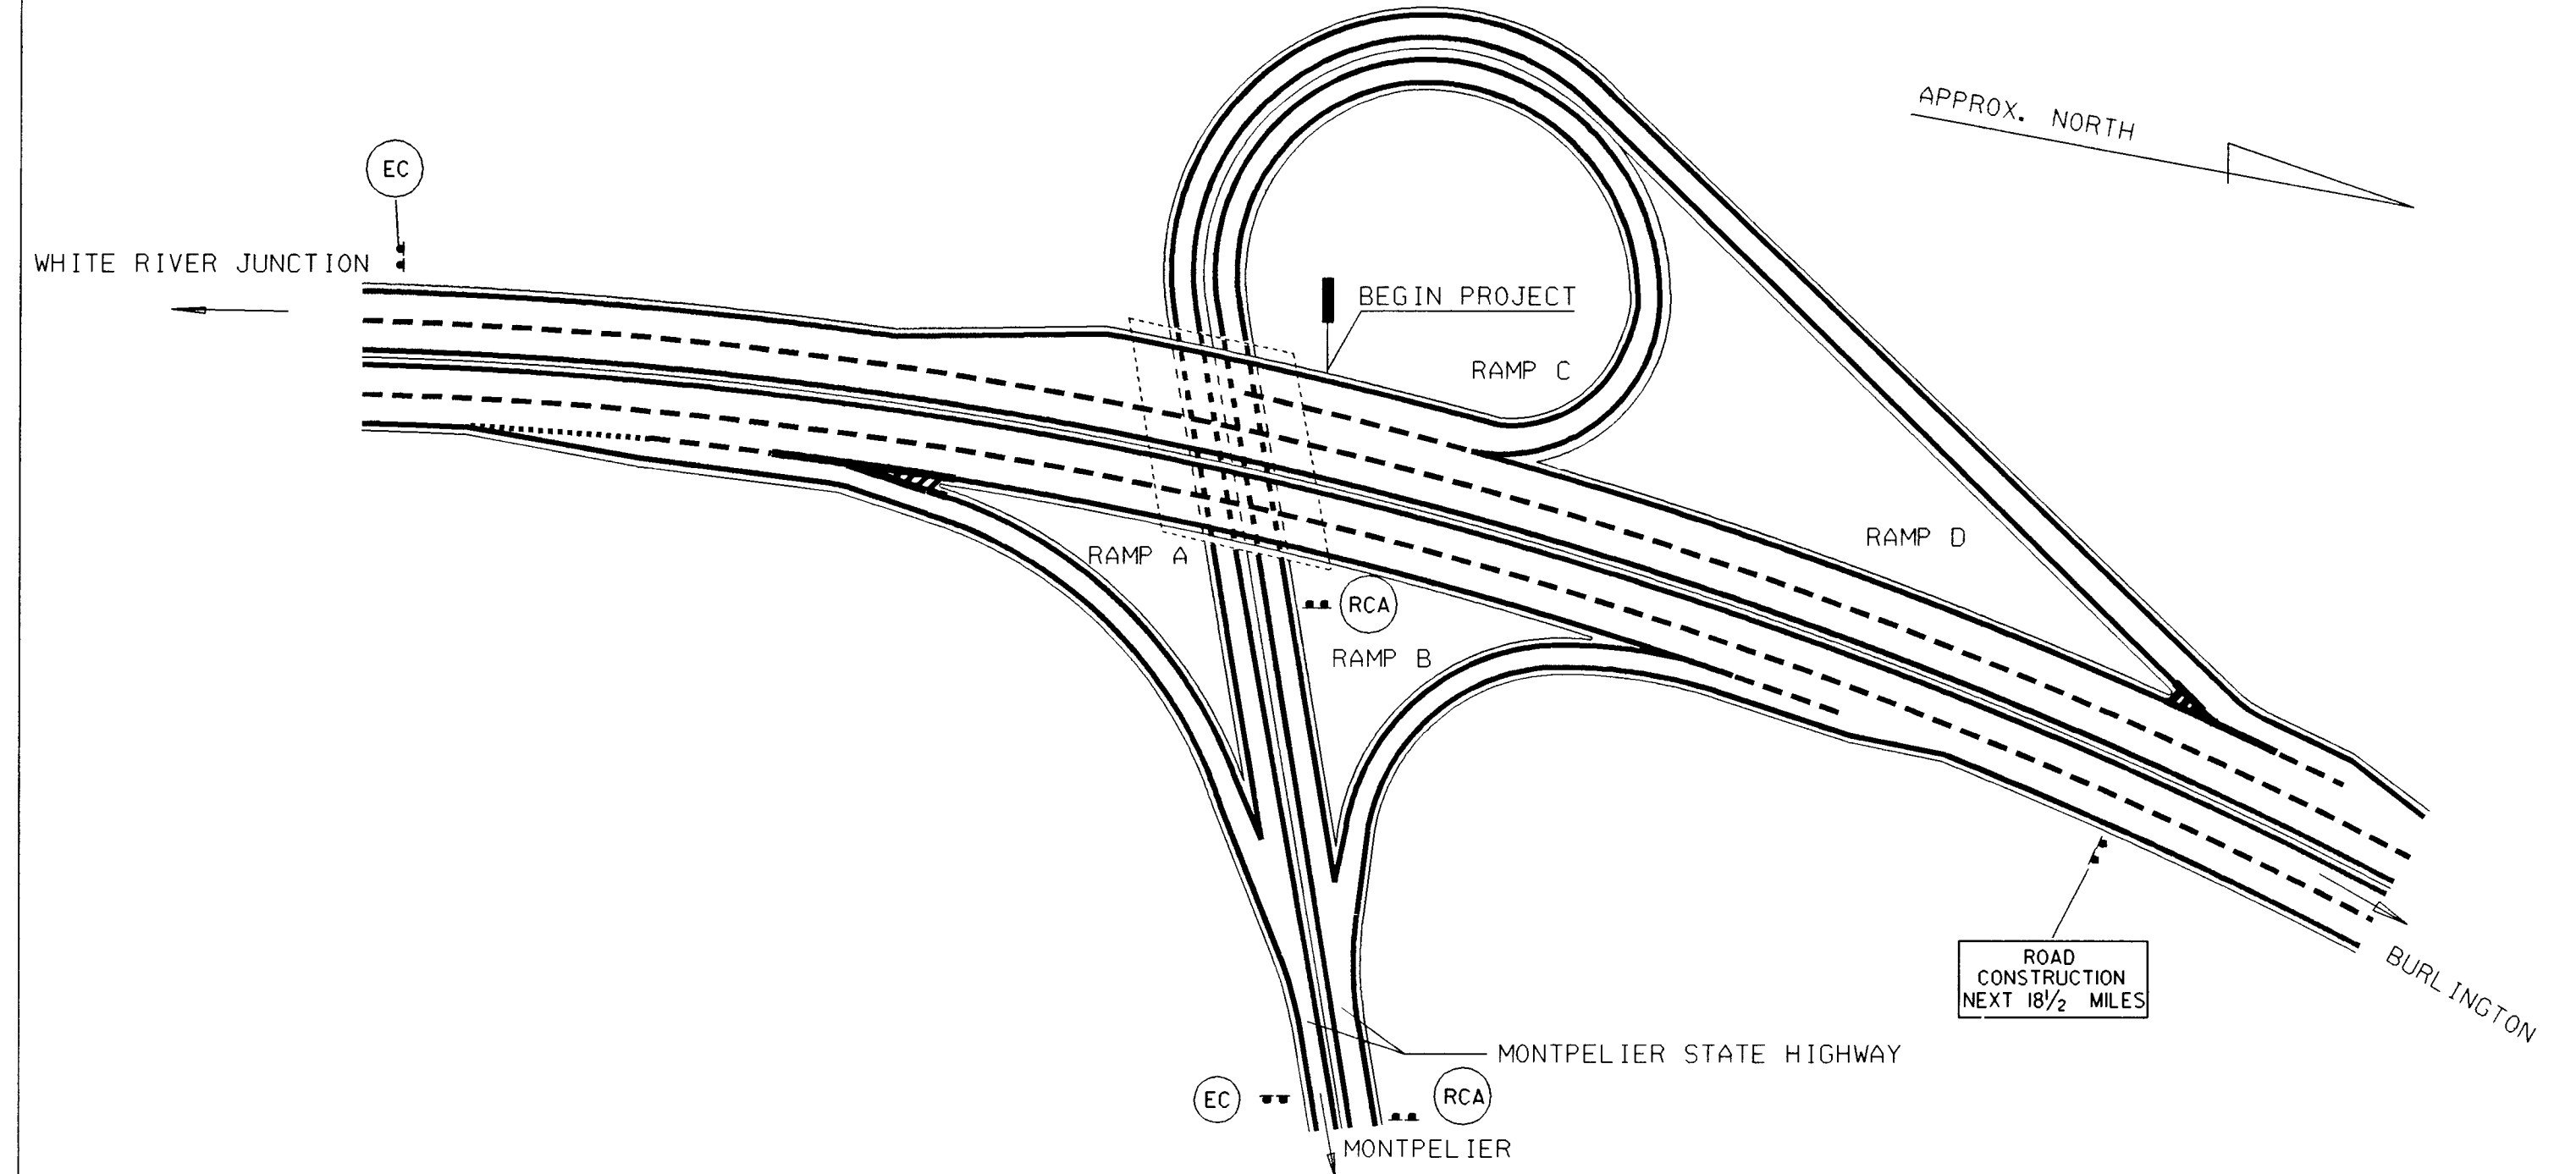

MIDDLESEX INTERCHANGE*

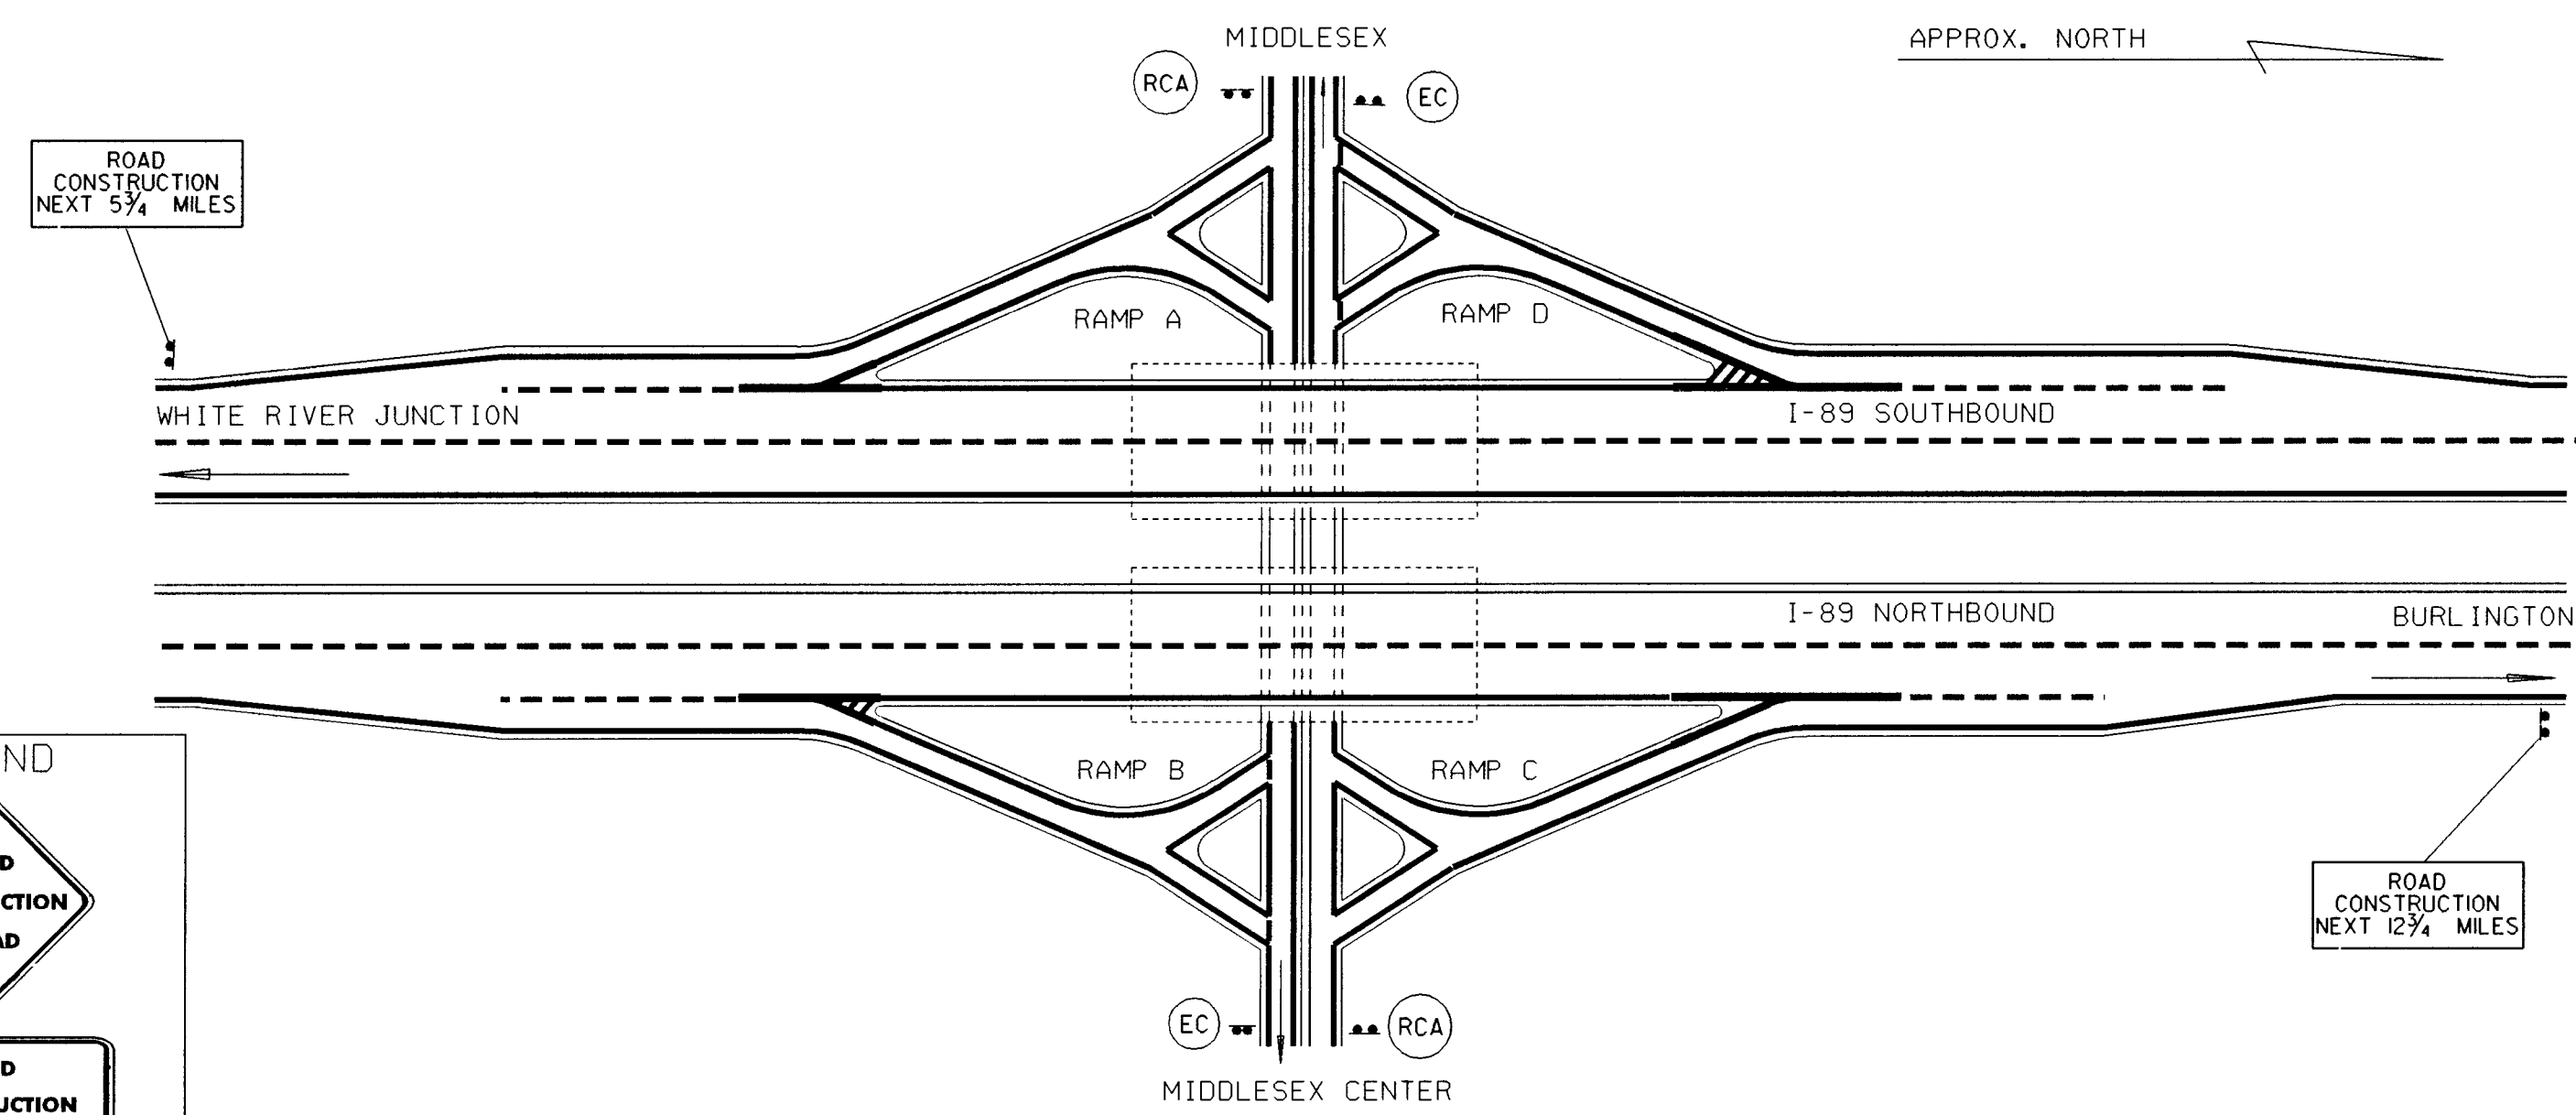

WATERBURY INTERCHANGE*

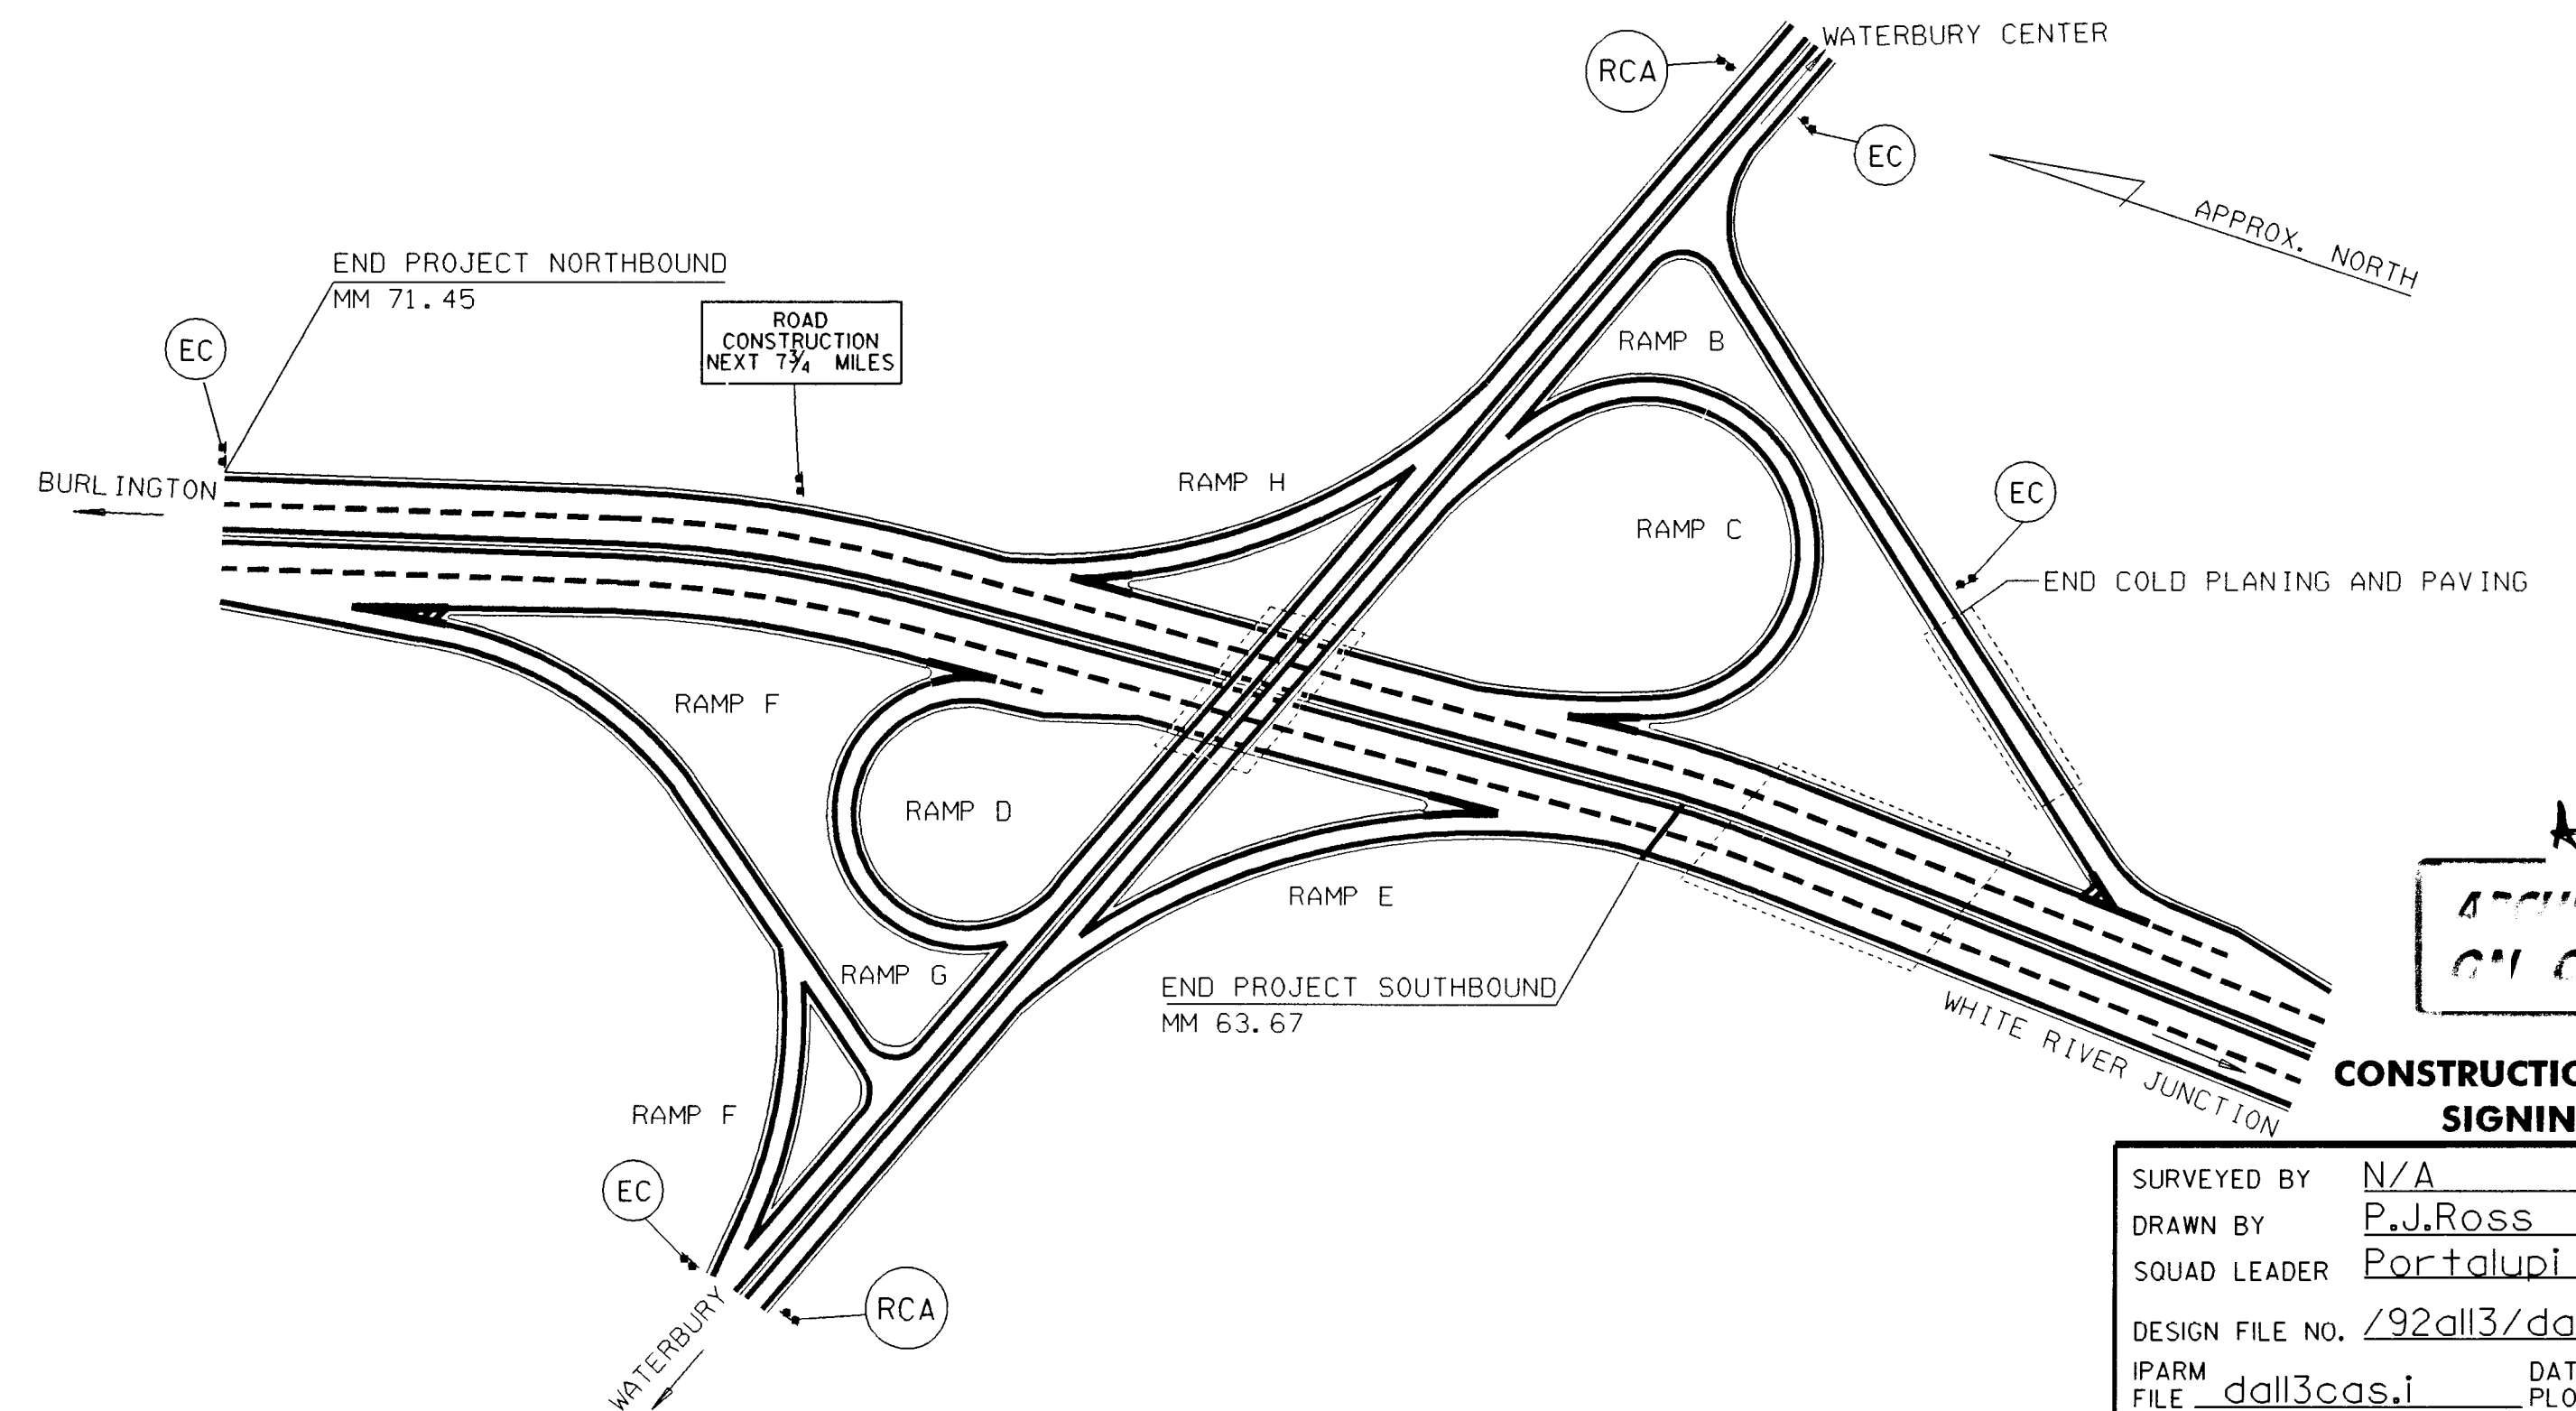

LEGEND

- RCA = ROAD CONSTRUCTION AHEAD
- EC = END CONSTRUCTION
- RCN = ROAD CONSTRUCTION NEXT X MILES
- RC 500 = ROAD CONSTRUCTION 500 FT

* REFER TO STANDARD E-100

N. T. S.

CONSTRUCTION APPROACH SIGNING SHEET	
SURVEYED BY	N/A
DRAWN BY	P.J. Ross
SQUAD LEADER	Portalupe
DESIGN FILE NO.	/92all3/dall3cas.dgn
IPARM FILE	dall3cas.i
DATE	14-APR-1997
PROJ. NAME	Montpelier-Bolton
PROJ. NO.	IM 089-2(20)
SHEET	15 OF 16 SHEETS