


MAINLINE PROFILE



- NOTES:
 1. ELEVATIONS SHOWN TO THE NEAREST TENTH ARE EXISTING GROUND ALONG CENTERLINE
 2. ELEVATIONS SHOWN TO THE NEAREST HUNDREDTH ARE FINISH GRADE ALONG CENTERLINE

PROJECT NAME: PUTNEY	PROJECT NUMBER: IM 091-1(31)
FILE NAME: ...NIO z93al48 pro l.ptf	PLOT DATE: 10/19/2009
PROJECT LEADER: G. BOGUE	DRAWN BY: E. ALLING
DESIGNED BY: E. ALLING	CHECKED BY: G. GOYETTE
MAINLINE PROFILE 1	SHEET 10 OF 75

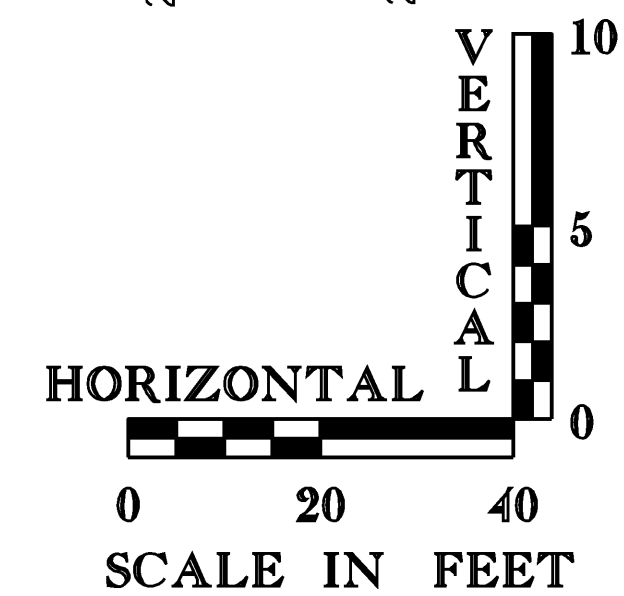