


NOTES:  
 1. ELEVATIONS SHOWN TO THE NEAREST TENTH ARE EXISTING GROUND ALONG CENTERLINE  
 2. ELEVATIONS SHOWN TO THE NEAREST HUNDRETH ARE FINISH GRADE ALONG CENTERLINE

**MAINLINE PROFILE**

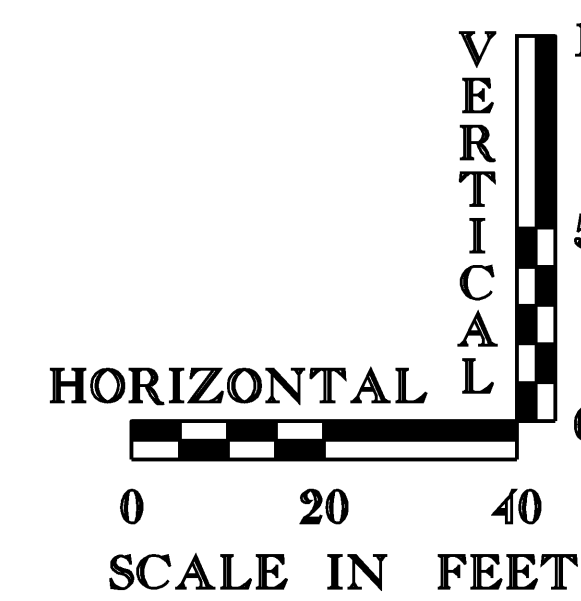

PROJECT NAME: PUTNEY	PROJECT NUMBER: IM 091-1(31)
FILE NAME: ...N1293dl48 pro 2.pptf	PLOT DATE: 10/19/2009
PROJECT LEADER: G. BOGUE	DRAWN BY: E. ALLING
DESIGNED BY: E. ALLING	CHECKED BY: G. GOYETTE
<b>MAINLINE PROFILE 2</b>	SHEET 11 OF 75