


NOTES:

1. ELEVATIONS SHOWN TO THE NEAREST TENTH ARE EXISTING GROUND ALONG CENTERLINE.
2. ELEVATIONS SHOWN TO THE NEAREST HUNDREDTH ARE FINISH GRADE ALONG CENTERLINE.

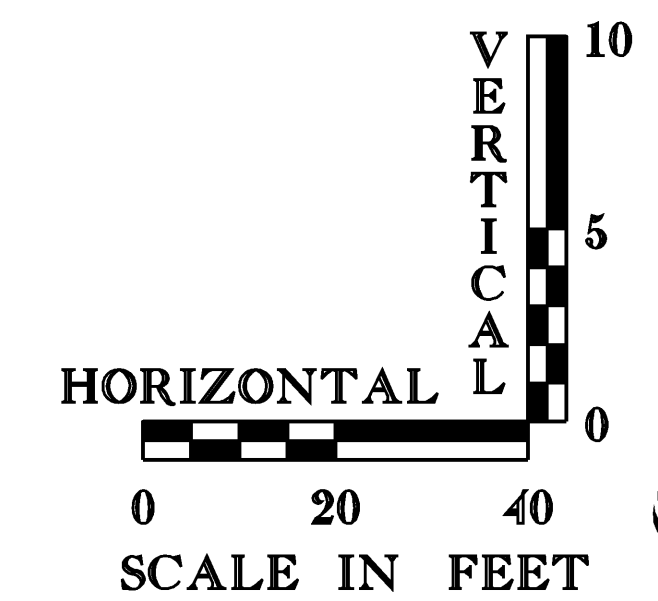

PROJECT NAME: PUTNEY	
PROJECT NUMBER: IM 091-1(31)	
FILE NAME: ...N12 z93a148 pro temp_detour.plt	DATE: 10/19/2009
PROJECT LEADER: G. BOGUE	DRAWN BY: E. ALLING
DESIGNED BY: E. ALLING	CHECKED BY: G. GOYETTE
TEMPORARY DETOUR PROFILE 1	
SHEET 12 OF 75	