


NOTES:

1. ELEVATIONS SHOWN TO THE NEAREST TENTH ARE EXISTING GROUND ALONG CENTERLINE.
2. ELEVATIONS SHOWN TO THE NEAREST HUNDREDTH ARE FINISH GRADE ALONG CENTERLINE.

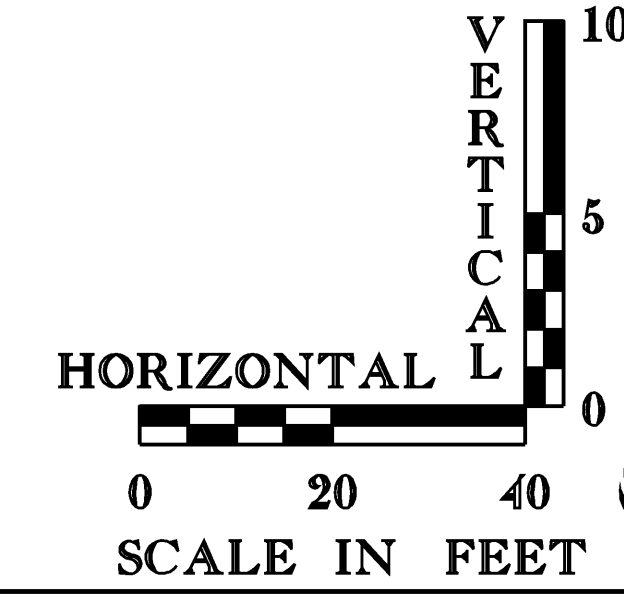

PROJECT NAME: PUTNEY	DATE: 10/19/2009
PROJECT NUMBER: IM 091-1(31)	DRAWN BY: E. ALLING
FILE NAME: ...N14 z93a148 pro temp.dettour 31101	CHECKED BY: G. GOYETTE
DESIGNED BY: E. ALLING	SHEET 14 OF 75
<b>TEMPORARY DETOUR PROFILE 3</b>	