

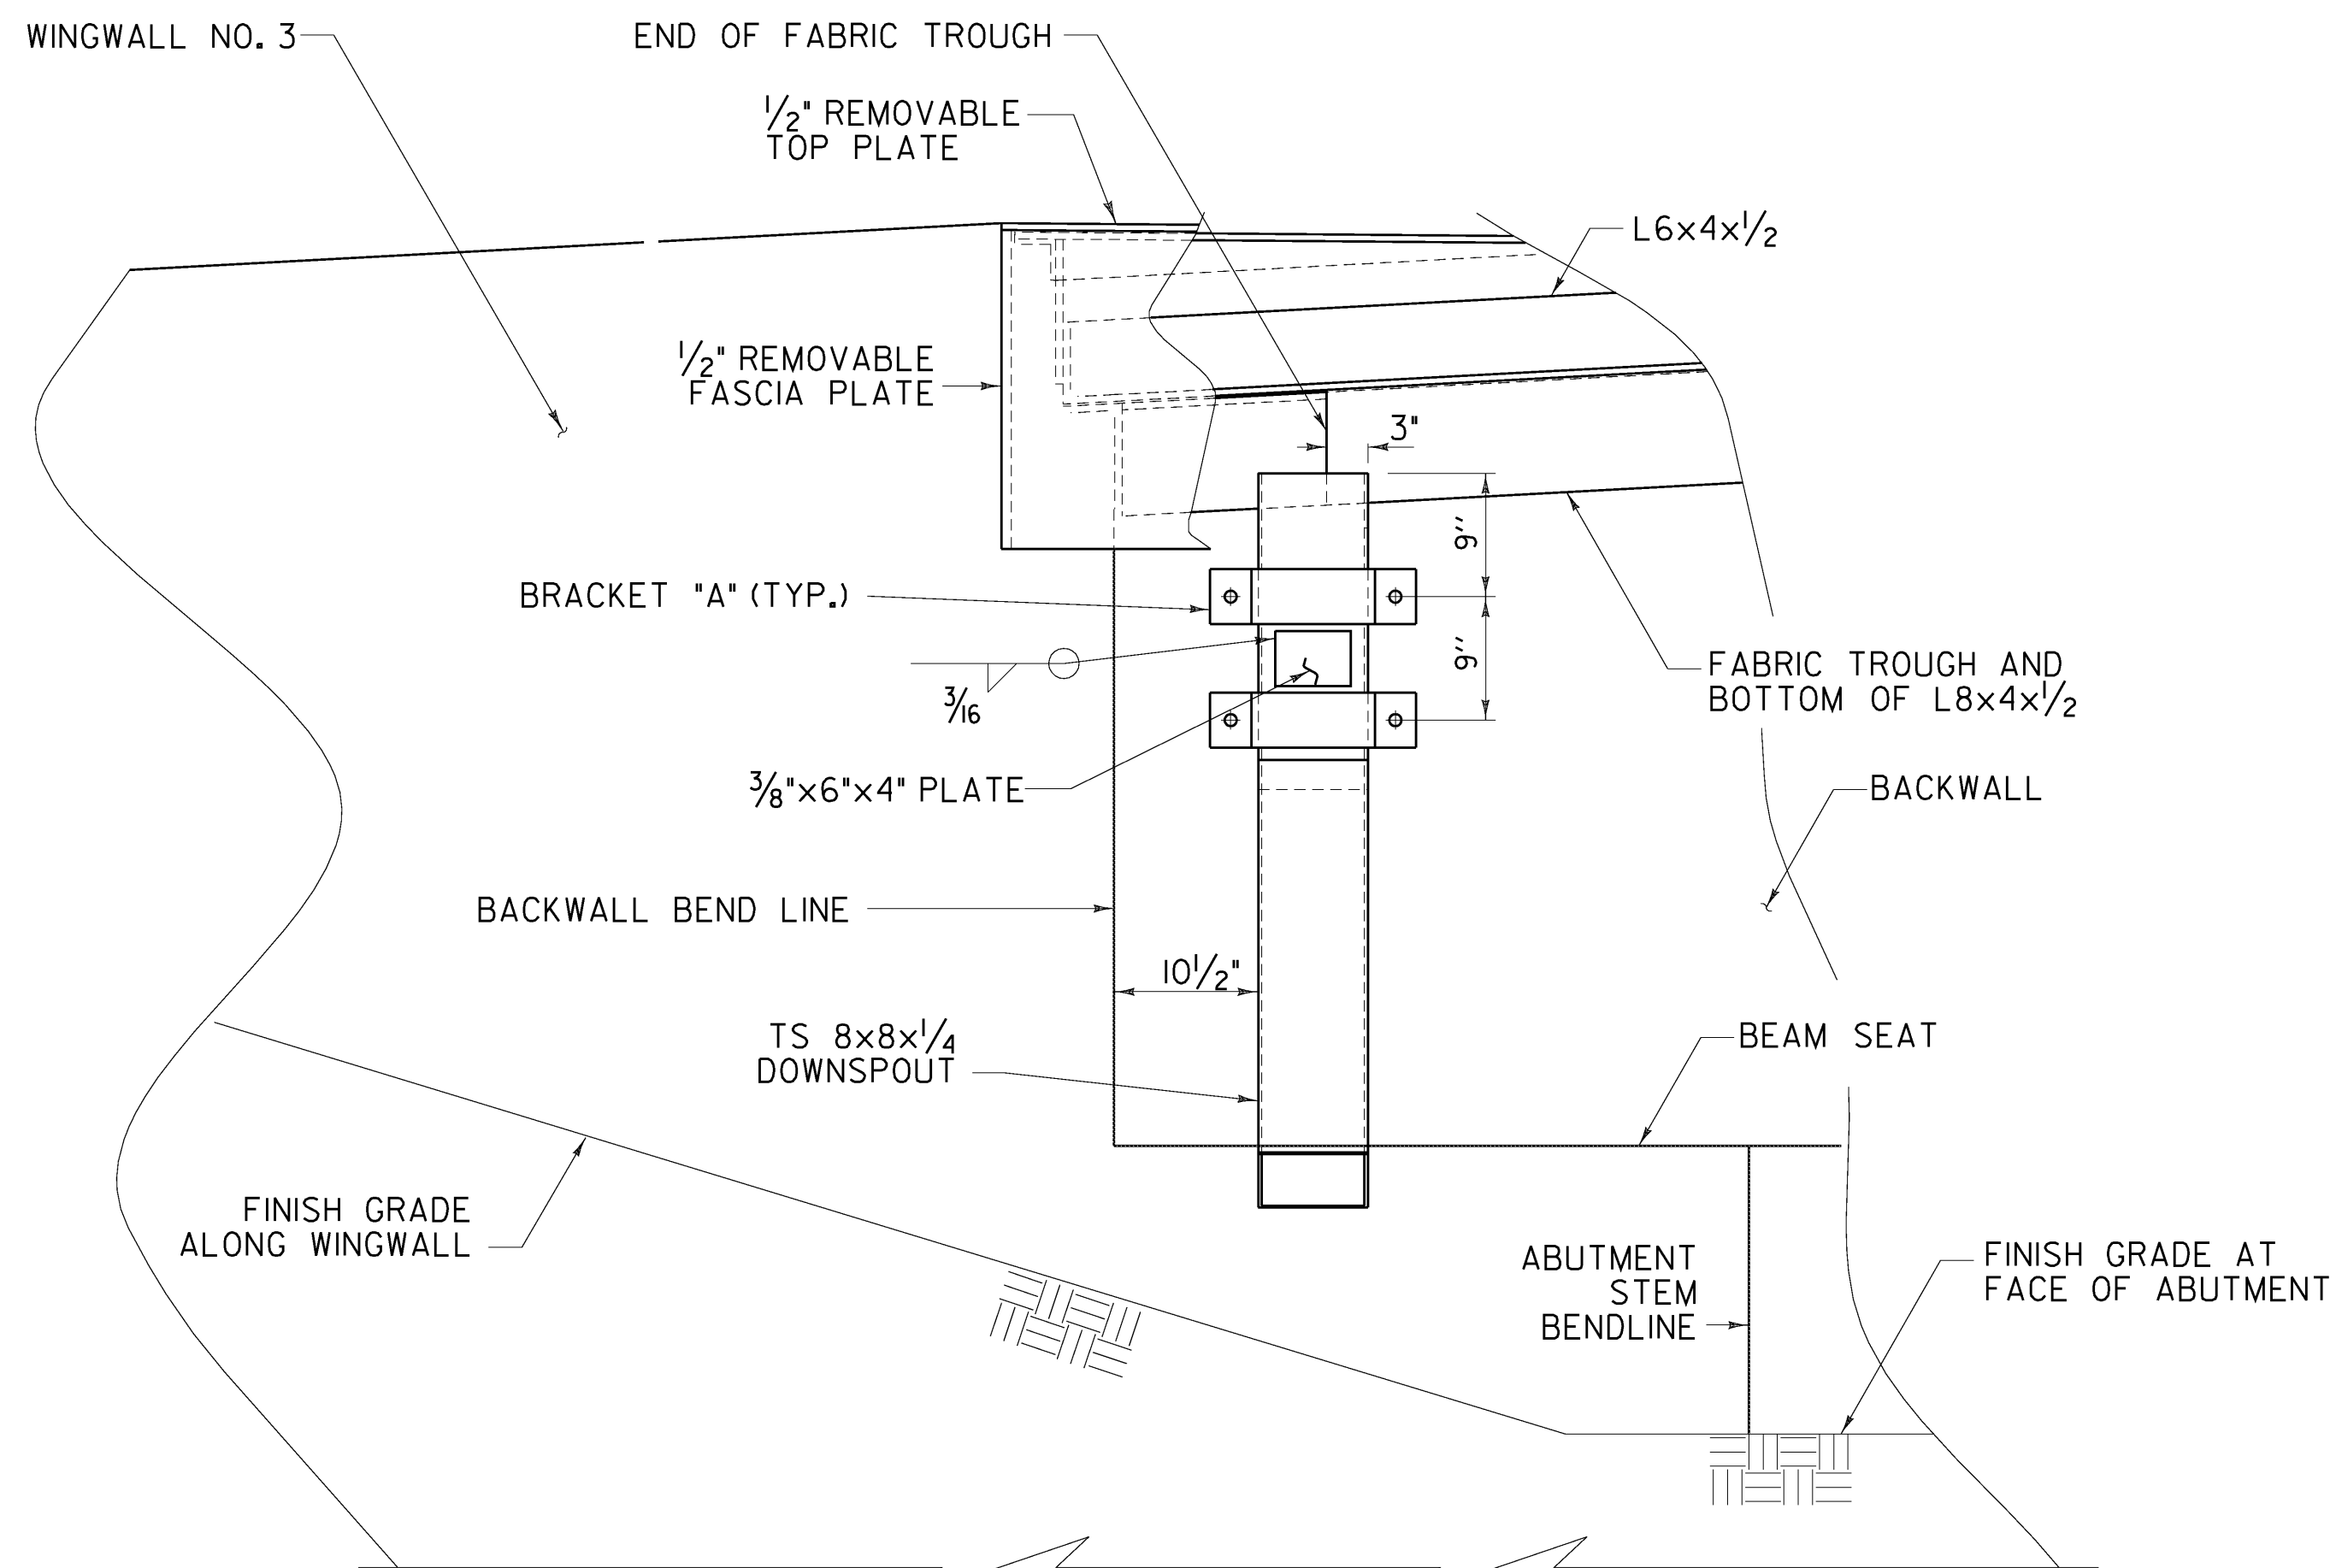


ABUTMENT 2 - DOWNSPOUT SIDE ELEVATION

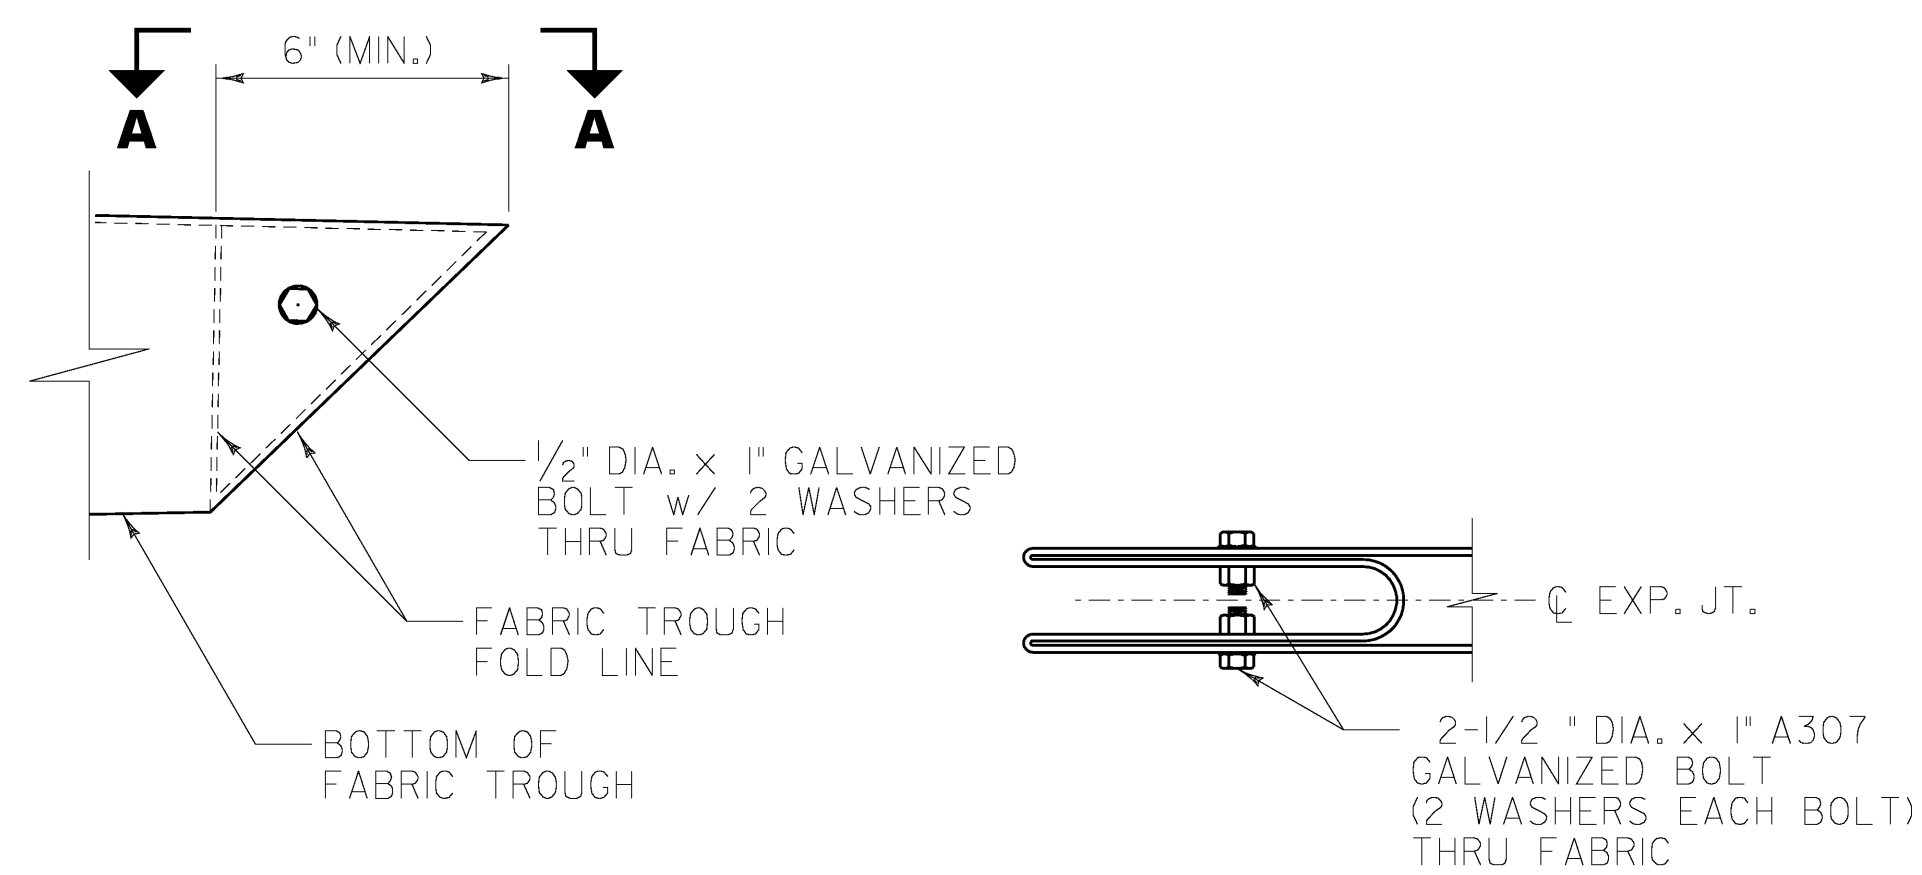

ABUTMENT 2 - DOWNSPOUT FRONT ELEVATION

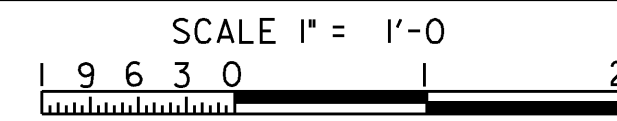

FOLDED TROUGH END DETAILS
NOT TO SCALE

NOTE:
1. FOR TROUGH CUTOUT AND BRACKET DETAILS, REFER TO SHEET 37.

STATE OF VERMONT AGENCY OF TRANSPORTATION		
Town Of	PUTNEY	Bridge No. 19A
Highway No.	U.S. ROUTE 5	Log Sta. Surv. Sta.
U.S. ROUTE 5 OVER I-91		
DOWNSPOUT DETAILS 2		
Designed By	T. KNIGHT	Drawn By R. WALKER
Checked By	T. KNIGHT	Bridge Design Supervisor G. BOGUE Date 06/09
PROJECT	PUTNEY	PROJECT NO. IM 091-(131)
CAD Drawing Name:	...\\Plot Files\38 29381682.dwg 10/19/2009	
Bridge Sheet No.	Sheet 38 of 75	

