


207+98.93  
BEGIN BRIDGE



PROJECT NAME: PUTNEY  
 PROJECT NUMBER: M 091-1(3)  
 FILE NAME: \\S51ST\29348\ndm\thx\p11 PLOT DATE: 10/19/2009  
 PROJECT LEADER: G. BOGUE DRAWN BY: E. ALLING  
 DESIGNED BY: E. ALLING CHECKED BY: G. GOYETTE  
**MAINLINE SECTIONS 2** SHEET 54 OF 15

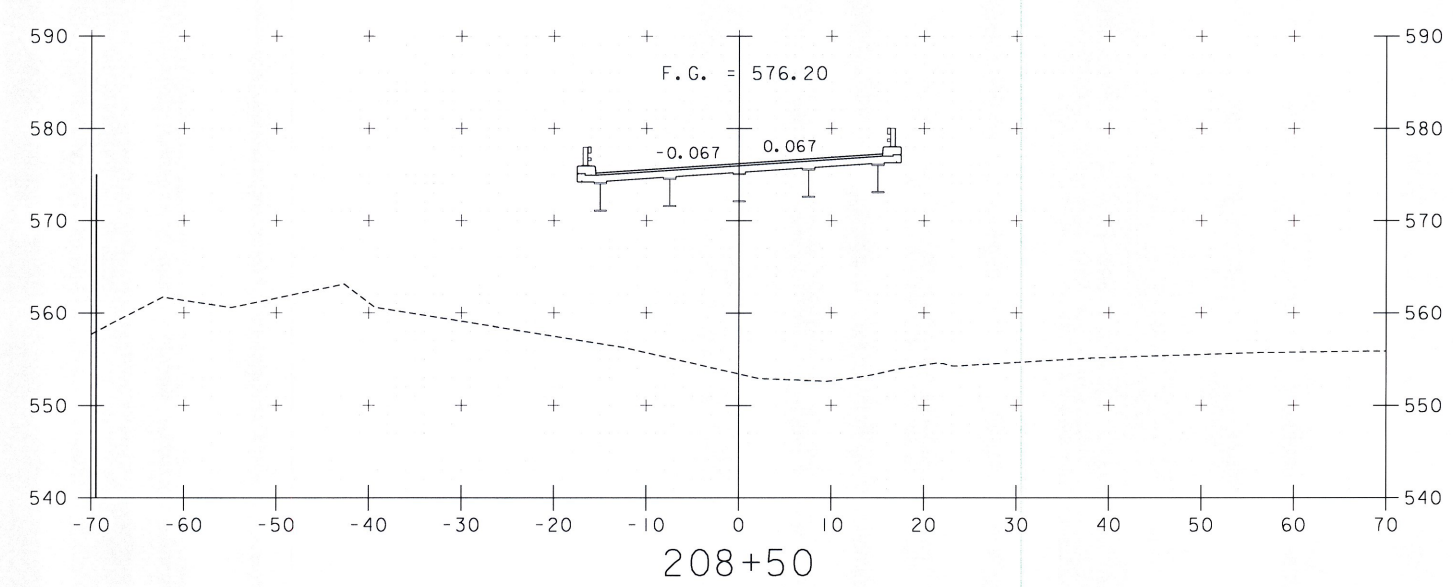