



213+50
BEGIN COLD PLANING / END APPROACH

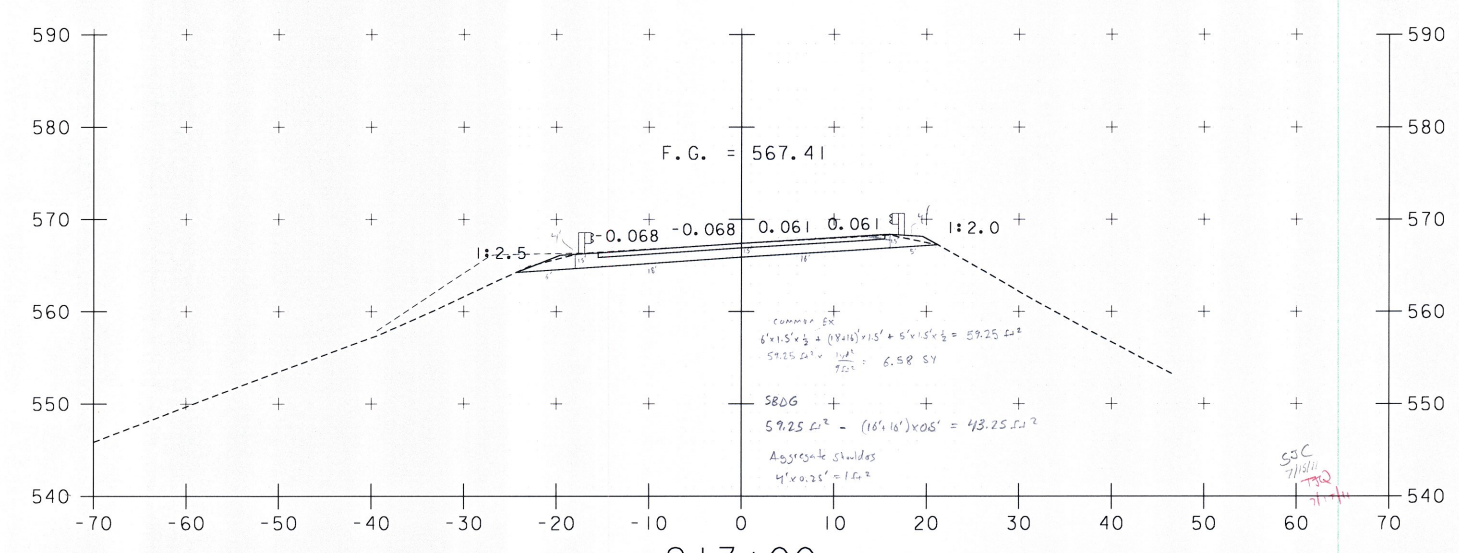


213+00

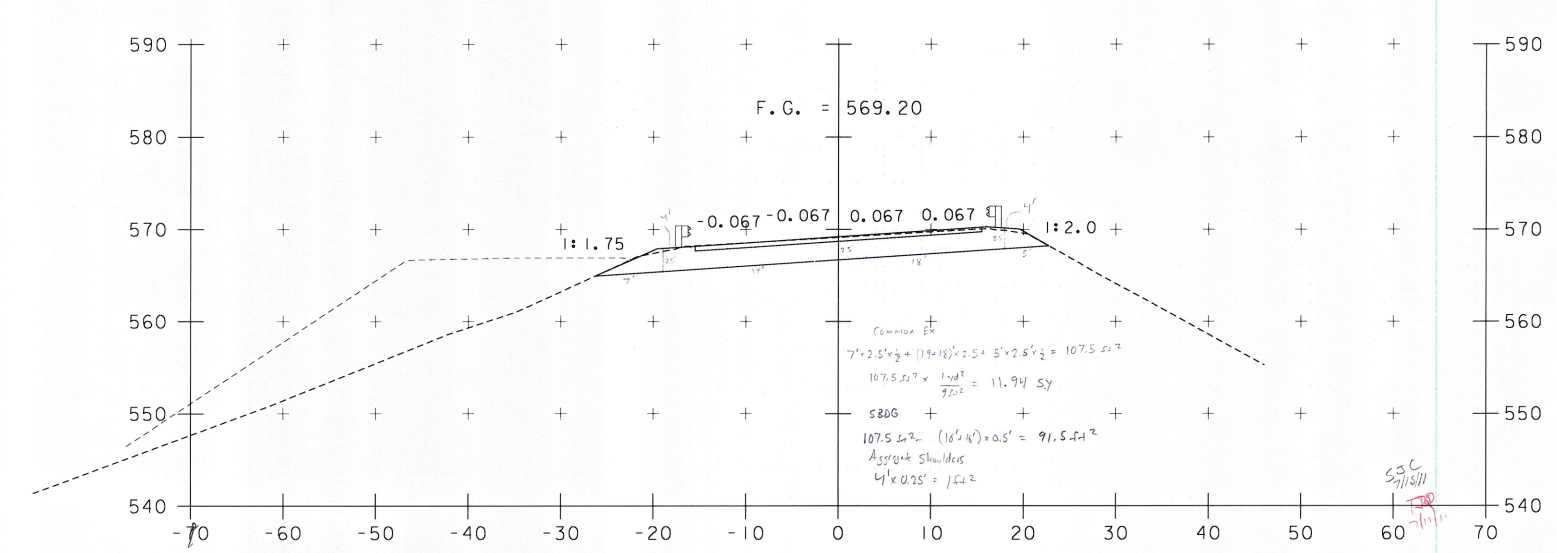

212+50
END PROJECT / BEGIN APPROACH

214+00
END COLD PLANING

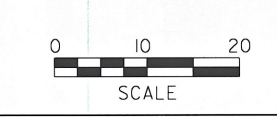

PROJECT NAME: PUTNEY
 PROJECT NUMBER: M 091-(33)
 FILE NAME: \\S3-57-233448\mainline\p11 PLOT DATE: 10/9/2009
 PROJECT LEADER: G. BODLE DRAWN BY: E. ALLING
 DESIGNED BY: E. ALLING CHECKED BY: G. COFFEE
 MAINLINE SECTIONS 5 SHEET 57 OF 15