


MAINLINE BANKING DIAGRAM



PROJECT NAME: PUTNEY
 PROJECT NUMBER: IM 091-1(31)

FILE NAME: ... \Plot Files\63 z93a148bd.pxf PLOT DATE: 10/19/2009
 PROJECT LEADER: G. BOGUE DRAWN BY: R. WALKER
 DESIGNED BY: E. ALLING CHECKED BY: G. GOYETTE
BANKING DIAGRAM SHEET 63 OF 75

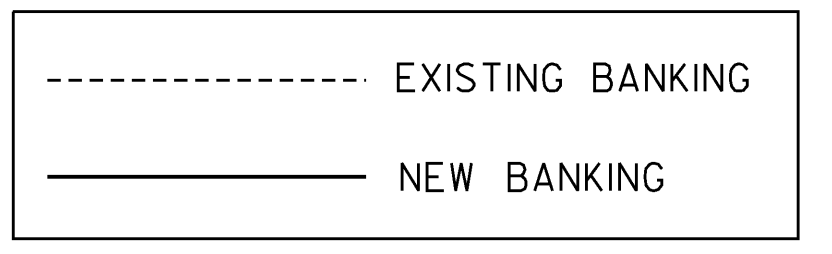