




PLAN VIEW
QTY REQ'D = 5 ASSY.
PIER 2

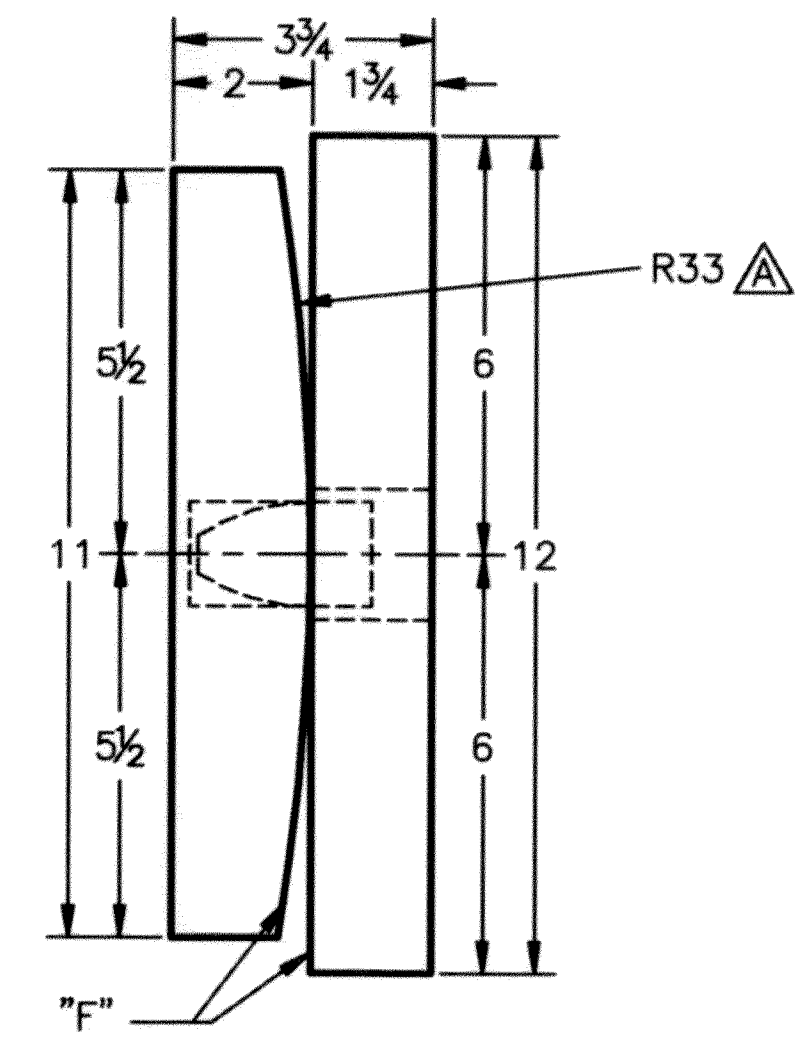

SIDE VIEW

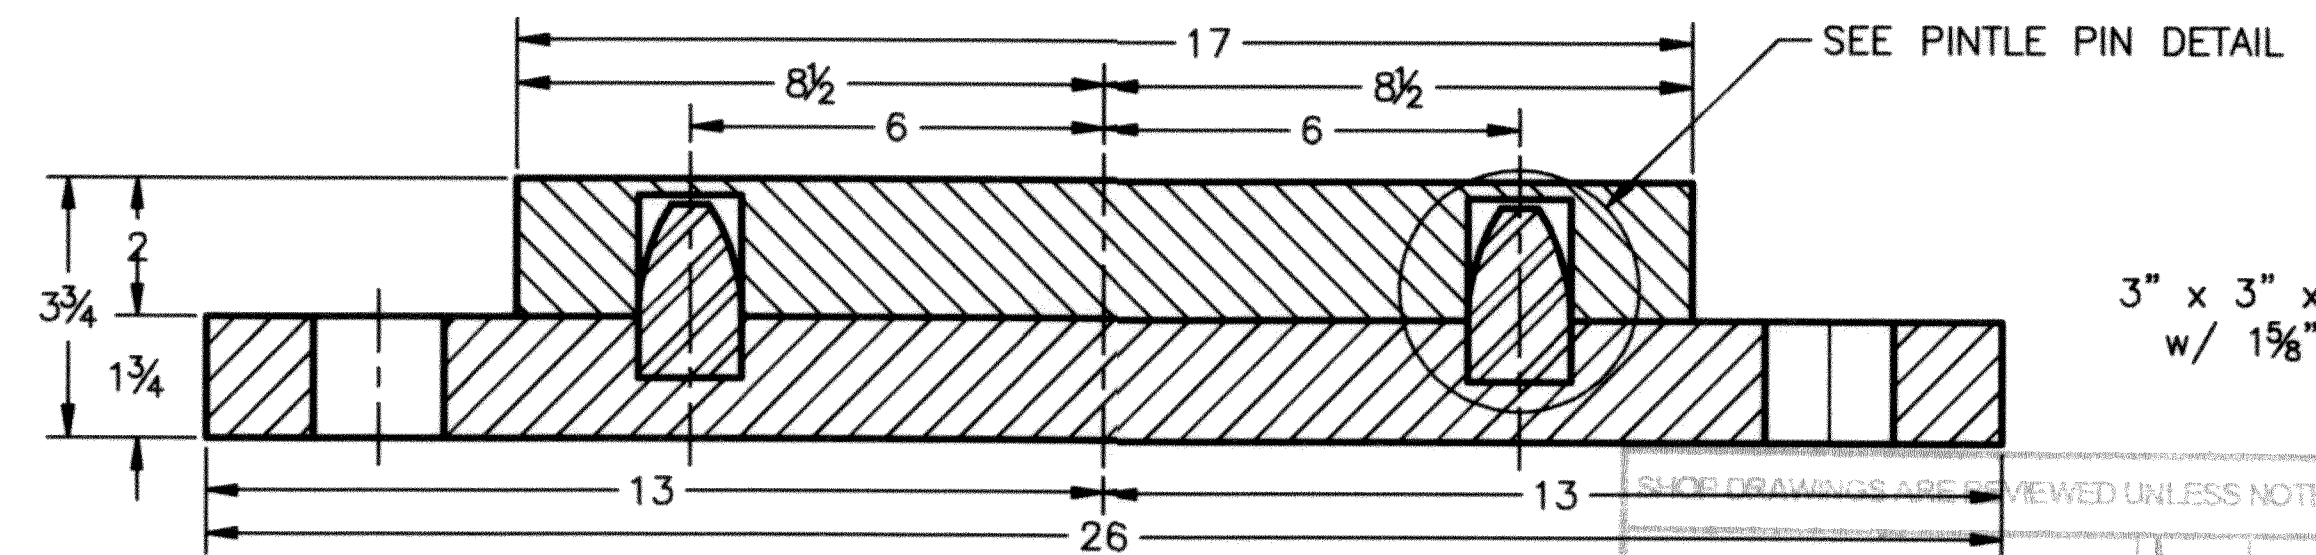

ELEVATION VIEW

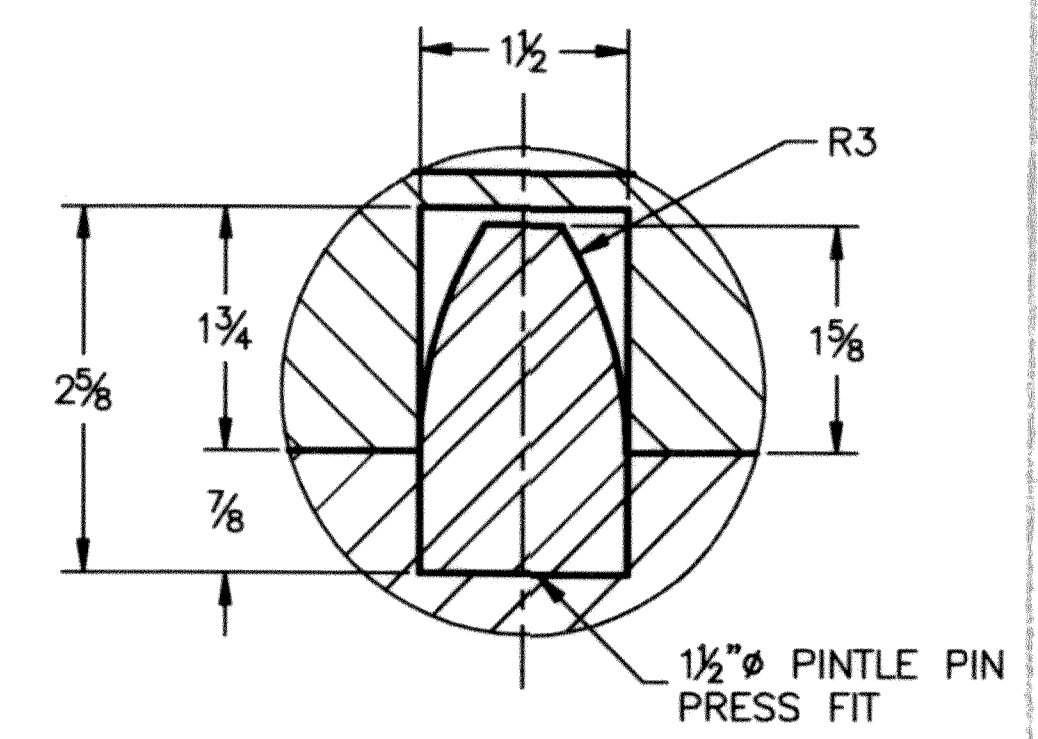

PINTLE PIN DETAIL

NO EXCEPTION TAKEN


REVISIONS:

REVISIONS	NO EXCEPTION TAKEN
REVISIONS	NO EXCEPTION TAKEN
DATE: 2/23/10

SIGNATURE: [Signature]

REVIEW BY STANTEC AS FOR THE SOLE PURPOSE OF ASCERTAINING GENERAL CONFORMITY WITH DESIGN. CONTRACTOR IS RESPONSIBLE FOR DIMENSIONS, FABRICATION AND CONSTRUCTION METHODS, COORDINATION OF SUB-TRADES, DETAIL DESIGN OF COMPONENTS, AND ERRORS OR OMISSIONS ON SHOP DRAWINGS.

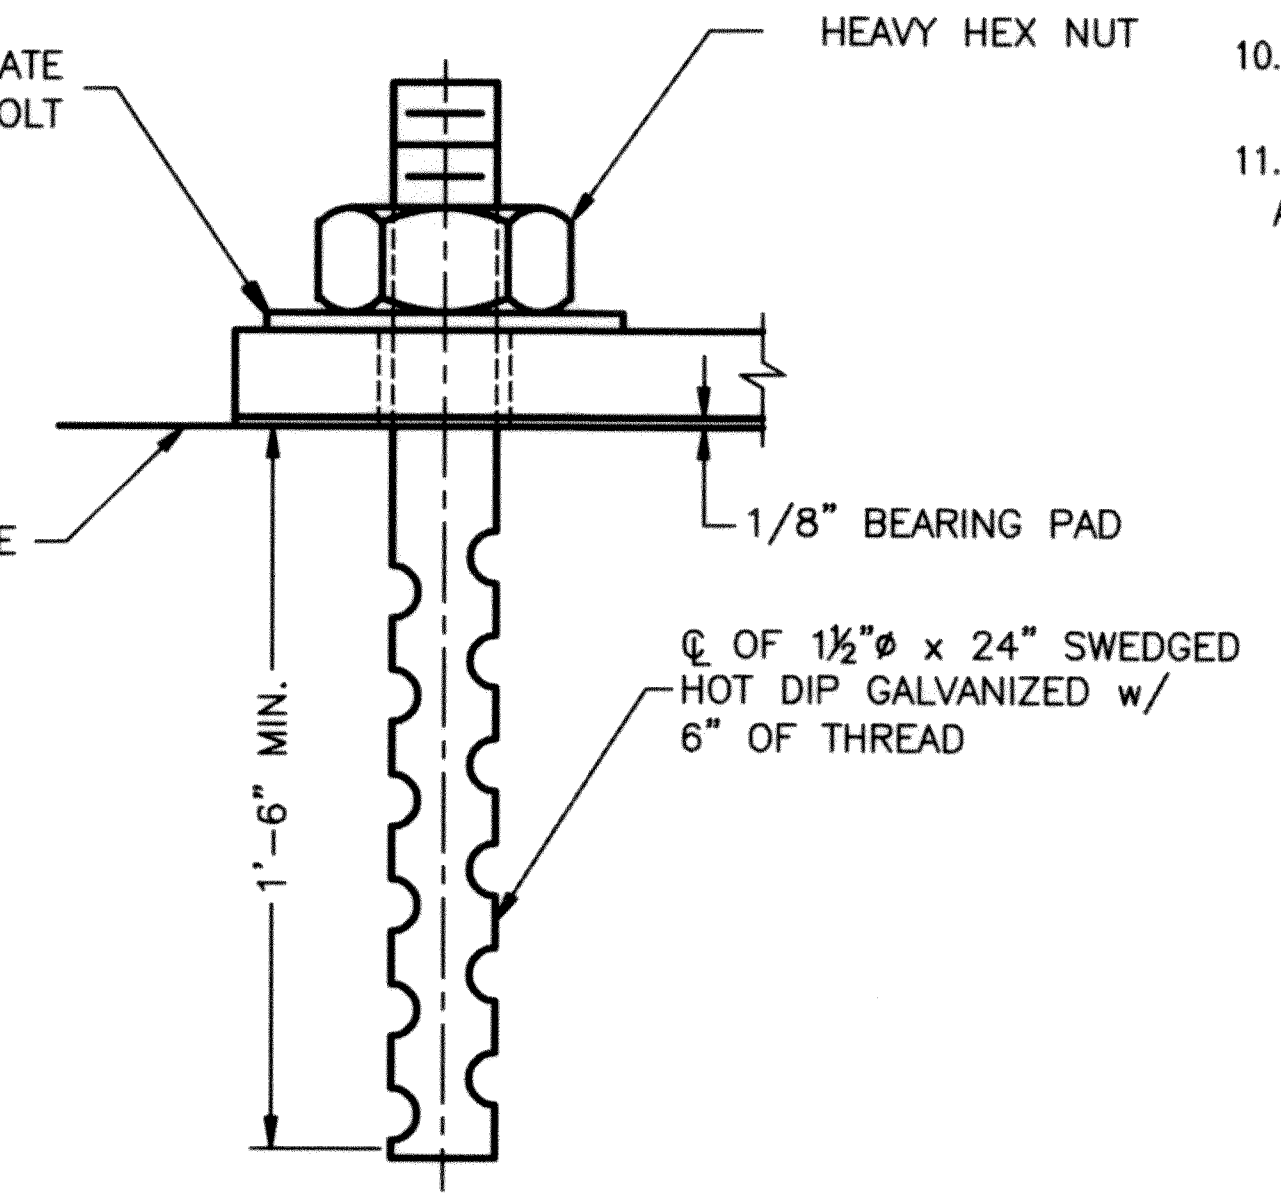

ANCHOR BOLT DETAIL
QTY. REQ'D = 10, 2 PER BEARING

REVISIONS				
ZONE	REV	DESCRIPTION	DATE	APPROVED
-	-	PER ENGINEER'S MARK	2/23/10	C.A.M.

- NOTES:**
- BEARINGS TO BE MANUFACTURED ACCORDING TO AASHTO STANDARD SPECIFICATIONS FOR HIGHWAY BRIDGES, 17th. EDITION, 2002.
 - THE BEARINGS ARE DESIGNED SO THAT THE SUPERSTRUCTURE MAY BE ERECTED WHEN THE AMBIENT AIR TEMPERATURE IS WITHIN THE RANGE OF 20° F. TO 70° F.
 - ALL STEEL IN BEARINGS SHALL BE ASTM A-709 GRADE 36.
 - ALL STEEL PRODUCED IN THE U.S.A.
 - CONTACT PETER SOMOGYI, COORDINATOR.
 - TOLERANCES: THICKNESS -0+1/16"
PLAN -0+1/16"
 - MANUFACTURING FACILITY LOCATION:
AMSCOT STRUCTURAL PRODUCTS INC.
241 EAST BLACKWELL STREET
DOVER, NJ 07801
 - ALL DIMENSIONS ARE IN INCHES.
 - ALL BEARING DEVICES SHALL BE GALVANIZED AS PER STANDARD SPECIFICATIONS 506.15 AND 531.04(b), AS MODIFIED BY THE GENERAL SPECIAL PROVISIONS.
 - ALL ANCHOR BOLTS, NUTS AND WASHERS SHALL BE GALVANIZED.
 - BEARING SURFACES MARKED "F" SHALL BE FINISH IN ACCORDANCE WITH AASHTO DIVISION II, SECTION 11.4.6.

**VERMONT AGENCY OF TRANSPORTATION
PROPOSED IMPROVEMENT BRIDGE PROJECT
TOWN OF PUTNEY, COUNTY OF WINDHAM
US RT. 5 FAS (MAJOR COLLECTOR), BRIDGE 19A**

STEEL ROCKER BEARING DETAIL

AMSCOT
STRUCTURAL PRODUCTS CORP.
DOVER, NJ JOB # 3383

SCALE: N.T.S.	CHECKED: B.F.	DRAWN BY: C.A.M.
DATE: 1/29/10		REVISION: A

FOR: J.A. McDONALD, INC.

DWG NO: JAM10A1RA SHEET NO. 1 OF 3