

INDEX OF SHEETS:
SEE SHEET 2

STATE OF VERMONT AGENCY OF TRANSPORTATION



PROPOSED IMPROVEMENT BRIDGE PROJECT



TOWN OF PUTNEY
COUNTY OF WINDHAM

ROUTE NO.: U.S. ROUTE 5 FAS (MAJOR COLLECTOR), BRIDGE 19A


PROJECT LOCATION: BEGINNING AT A POINT ON U.S. ROUTE 5 APPROXIMATELY 0.07 MILES NORTH OF THE INTERSECTION WITH TOWN HIGHWAY 65 (TAYLOR ROAD) AND PROCEEDING NORTHERLY FOR 0.10 MILE.

PROJECT DESCRIPTION: REPLACEMENT OF THE EXISTING BRIDGE DECK, GUARDRAIL, CURB, STEEL BEAMS AND PIER CAPS INCLUDING ABUTMENT CURTAIN WALLS, BRIDGE SEATS, APPROACH SLABS AND ALL EXISTING APPROACH PAVEMENT. INSTALLATION/REMOVAL OF TEMPORARY BRIDGE AND DETOUR.

LENGTH OF STRUCTURE = 336.00 FEET
LENGTH OF ROADWAY = 214.00 FEET
LENGTH OF PROJECT = 550.00 FEET

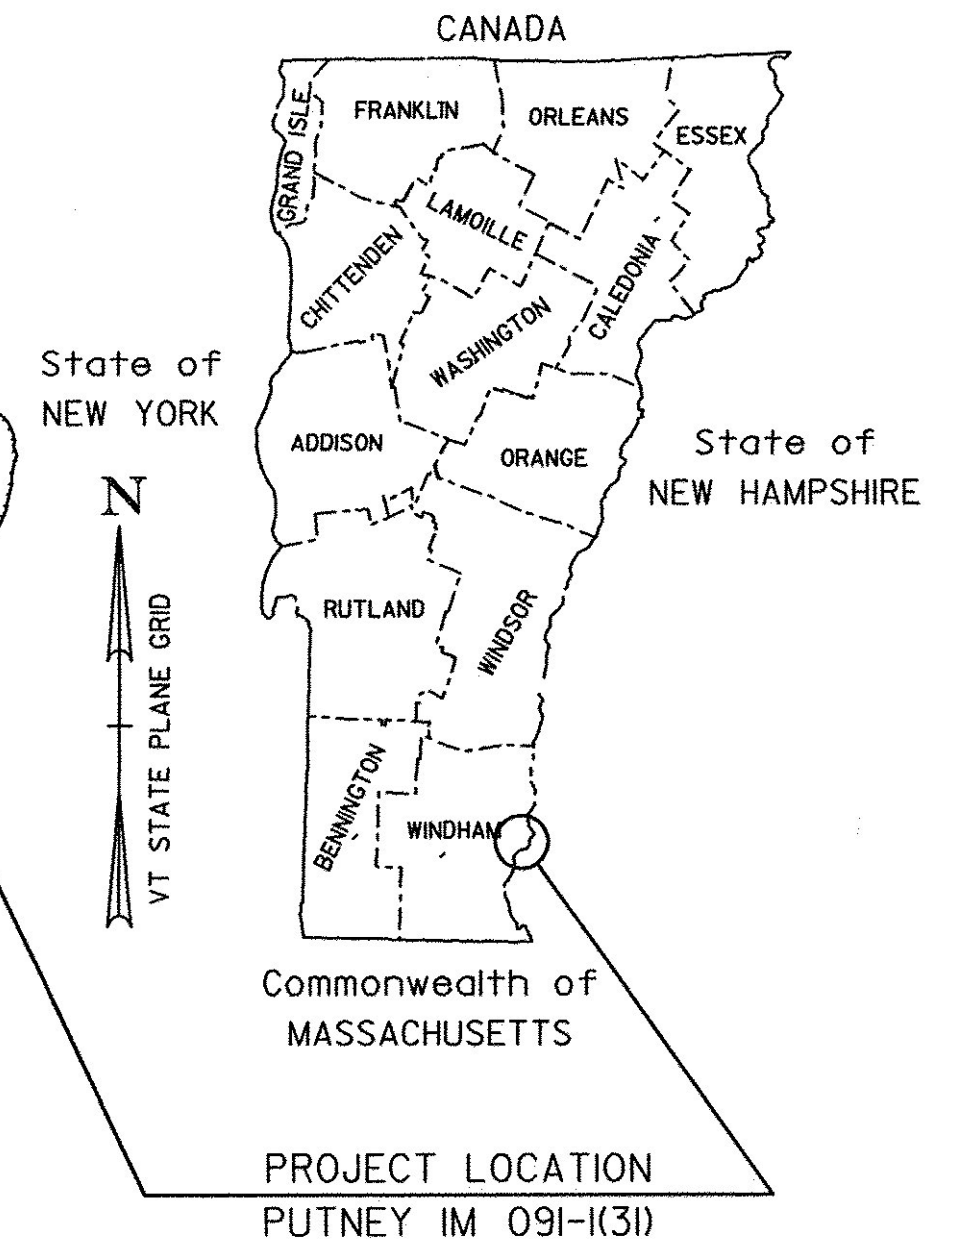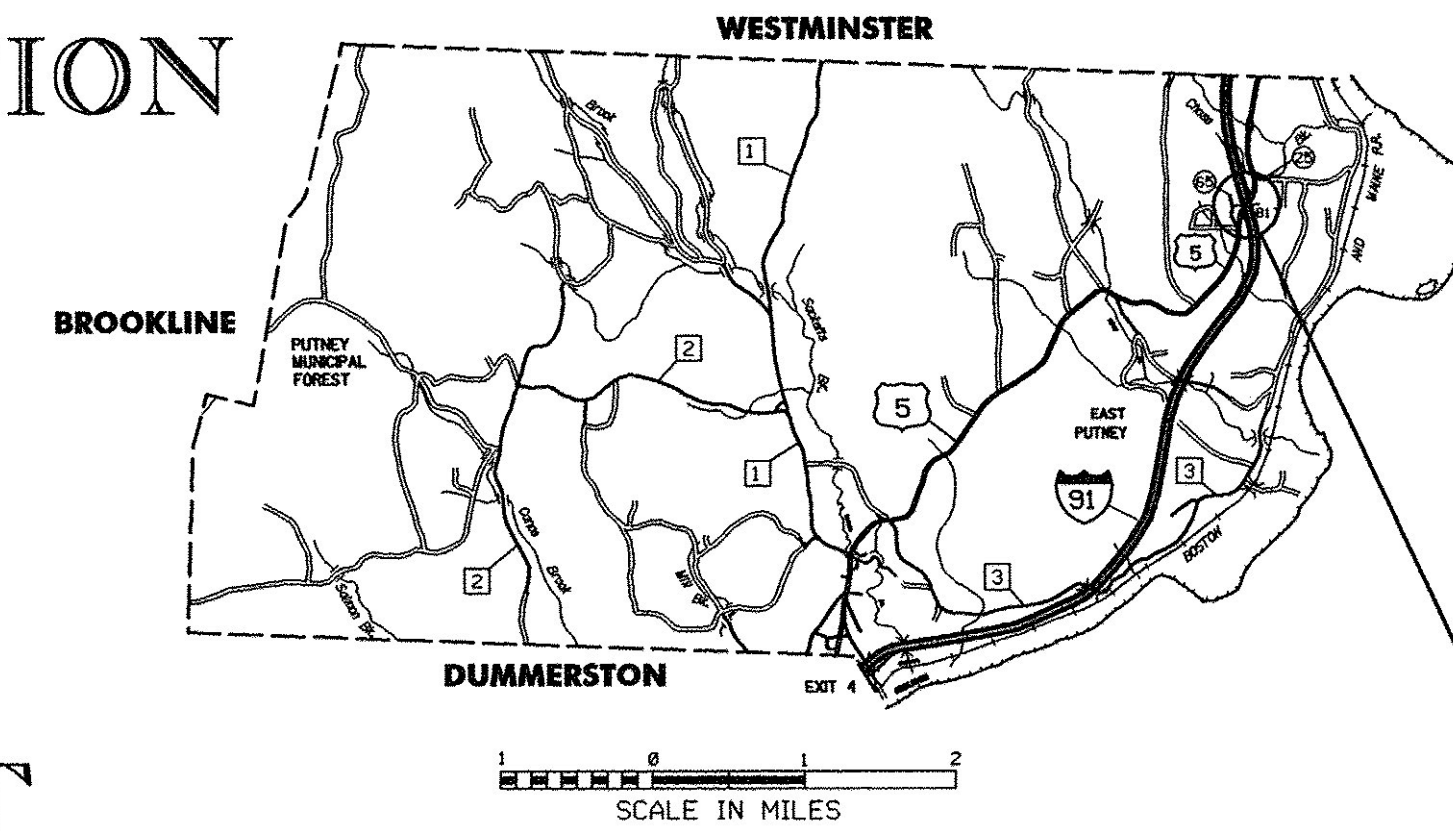


RECORD PLANS	
CONTRACTOR:	J. A. McDONALD INC. - LYNDON CENTER, VT
RESIDENT ENGINEER:	DARYL BASSETT
CONSTRUCTION BEGAN:	MARCH 1, 2010
CONSTRUCTION COMPLETE:	JUNE 22, 2011
RECORD PLANS BY:	DARYL BASSETT & JENNA HYDE
I HEREBY CERTIFY THAT ALL THE CONSTRUCTION REQUIRED BY THIS SET OF DRAWINGS HAS BEEN ACCOMPLISHED AS INDICATED HEREIN.	
BY:	<i>Daryl Bassett</i> RESIDENT ENGINEER
DATE:	10/2/12
NOTE: Any further information concerning final quantities, amounts or other details relative to this project may be found at Central Files in the electronic archives.	

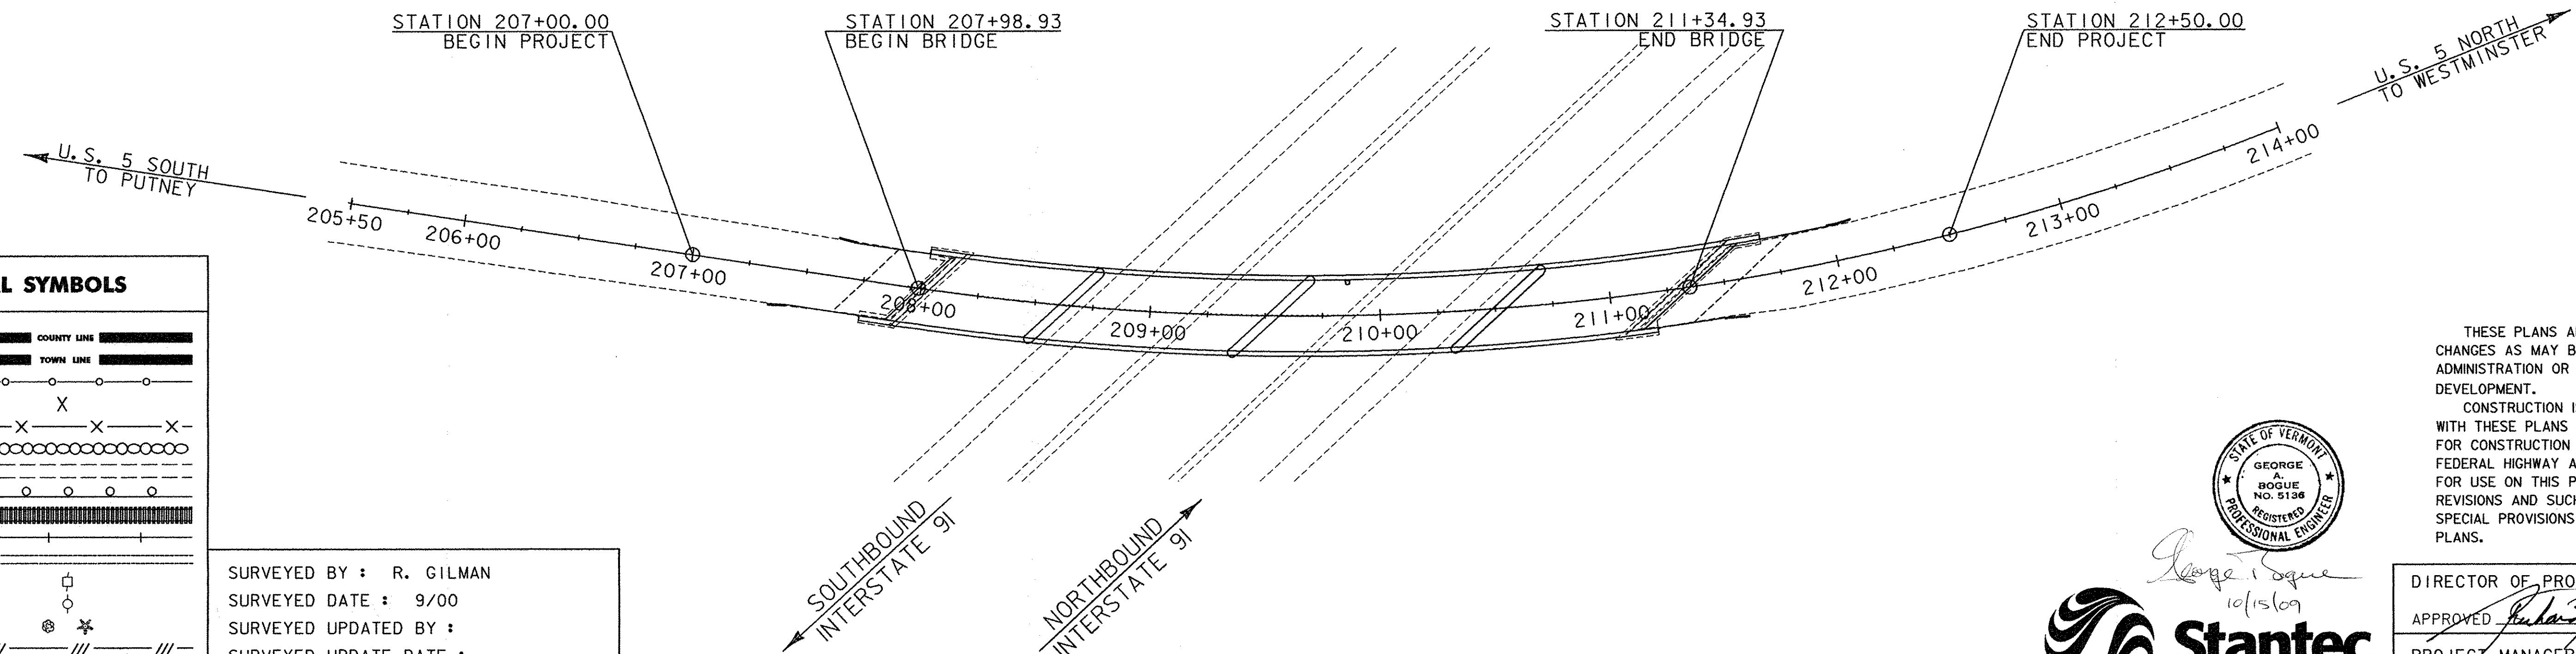


CONVENTIONAL SYMBOLS	
COUNTY LINE	
TOWN LINE	
LIMITS OF ACCESS	
POINT OF ACCESS	
FENCE LINE	
STONE WALL	
TRAVELED WAY	
GUARD RAIL	
RAILROAD	
SURVEY LINE	
CULVERT	
POWER POLE	
TELEPHONE POLE	
TREES	
CONTROL OF ACCESS	
PROPERTY LINE	
R.O.W. TAKING LINE	
SLOPE RIGHTS	
TOP OF CUT	
TOE OF SLOPE	

SURVEYED BY : R. GILMAN
SURVEYED DATE : 9/00
SURVEYED UPDATED BY :
SURVEYED UPDATE DATE :
DATUM
VERTICAL NAVD 88
HORIZONTAL NAD 83 (96)

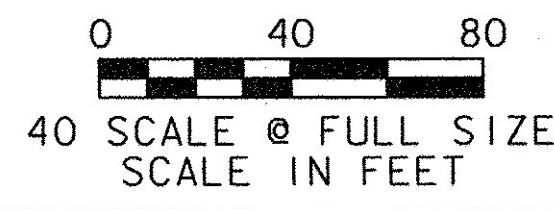

George A. Rogue
10/15/09
Stantec
Stantec Consulting Services Inc.
55 Green Mountain Drive
South Burlington VT U.S.A. 05403
Tel. 802.864.0223
Fax. 802.864.0165
www.stantec.com

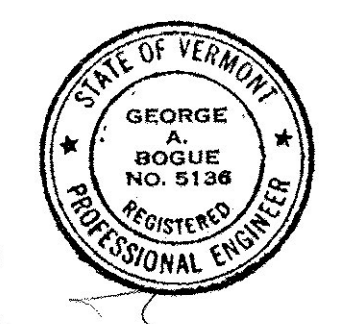

THESE PLANS ARE SUBJECT TO SUCH ENGINEERING CHANGES AS MAY BE REQUIRED BY THE FEDERAL HIGHWAY ADMINISTRATION OR THE DIRECTOR OF PROGRAM DEVELOPMENT.
CONSTRUCTION IS TO BE CARRIED ON IN ACCORDANCE WITH THESE PLANS AND THE STANDARD SPECIFICATIONS FOR CONSTRUCTION DATED 2006, AS APPROVED BY THE FEDERAL HIGHWAY ADMINISTRATION ON JUNE 15, 2006 FOR USE ON THIS PROJECT, INCLUDING ALL SUBSEQUENT REVISIONS AND SUCH REVISED SPECIFICATIONS AND SPECIAL PROVISIONS AS ARE INCORPORATED IN THESE PLANS.

DIRECTOR OF PROGRAM DEVELOPMENT
APPROVED: *Sherward Farnsworth* DATE 10-20-09
PROJECT MANAGER : SHERWARD FARNSWORTH
PROJECT NAME : PUTNEY
PROJECT NUMBER : IM 091-1 (31)
SHEET 1 OF 75 SHEETS