


NOTES:
 1. ELEVATIONS SHOWN TO THE NEAREST TENTH ARE EXISTING GROUND ALONG CENTERLINE
 2. ELEVATIONS SHOWN TO THE NEAREST HUNDREDTH ARE FINISH GRADE ALONG CENTERLINE

MAINLINE PROFILE



PROJECT NAME: PUTNEY	PLOT DATE: 7/8/2009
PROJECT NUMBER: IM 091-1(31)	DRAWN BY: E. ALLING
FILE NAME: ...\\IO z93ql48 pro l.pxf	CHECKED BY: G. GOYETTE
PROJECT LEADER: G. BOGUE	SHEET 10 OF 75
DESIGNED BY: E. ALLING	
MAINLINE PROFILE 1	

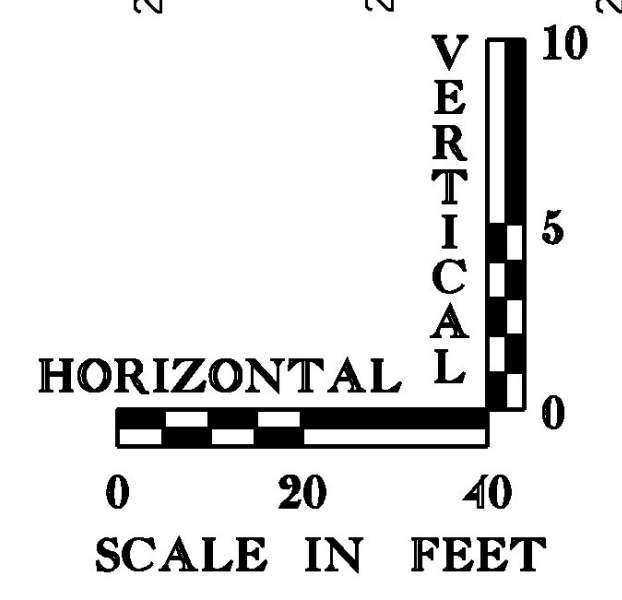