


MAINLINE PROFILE



PROJECT NAME: PUTNEY	PROJECT NUMBER: IM 091-(31)
FILE NAME: ...\\z93a148 pro 2.pxf	PLOT DATE: 7/8/2009
PROJECT LEADER: G. BOGUE	DRAWN BY: E. ALLING
DESIGNED BY: E. ALLING	CHECKED BY: G. GOYETTE
MAINLINE PROFILE 2	SHEET 11 OF 75

NOTES:
 1. ELEVATIONS SHOWN TO THE NEAREST TENTH ARE EXISTING GROUND ALONG CENTERLINE
 2. ELEVATIONS SHOWN TO THE NEAREST HUNDREDETH ARE FINISH GRADE ALONG CENTERLINE

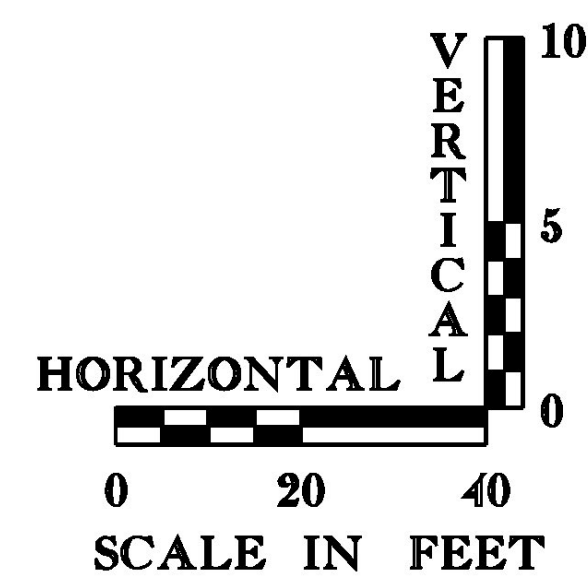