


NOTES:

1. ELEVATIONS SHOWN TO THE NEAREST TENTH ARE EXISTING GROUND ALONG CENTERLINE.
2. ELEVATIONS SHOWN TO THE NEAREST HUNDREDTH ARE FINISH GRADE ALONG CENTERLINE.

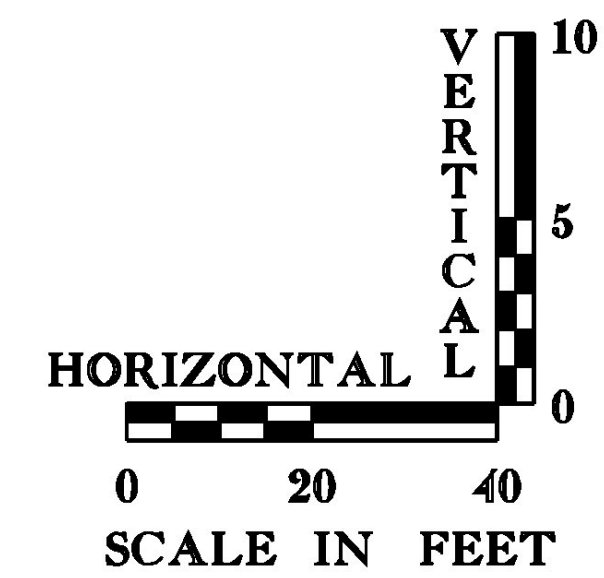

PROJECT NAME: PUTNEY
PROJECT NUMBER: IM 091-(131)

FILE NAME: ...N2 z93d48 pro temp_detour.plt PLOT DATE: 7/8/2009
PROJECT LEADER: G. BOGUE DRAWN BY: E. ALLING
DESIGNED BY: E. ALLING CHECKED BY: G. GOYETTE
TEMPORARY DETOUR PROFILE 1 SHEET 12 OF 75