


403+75	580.2
	580.36
404+00	579.4
	579.42
404+25	578.5
	578.47
404+50	577.5
	577.53
404+75	576.5
	576.59
405+00	575.5
	575.64
405+25	574.6
	574.70
405+50	573.6
	573.80
405+75	572.7
	572.99
406+00	571.6
	572.28
406+25	570.2
	571.65
406+50	567.1
	571.12
406+75	563.6
	570.68
407+00	562.5
	570.33
407+25	561.2
	570.08
407+50	559.3
	569.86

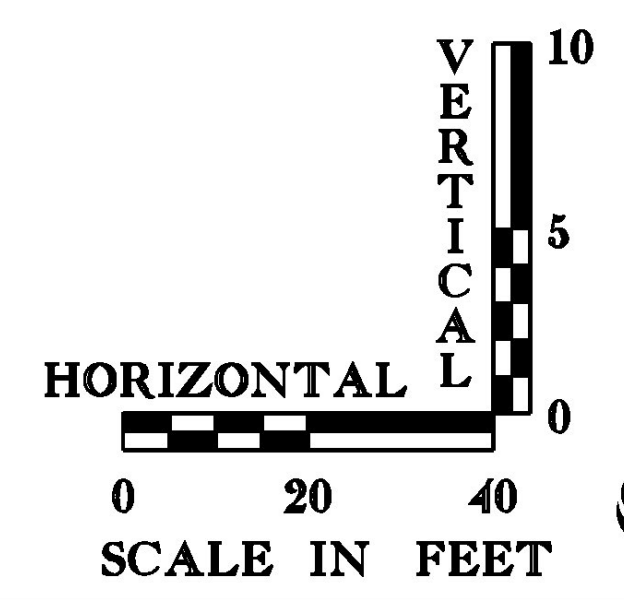

PROJECT NAME: PUTNEY  
 PROJECT NUMBER: IM 091-(131)

FILE NAME: ...N3 z93oi48 pro temp\_detour2.dwg DATE: 7/8/2009  
 PROJECT LEADER: G. BOGUE DRAWN BY: E. ALLING  
 DESIGNED BY: E. ALLING CHECKED BY: G. GOYETTE  
**TEMPORARY DETOUR PROFILE 2** SHEET 13 OF 75