


NOTES:

1. THESE PLANS SHOW A CONCEPTUAL EROSION CONTROL PLAN, THE CONTRACTOR MUST SUBMIT A TEMPORARY EROSION CONTROL PLAN FOR APPROVAL.
2. TEMPORARY EROSION CONTROL MEASURES ARE CONCEPTUALLY SHOWN, THE CONTRACTOR MAY RELOCATE TEMPORARY MEASURES TO IMPROVE EROSION CONTROL WITH APPROVAL OF THE RESIDENT ENGINEER AND ON SITE COORDINATOR. SILT FENCE SHALL NOT BE INSTALLED ACROSS CONTOURS.
3. THE CONTRACTOR SHALL USE OTHER TEMPORARY EROSION CONTROL MEASURES AS NECESSITATED BY THE SEQUENCE OF CONSTRUCTION OR AS DIRECTED BY THE RESIDENT ENGINEER AND ON SITE COORDINATOR.
4. REFER TO TEMPORARY EROSION CONTROL DETAIL SHEETS FOR ADDITIONAL DETAILS.
5. SEE TEMPORARY DETOUR CROSS-SECTIONS FOR TEMPORARY STONE LINED DITCH DETAILS. PAYMENT SHALL BE MADE UNDER ITEM 900.640 SPECIAL PROVISION (TEMPORARY SWALE).
6. PAYMENT TO REMOVE PIPE AND HEADWALL FOR CONSTRUCTION OF TEMPORARY BRIDGE APPROACH SHALL BE INCIDENTAL TO ITEM 528.JI.

LEGEND	
	SEED AND MULCH
	VEHICLE TRACKING PAD
	TEMPORARY EROSION MATTING
	STONE & BLOCK DROP INLET PROTECTION
	FILTER FABRIC DROP INLET PROTECTION
	SILT FENCE
	PROJECT DEMARCATION FENCE
	TEMPORARY STONE CHECK DAM, TYPE I
	CLEARING LIMITS, TYP.

EPSC CONSTRUCTION SITE PLAN

PROJECT NAME: PUTNEY
 PROJECT NUMBER: IM-091-1(31)
 FILE NAME: ...\\Plot Files\16 z93a148ero 2.plt PLOT DATE: 7/8/2009
 PROJECT LEADER: G. BOGUE DRAWN BY: E. ALLING
 DESIGNED BY: E. ALLING CHECKED BY: G. GOYETTE
EPSC CONSTRUCTION SITE PLAN SHEET 16 OF 75

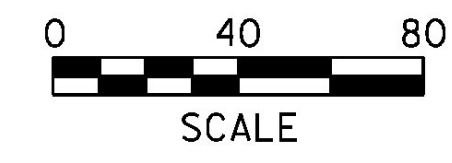

THIS SHEET IS FOR EROSION PREVENTION AND SEDIMENT CONTROL ONLY

