

TEMPORARY CONSTRUCTION LIMITS (TYP.)

CONSTRUCT 3' DEEP X 10' WIDE TOPSOIL TRENCH STA. 404+63, 33' RT TO 407+07, 52' LT SEE NOTE 2

REMOVE TEMPORARY BRIDGE APPROACH

REPLACE PIPE AND HEADWALL SEE NOTE 1

RESTORE DITCH TO ORIGINAL CONDITION WITH TOPSOIL, SEED AND TEMPORARY EROSION MATTING

REMOVE TEMPORARY BRIDGE APPROACH

RESTORE DITCH TO ORIGINAL GRADE WITH TOPSOIL, SEED AND TEMPORARY EROSION MATTING

U.S. ROUTE 5 TO PUTNEY

U.S. ROUTE 5 TO WESTMINSTER

LEGEND


- TOPSOIL, SEED AND TEMPORARY EROSION MATTING
- TOPSOIL, SEED AND MULCH
- 1'-0" STONE FILL, TYPE I
- CLEARING LIMITS
- PROPOSED CONTOUR
- TEMPORARY CONSTRUCTION LIMITS

NOTES:

1. SEE CROSS-SECTION SHEETS FOR CHANGES IN GRADE.
2. GRADE SLOPES AROUND TOPSOIL TRENCH TO BE 1:4.

EPSC FINAL STABILIZATION SITE PLAN

PROJECT NAME:	PUTNEY		
PROJECT NUMBER:	IM-091-1(31)		
FILE NAME:	...Plot Files\17 z93a148ero 3.plt	DATE:	7/8/2009
PROJECT LEADER:	G. BOGUE	DRAWN BY:	E. ALLING
DESIGNED BY:	E. ALLING	CHECKED BY:	G. GOYETTE
EPSC FINAL STABILIZATION PLAN		SHEET 17 OF 75	

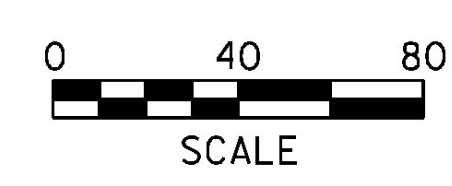

THIS SHEET IS FOR EROSION PREVENTION AND SEDIMENT CONTROL ONLY

