



END COLD PLANING / BEGIN APPROACH

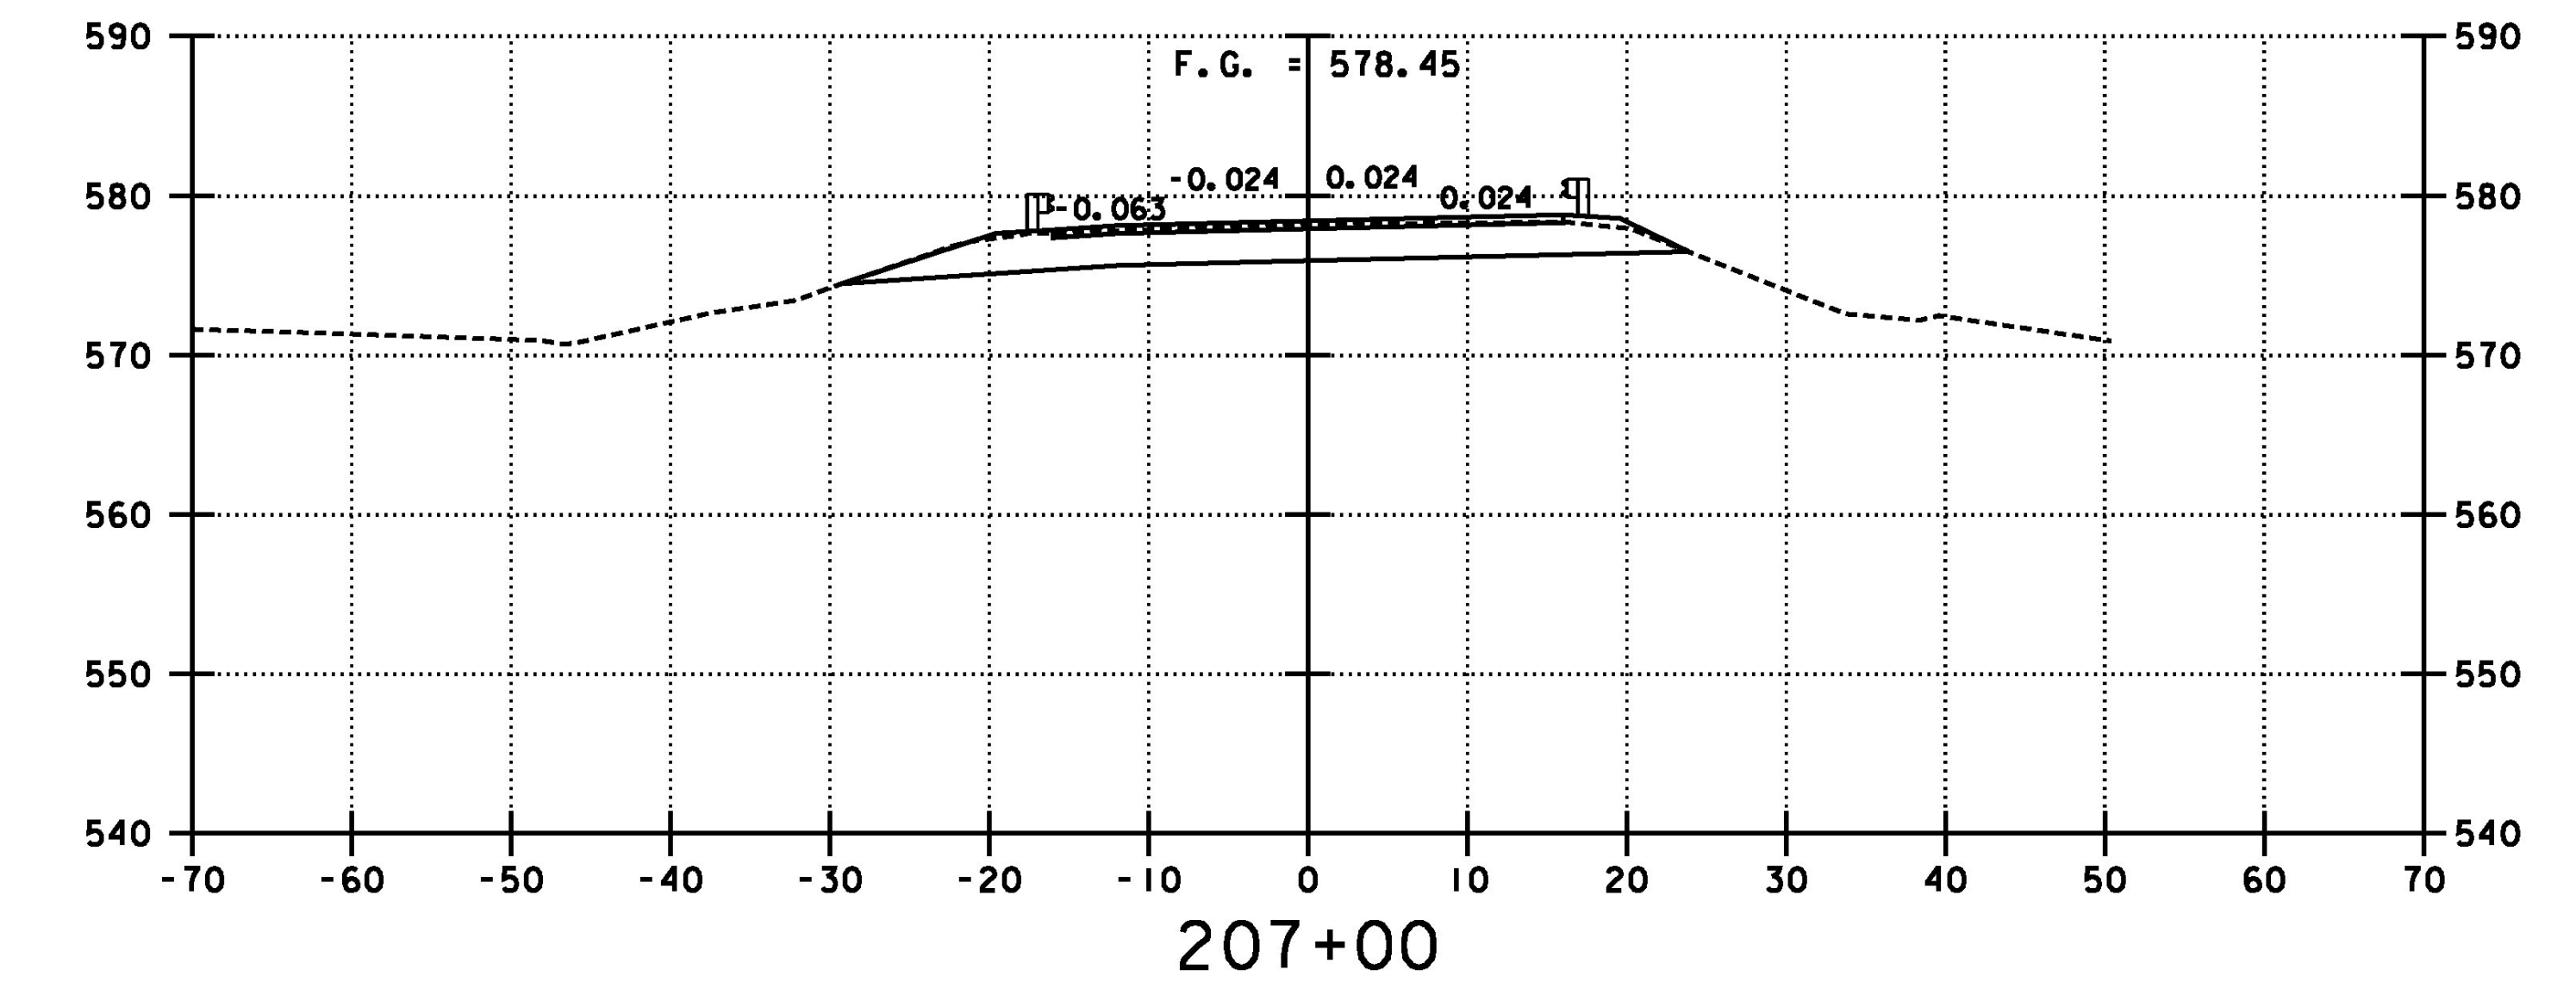

END APPROACH / BEGIN PROJECT

205+50
BEGIN COLD PLANING

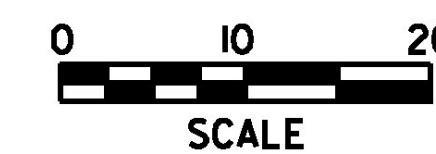

PROJECT NAME: PUTNEY	PLOT DATE: 7/8/2009
PROJECT NUMBER: IM 091-(31)	DRAWN BY: E. ALLING
FILE NAME: ...drawing\z93al48xs.dgn	CHECKED BY: G. GOYETTE
PROJECT LEADER: G. BOGUE	SHEET 53 OF 75
DESIGNED BY: E. ALLING	
MAINLINE SECTIONS	