


402+50

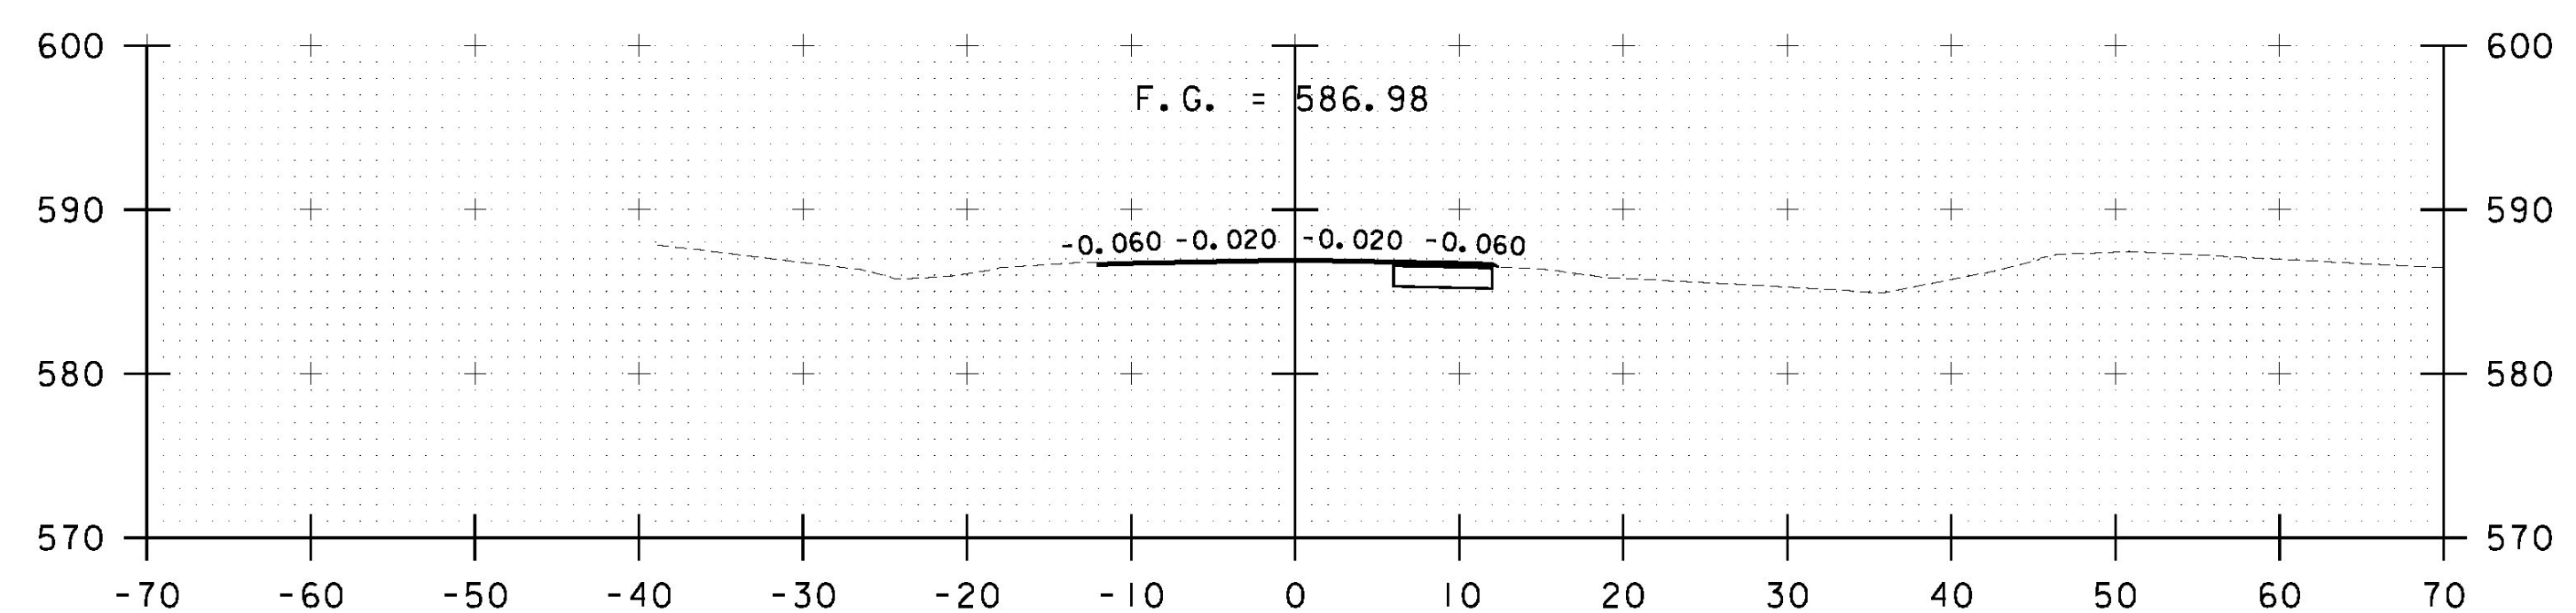

402+00

STA. 400+00 TO STA. 402+50

PROJECT NAME:	PUTNEY		
PROJECT NUMBER:	IM 091-1(31)		
FILE NAME:	...58-62 z93cl48tempdetourxs.plt	DATE:	7/8/2009
PROJECT LEADER:	G. BOGUE	DRAWN BY:	E. ALLING
DESIGNED BY:	E. ALLING	CHECKED BY:	G. GOYETTE
TEMPORARY DETOUR SECTIONS		SHEET	58 OF 75

