




404+00

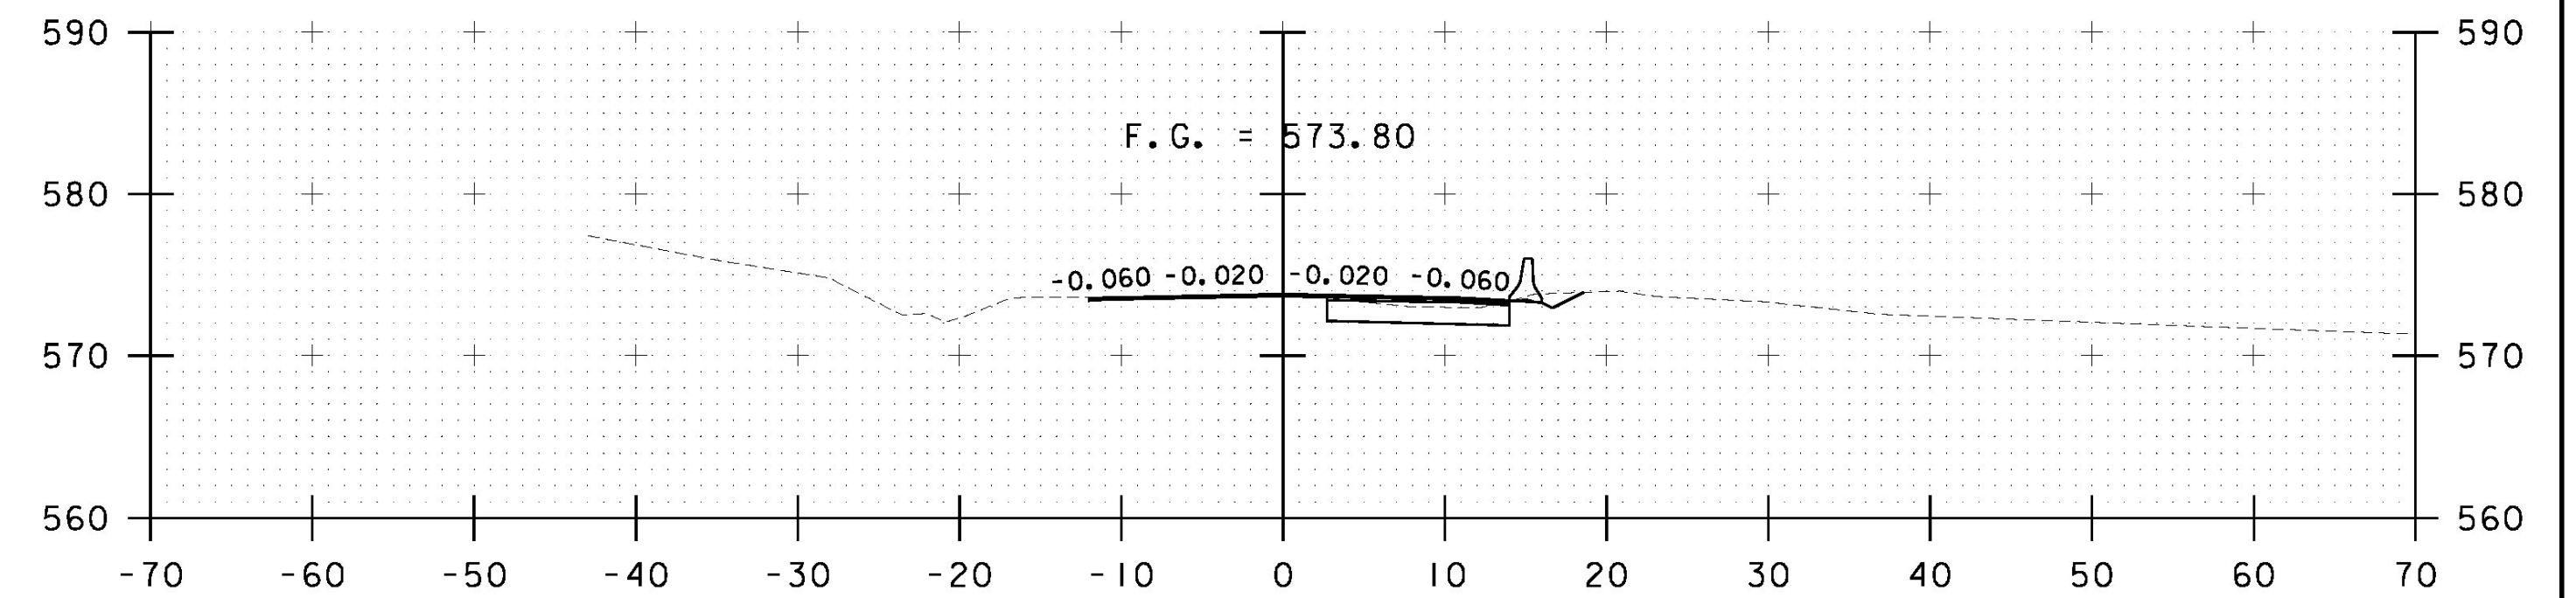


405+50

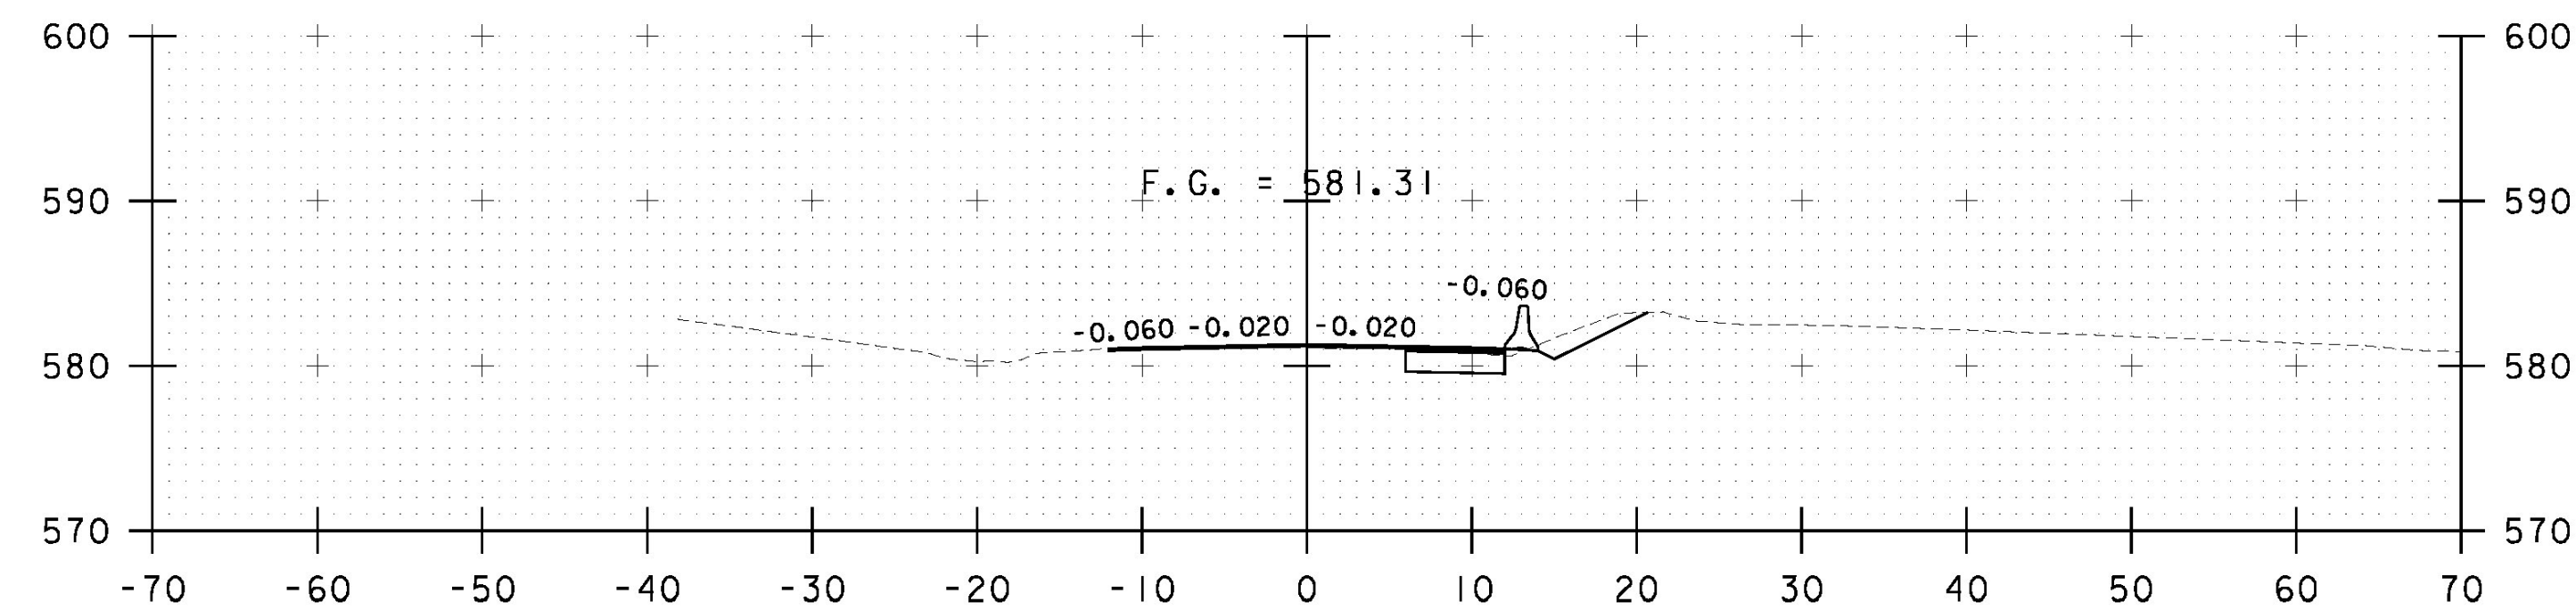


403+50

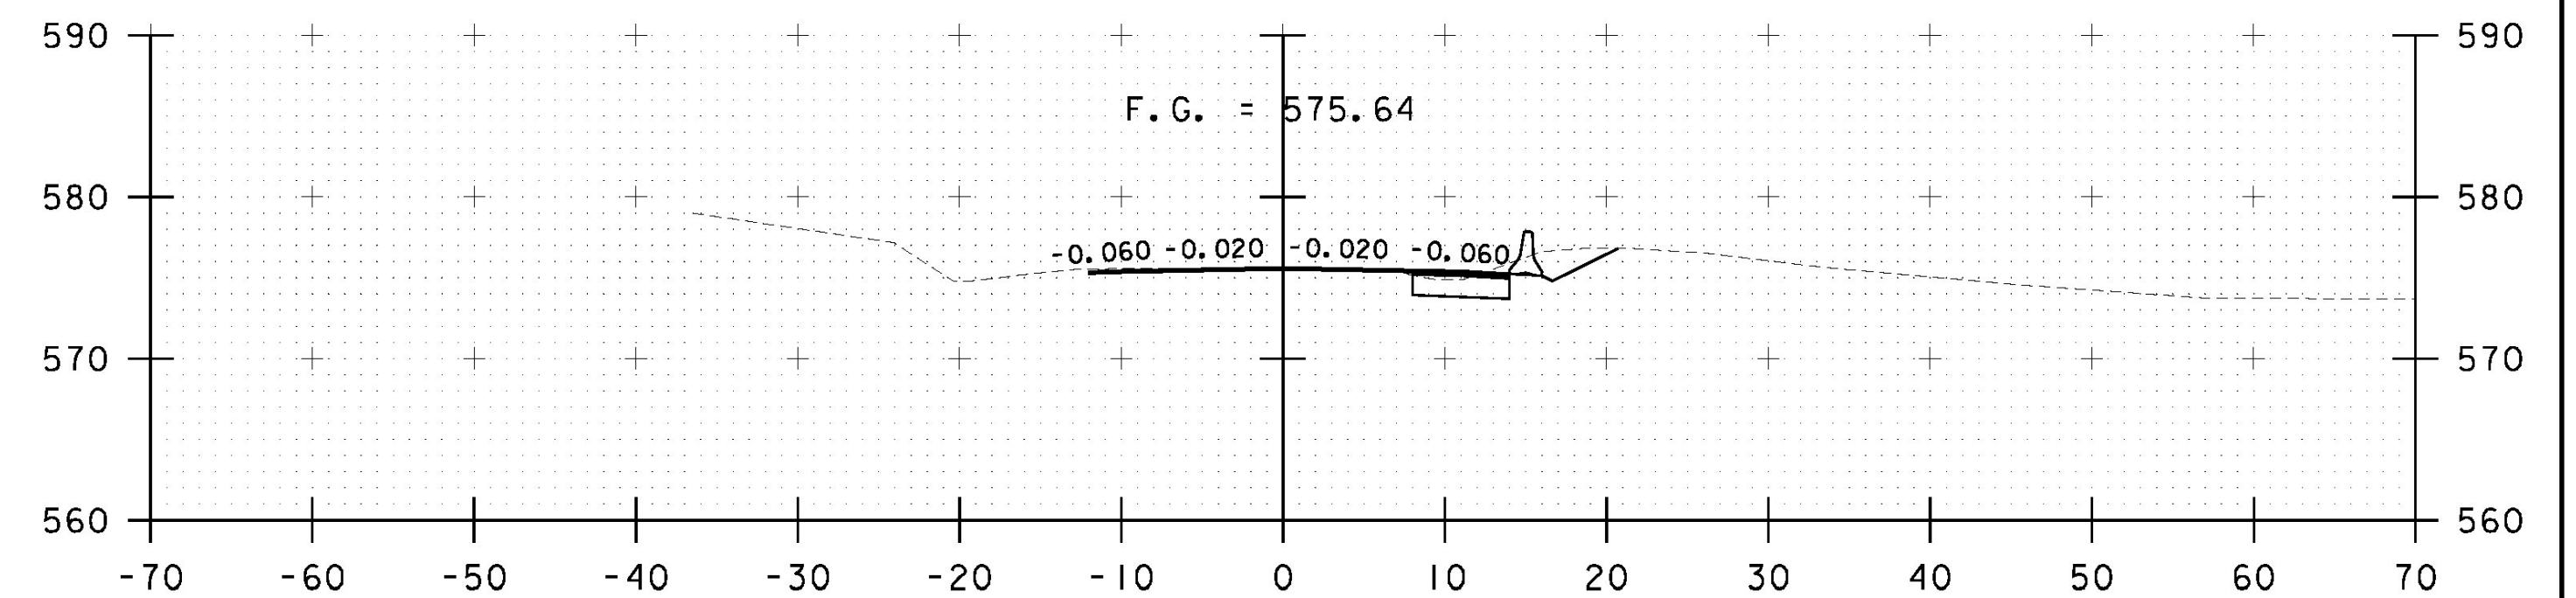

405+00

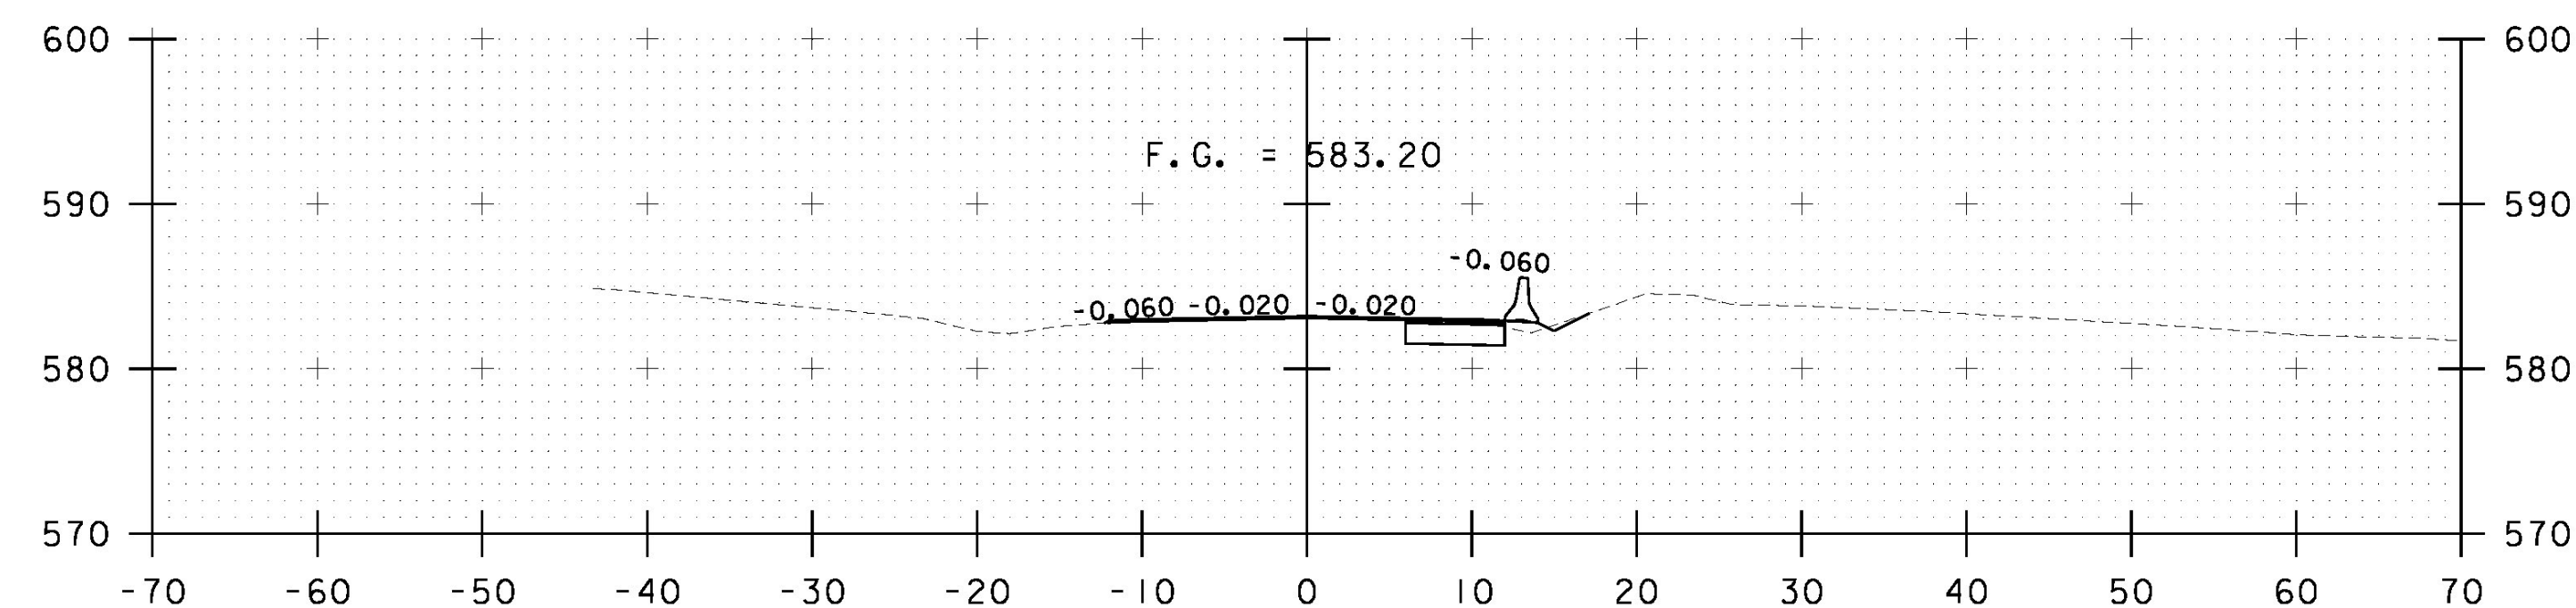

403+00

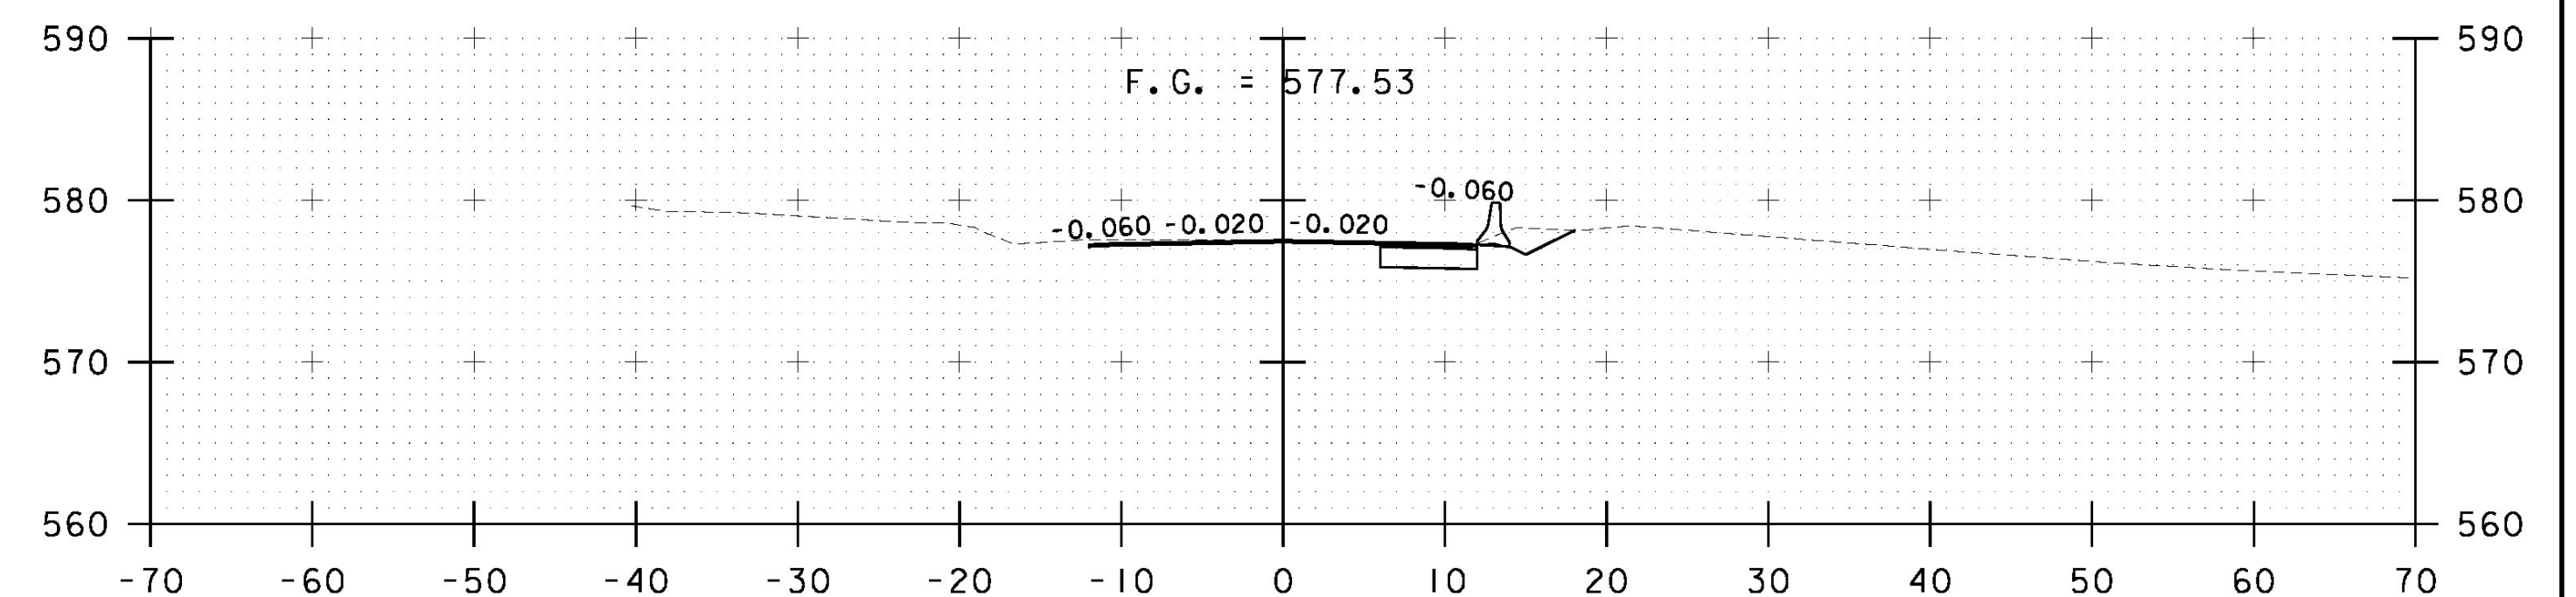

404+50

STA. 403+00 TO STA. 405+50

PROJECT NAME:	PUTNEY
PROJECT NUMBER:	IM 091-1(31)
FILE NAME:	...58-62 z93cl48tempdetourxs.plt
PROJECT LEADER:	G. BOGUE
DESIGNED BY:	E. ALLING
DATE:	7/8/2009
DRAWN BY:	E. ALLING
CHECKED BY:	G. GOYETTE
TEMPORARY DETOUR SECTIONS	
SHEET 59 OF 75	

