


LEGEND

	UNDERDRAIN ON RIGHT
	UNDERDRAIN ON LEFT
	F.B. FLUSHING BASIN
	C.B. CATCH BASIN
	LT. LEFT
	RT. RIGHT

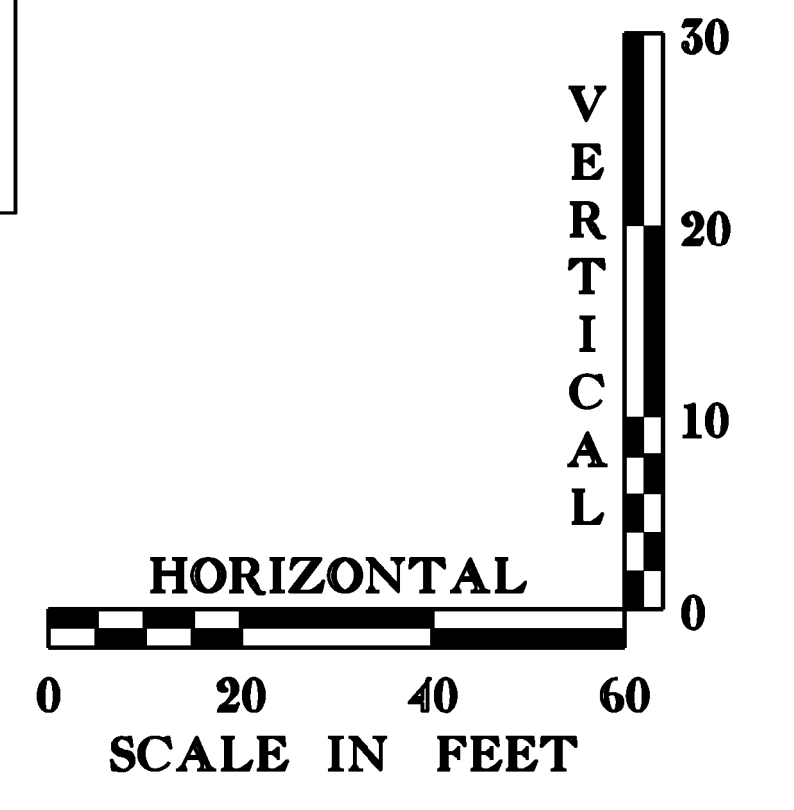

THE GRADES SHOWN TO THE NEAREST TENTH ARE THE ORIGINAL GROUND ELEVATIONS ALONG THE PROPOSED ALIGNMENT. THE GRADES SHOWN TO THE NEAREST HUNDRETH ARE THE PROPOSED PROFILE GRADES FOR THE NEW ALIGNMENT.

PROJECT NAME: WINOOSKI	PLOT DATE: 2/22/2010
PROJECT NUMBER: NH 089-3(65)	DRAWN BY: A. ACHARYA
FILE NAME: z94d198xsl.dgn	CHECKED BY: E. ATKINS
PROJECT LEADER: KEN UPMAL	SHEET 21 OF 67
DESIGNED BY: A. ACHARYA	
RAMP 'B' PROFILE SHEET	