

RAMP "B" 52+50 ~ 58+00 RT, 552 LF (EL)  
RAMP "B" 57+60 ~ 58+00 RT, 40 LF (LL)  
RAMP "B" 55+80 ~ 58+00 BL, 220 LF (LL)

RAMP "B" 52+50 ~ 58+00 LT, 551 LF (EL)

RAMP "B" 55+80 ~ 56+30 LT, 1 LEFT ARROW  
RAMP "B" 57+60 ~ 57+69 LT & RT, 3 "ONLY" (3X4=12 EACH)


RAMP "B" 52+50 ~ 58+00 RT, 552 LF (EL)  
RAMP "B" 57+60 ~ 58+00 RT, 40 LF (LL)  
RAMP "B" 55+80 ~ 58+00 BL, 220 LF (LL)

RAMP "B" 52+50 ~ 58+00 LT, 551 LF (EL)

RAMP "B" 55+80 ~ 56+30 LT, 1 LEFT ARROW  
RAMP "B" 57+60 ~ 57+69 LT & RT, 3 "ONLY" (3X4=12 EACH)

## 13 EACH

**5 EACH**

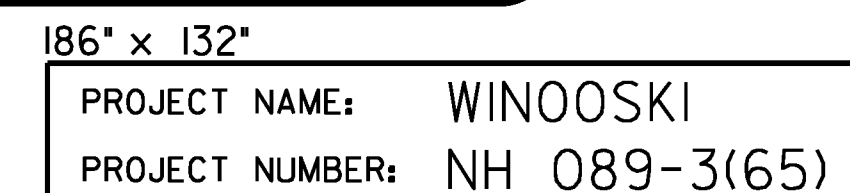

|                                        |                       |
|----------------------------------------|-----------------------|
| FILE NAME: z94a198pmbdr.dgn            | PLOT DATE: 2/23/2010  |
| PROJECT LEADER: KEN UPMAL              | DRAWN BY: J.WILTSHIRE |
| DESIGNED BY: J.SOBEL                   | CHECKED BY: D.FLYNN   |
| PVMT. MARKING AND SIGNS LAYOUT SHEET 1 | SHEET 42 OF 67        |