




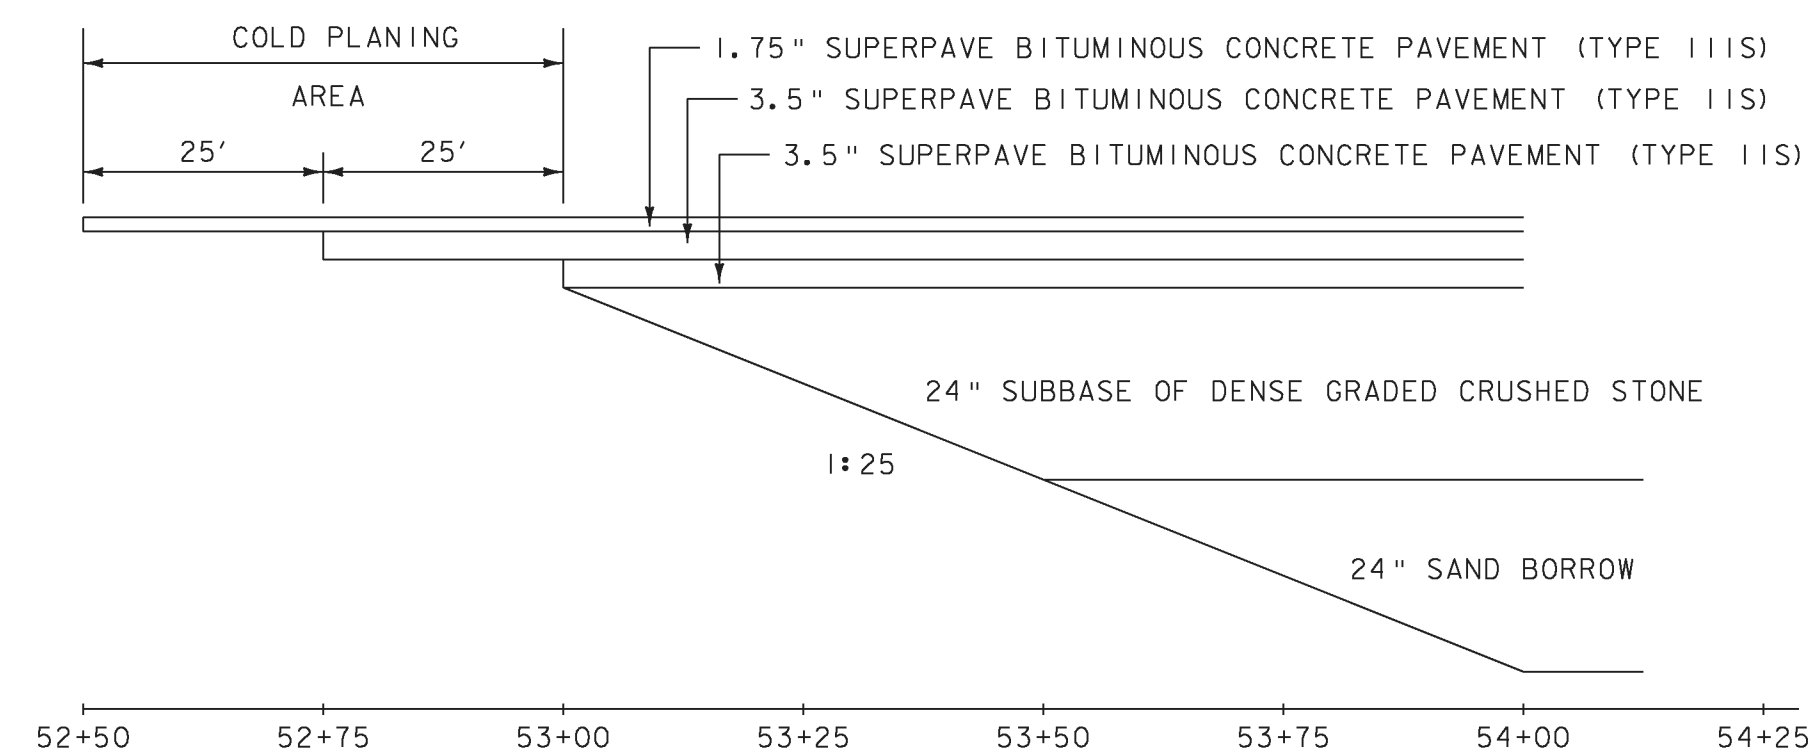


MATERIAL TRANSITION DETAIL
NOT TO SCALE

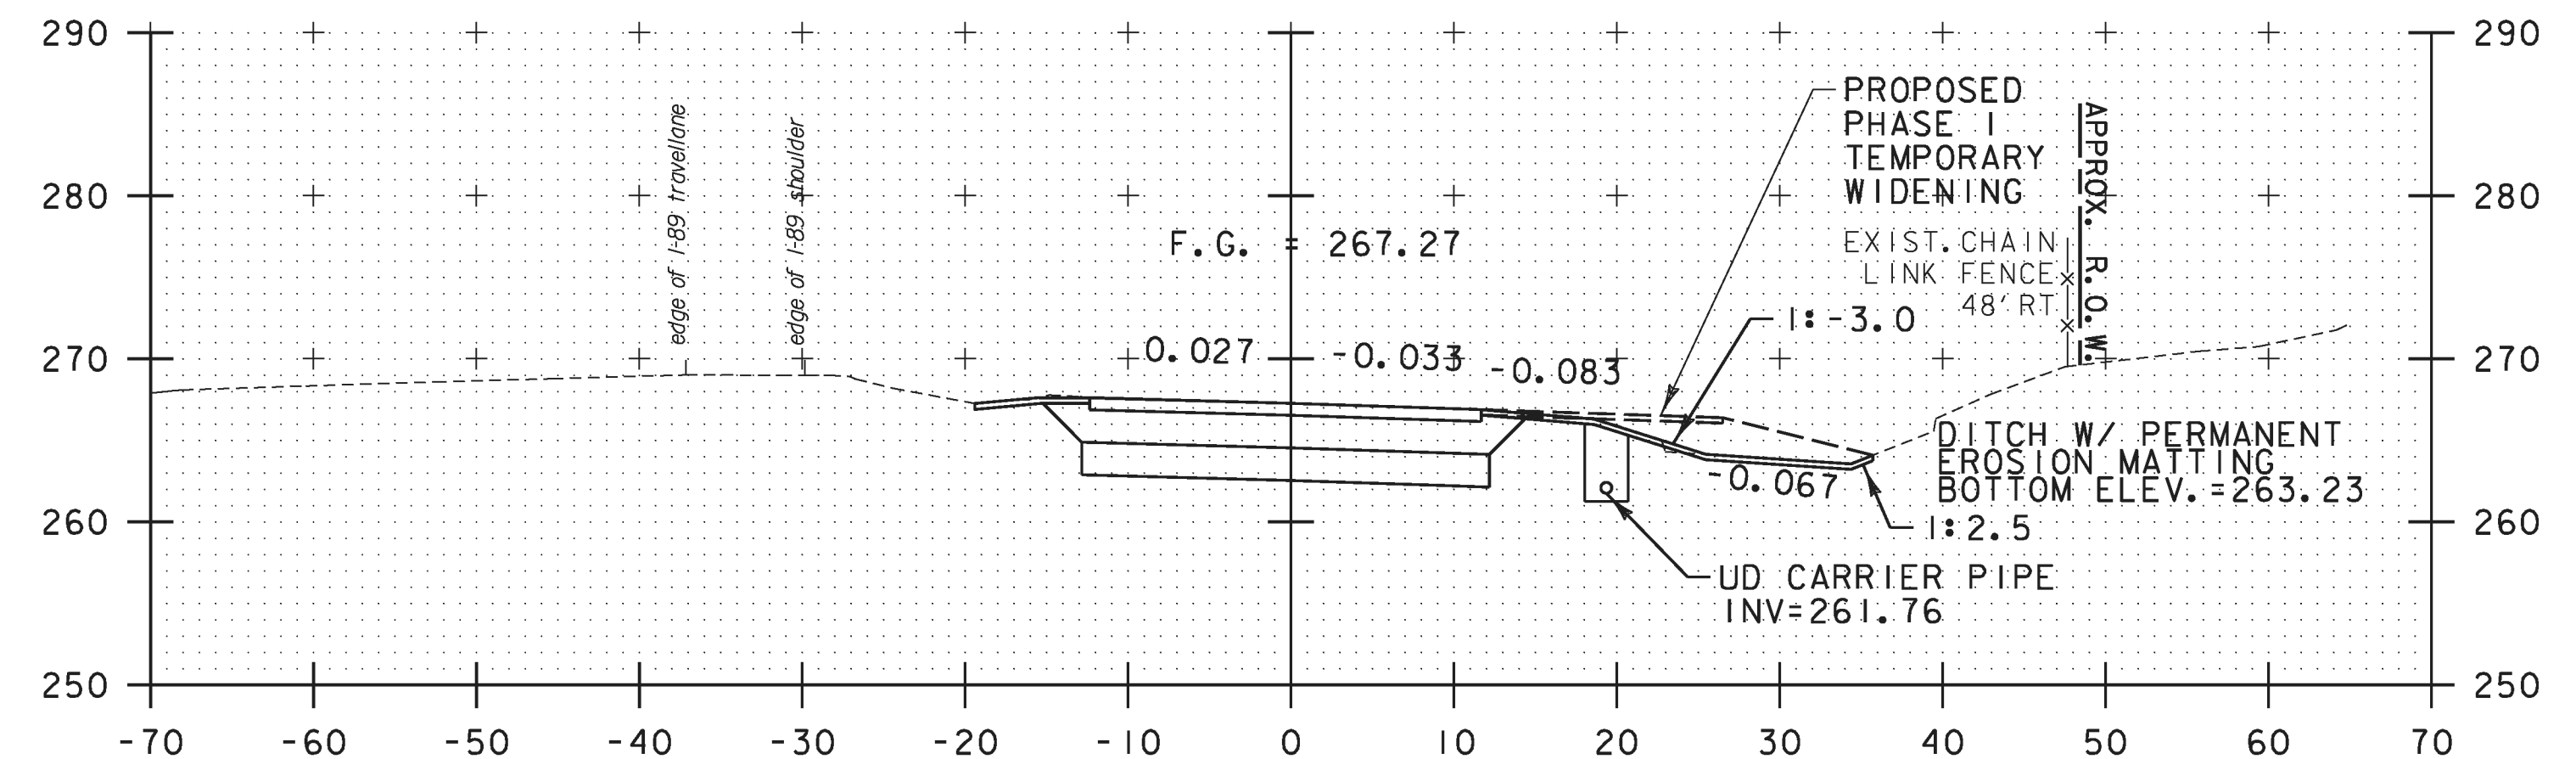


54+00
BEGIN PROJECT
END APPROACH

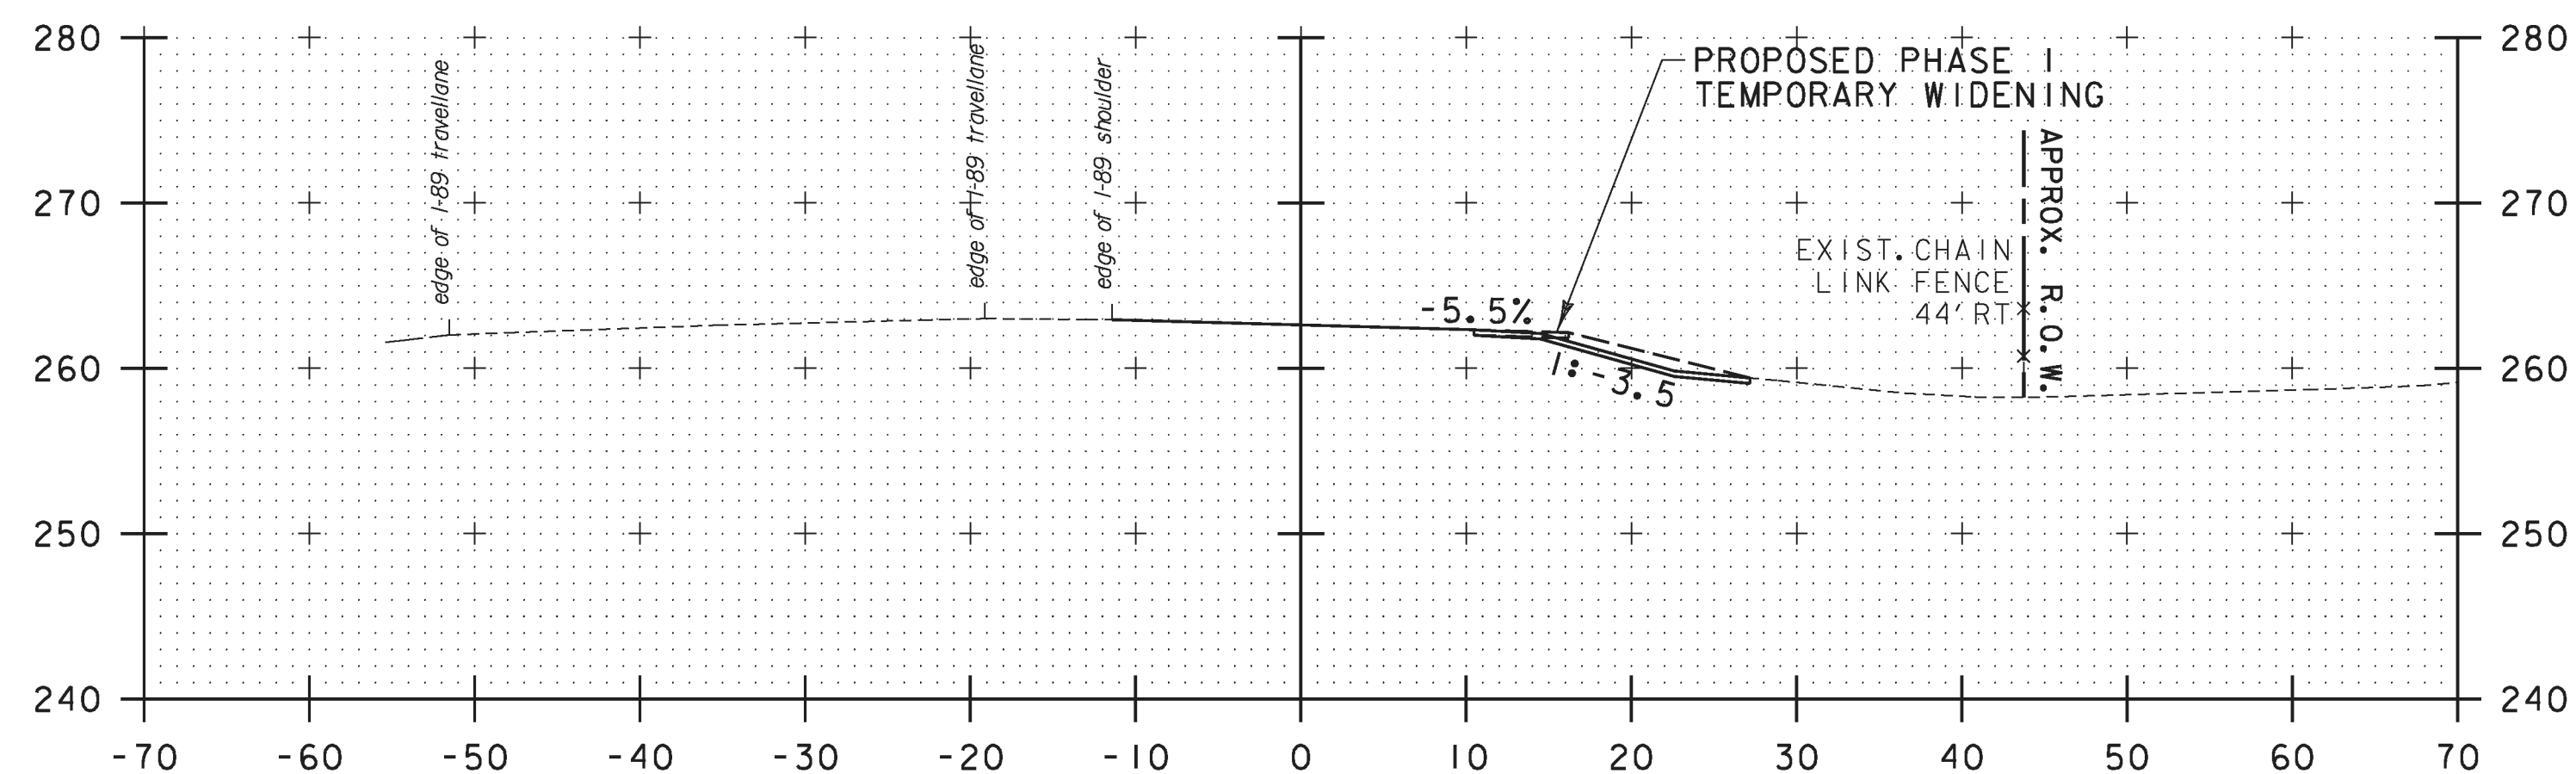


52+50
BEGIN APPROACH
MATCH EXISTING BCP

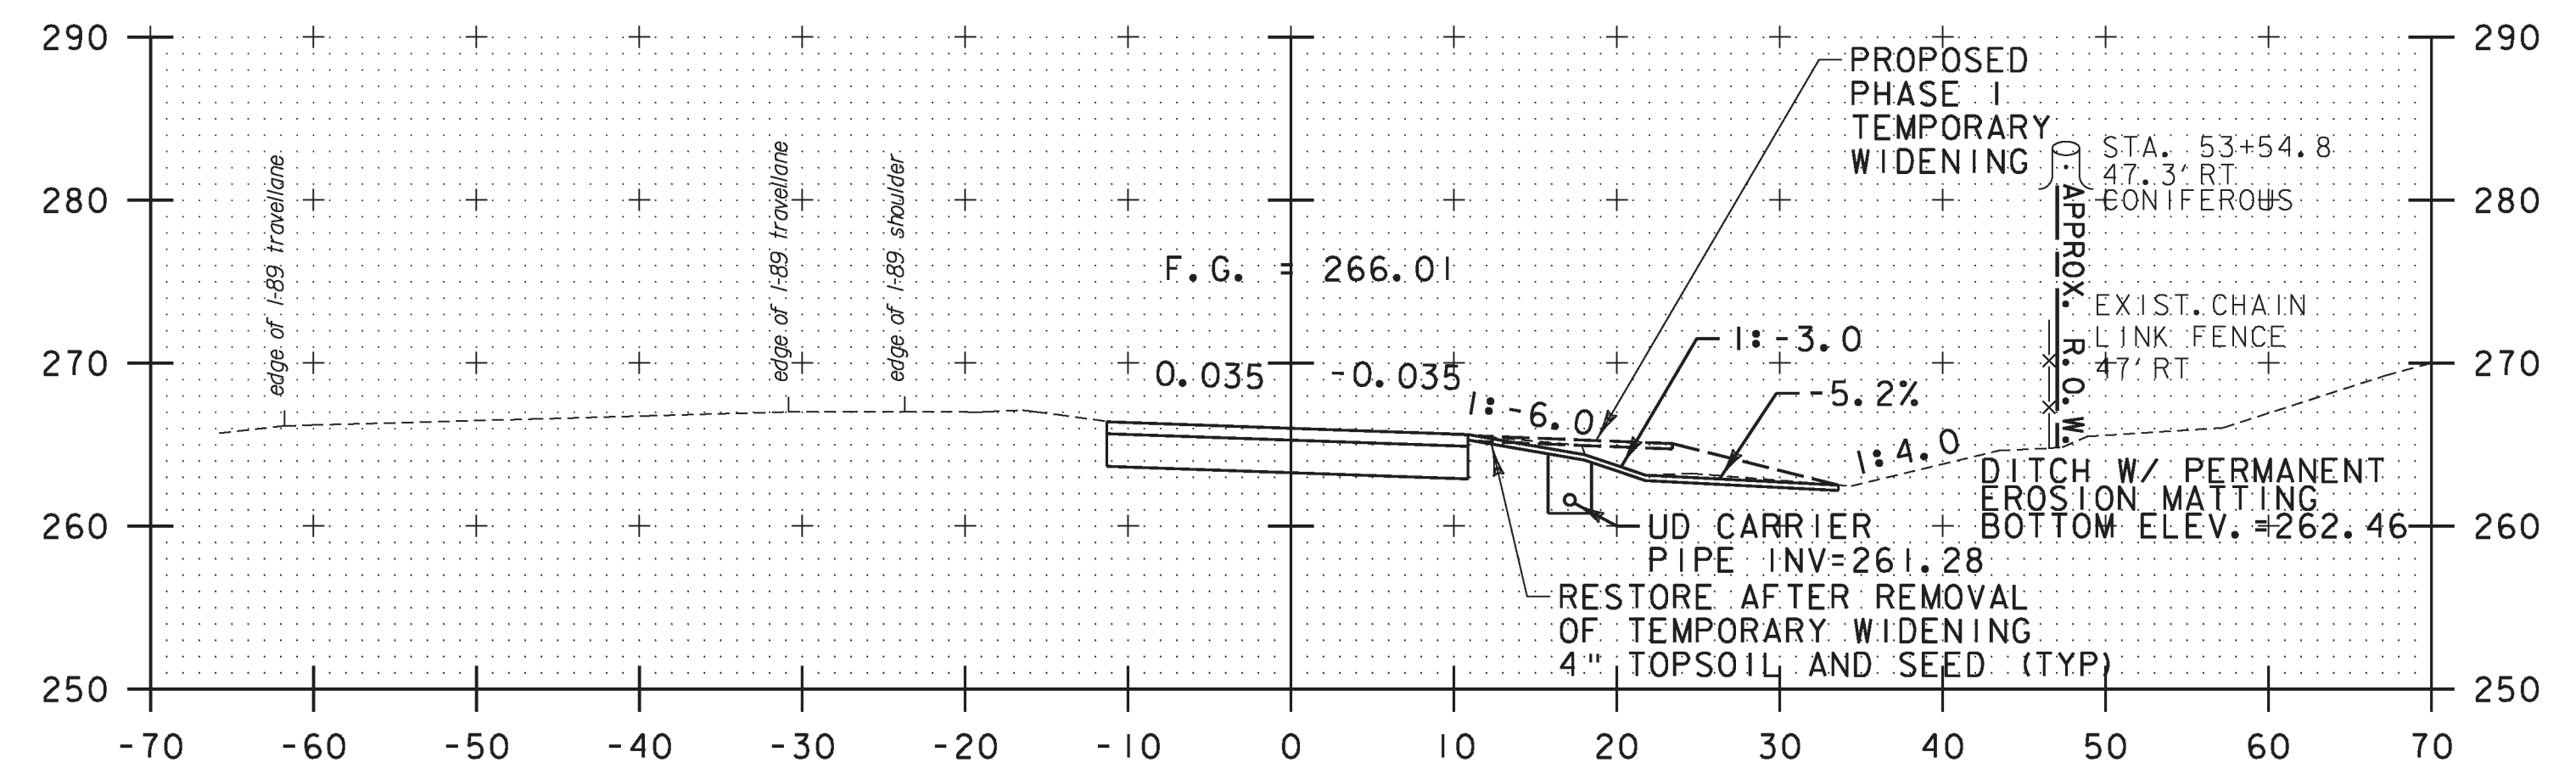


53+50

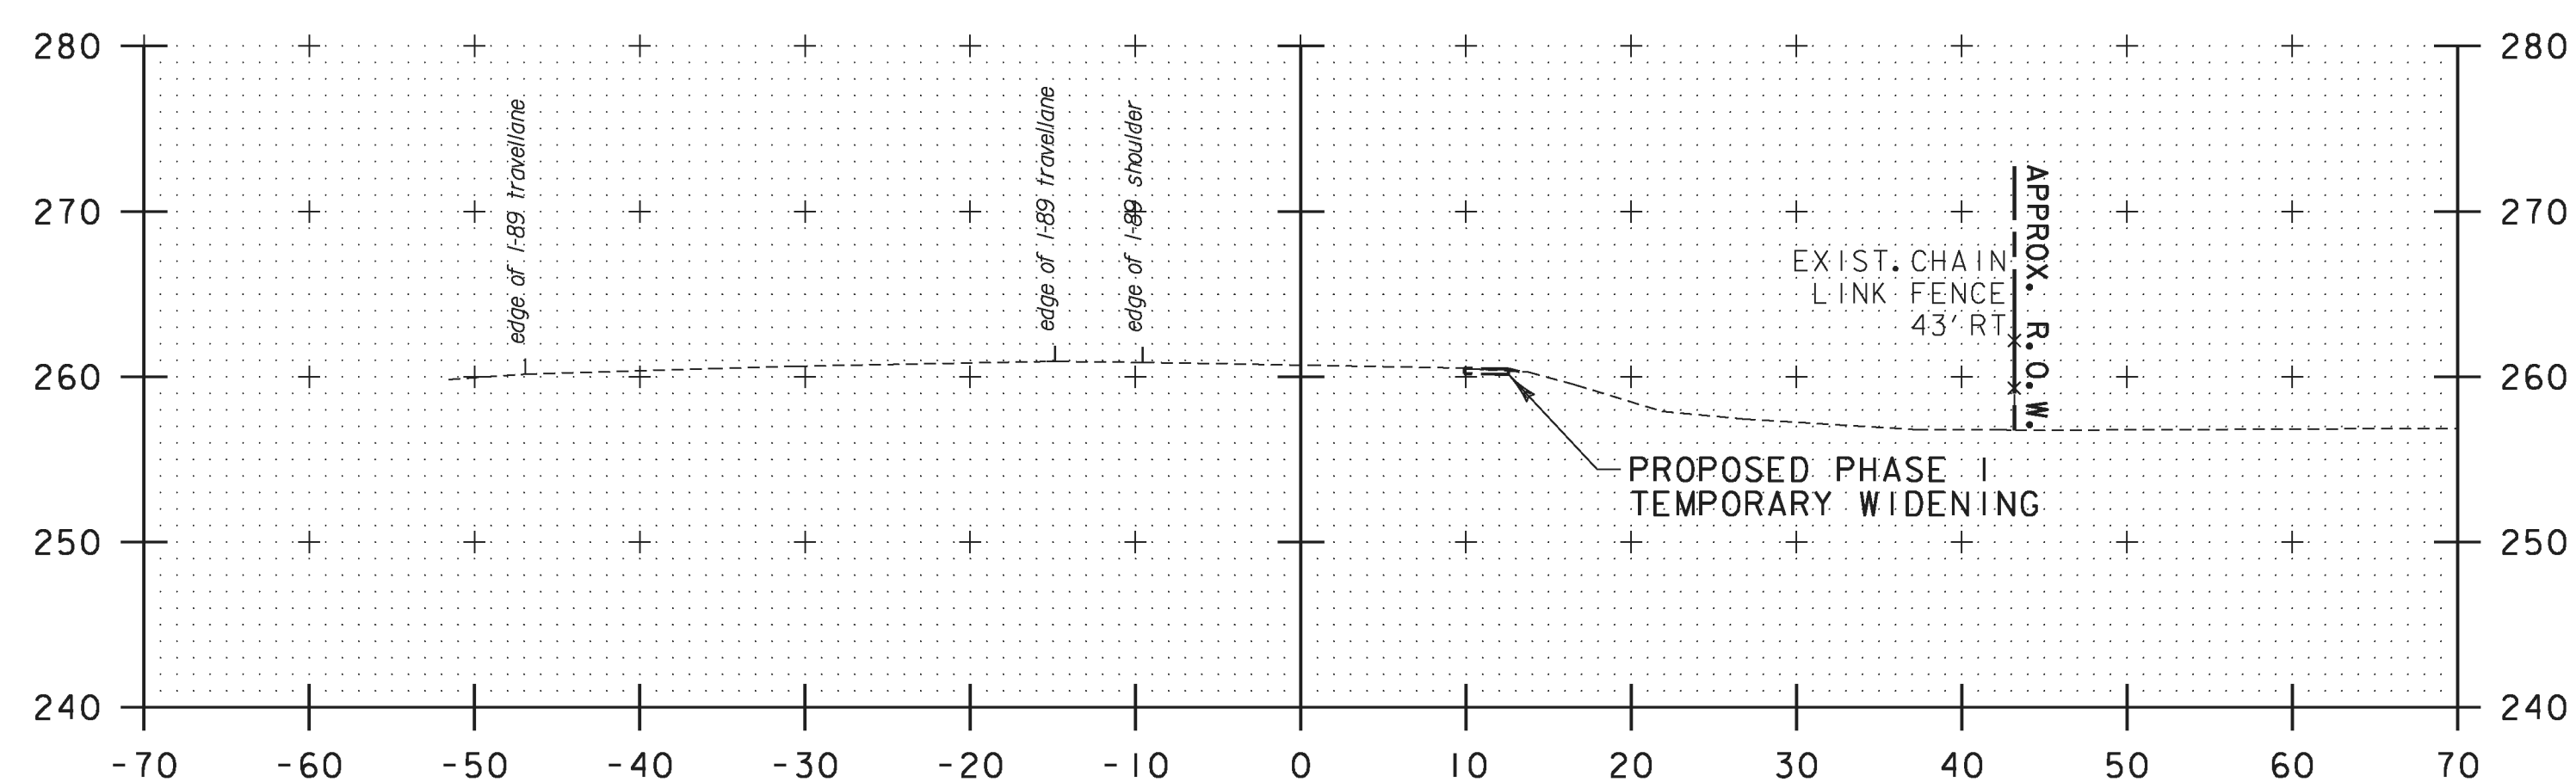

52+00

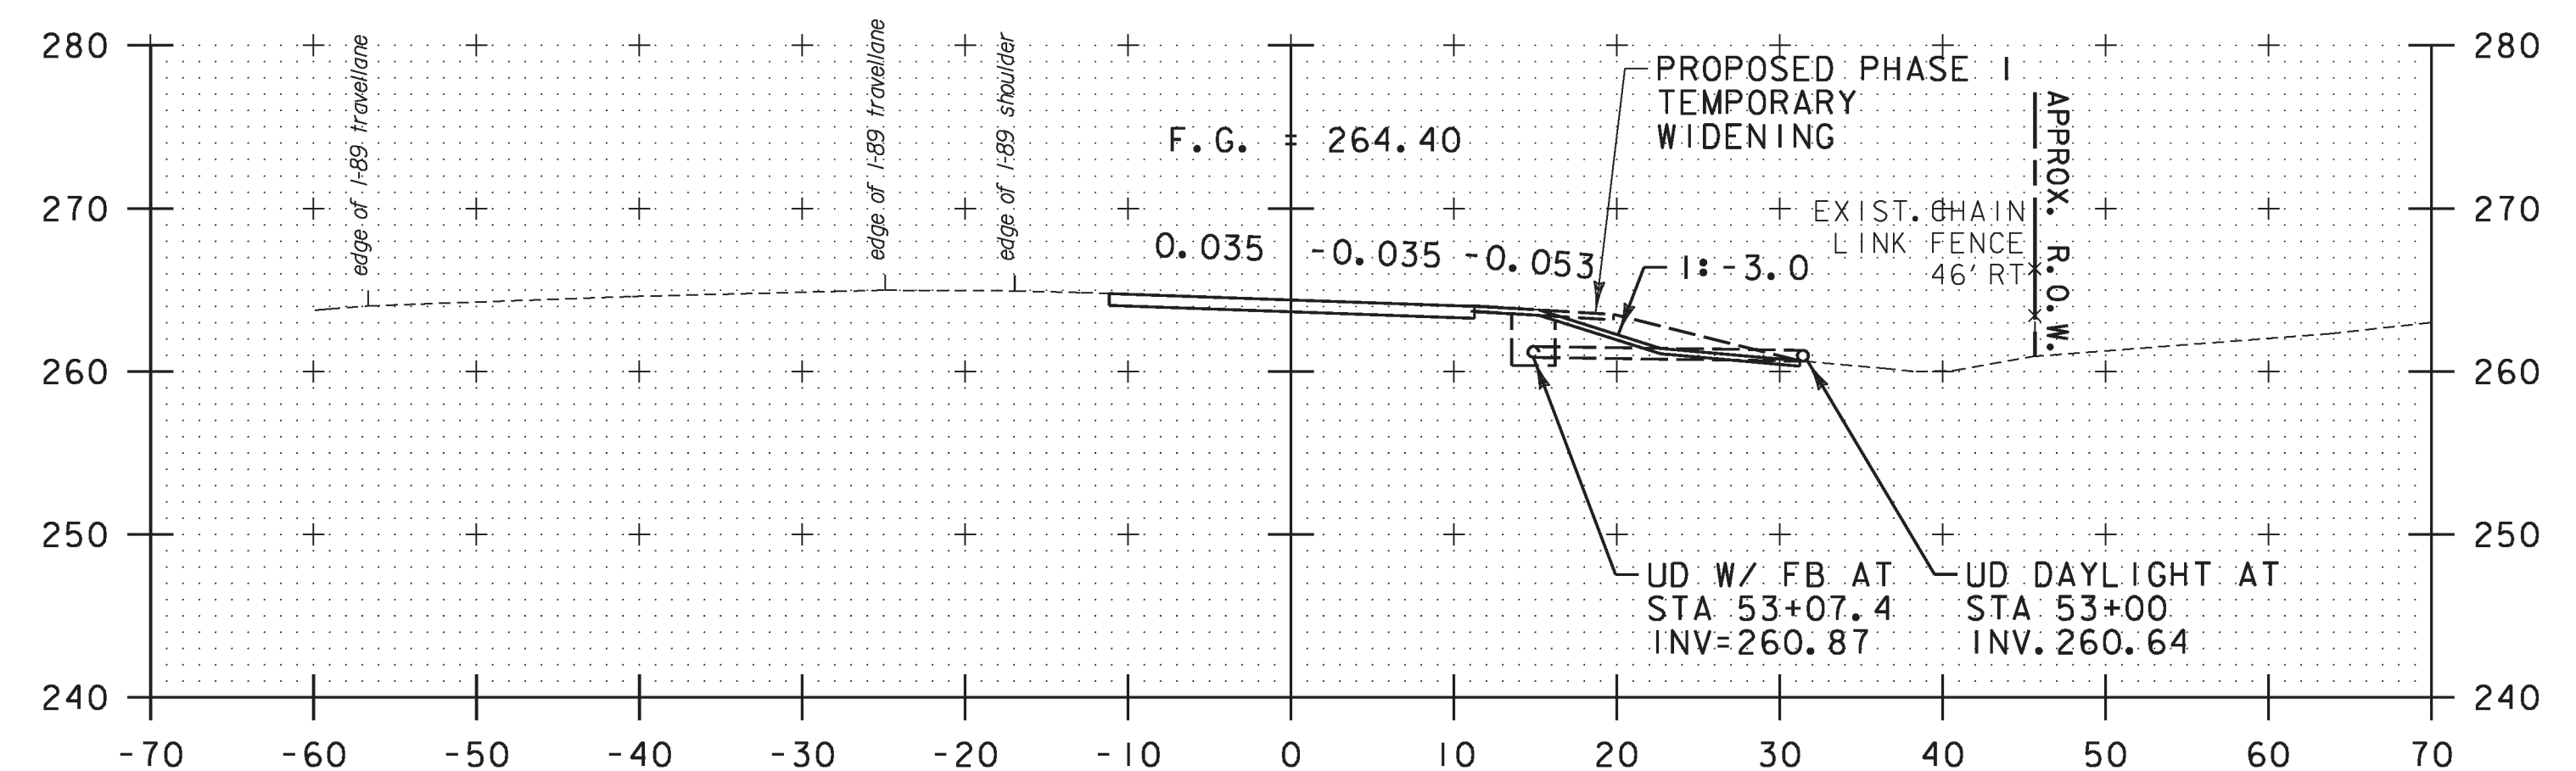

53+00

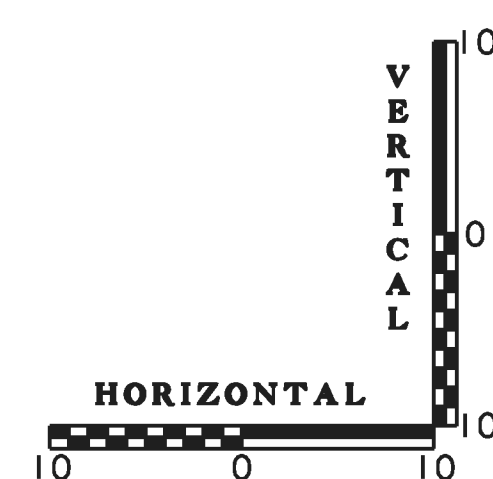

PROJECT NAME:	WINOOSKI
PROJECT NUMBER:	NH 089-3(65)
FILE NAME:	z94a198xsl.dgn
PROJECT LEADER:	KEN UPMAL
DESIGNED BY:	T.BIGELOW
RAMP 'B' CROSS SECTIONS SHEET 1	
PLOT DATE:	2/22/2010
DRAWN BY:	T.BIGELOW
CHECKED BY:	E.ATKINS
SHEET	60 OF 67