


WIRED CONDUIT (MOD) (2" PVC, WITH  
 3- #8 COPPER AND 1- #6 COPPER GROUND)  
 STANCHION TO POLE #3  
 POLE #3 TO POLE #2  
 POLE #2 TO POLE #1  
 POLE #3 TO POLE #6  
 POLE #6 TO POLE #7

STREET LIGHTING LOCATIONS													
POLE NO.	INSTALL NEW T-BASE	LIGHT POLE TAG	HAND HOLE COVER	NEW LAMP RED'D	REMOVE/RESET POLE	ELECT WIRING	NEW LUMINAIRE RED'D	REMOVE POLE & BASE	EXIST. BREAK-AWAY	EXIST. LUMINAIRE WATTS TYPE	EXIST. MOUNT HEIGHT	NEW CONC. BASE	REMARKS
	679. 23	679. 21 MOD 3	679. 21 MOD 2	679. 50 MOD	679. 25	678. 24	679. 50	679. 25 MOD				679. 21 MOD 1	
1				X		X	X		NONE	150 W. HPS	30		TRAFFIC COUNTER STAND & LOOP LOCATED NEARBY IF DAMAGED, CONTRACTOR TO REPAIR AT HIS EXPENSE
2				X		X	X		NONE	250 W. HPS	30		
3			X	X		X	X		NONE	250 W. HPS	30	X	
4								X	NONE	150 W. HPS	30		
5								X	NONE	150 W. HPS	30		
6				X		X	X		NONE	250 W. HPS	30		REMOVE POLE TOP LUMINAIRE. COST SUBSIDIARY TO OTHER ITEMS.
7				X		X	X		NONE	150 W. HPS	30		


BUILDING HAS BEEN REMOVED

INSTALL SWEEP  
 (IF FOUNDATION OF BUILDING PREVENTS DIRECT RUN)

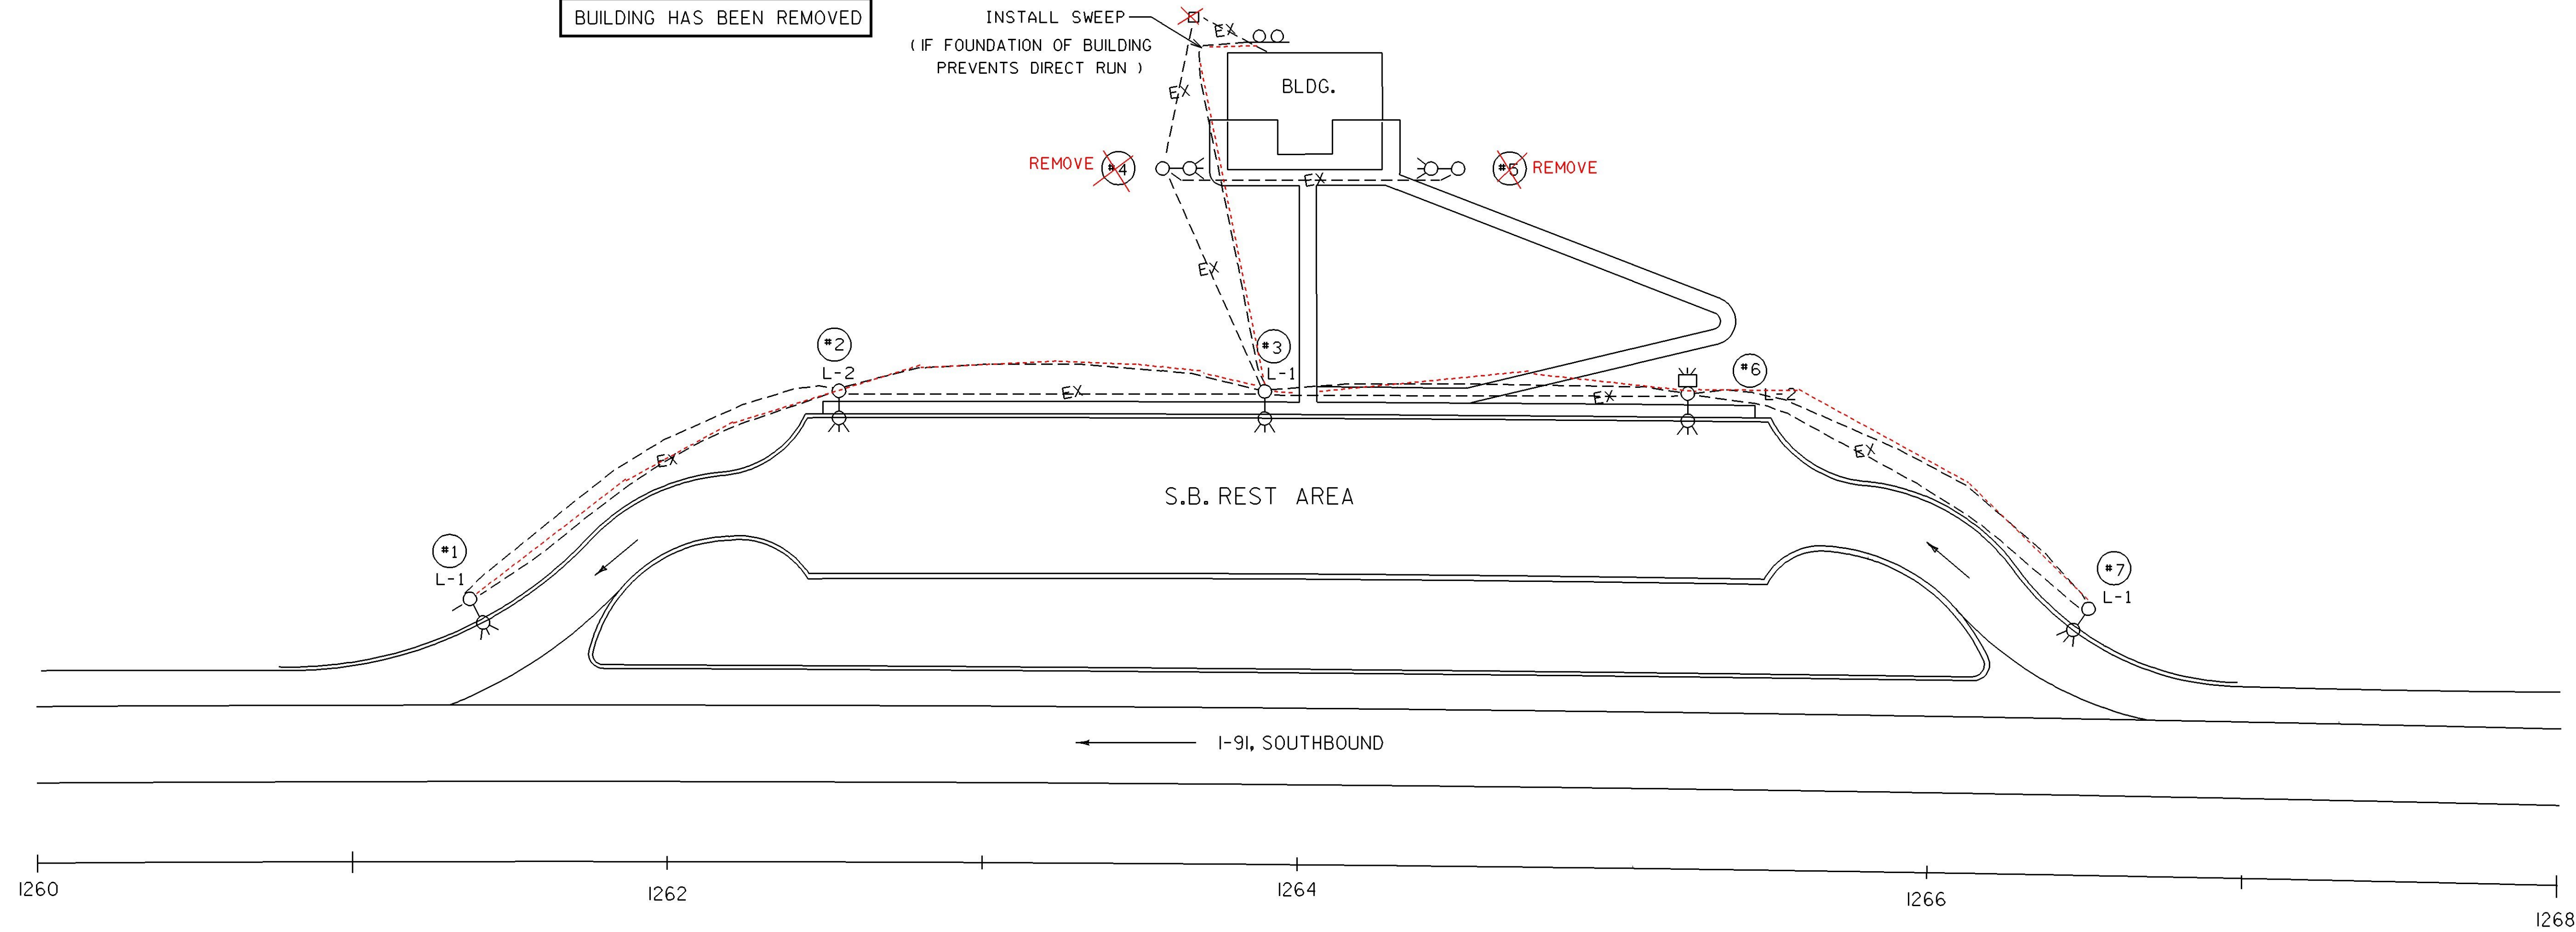

LEGEND

- EXIST. LIGHT POLE AND LUMINAIRE
- EXIST. PULL BOX
- EXIST. UNDERGROUND CIRCUITRY
- NEW CIRCUITRY
- EXISTING STANCHION
- POLE TOP LUMINAIRE

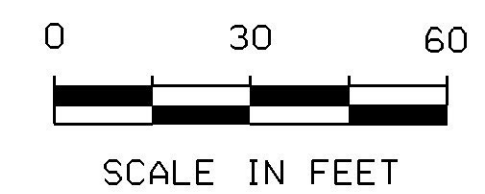

**ARCHIVED  
ON CADD**

SITE 2  
 WESTMINSTER, SB REST AREA, I-91

PREPARED BY RPD DATE 9-94  
 MODIFIED BY EGF/P.G.J. DATE 4/97  
 DESIGN SUPERVISOR ARK DATE  
 PROJ.

STATEWIDE IM LITE ( 6 )

TRAFFIC SHEET NO. OF  
 SHEET 4 OF 37 SHEETS

/r of /34290/10290.dgn/10290.d  
 PLOTTED: 05-11-2001