


NOTES

1. LOCATION OF PULL BOXES AND UNDERGROUND CIRCUITRY IS UNKNOWN AT THIS LOCATION. IF PULL BOXES ARE LOCATED, THEY SHOULD BE REMOVED (AT THE ENGINEERS DISCRETION) TO PREVENT POSSIBLE FUTURE CONFUSION OF CONDUIT LOCATION. PAYMENT FOR PULL BOX REMOVAL TO BE BY ITEM 678.25 (MOD).
2. EXISTING METER/DISCONNECT ON UTILITY POLE TO BE REPLACED ON A STANCHION.
3. ROUTING OF CONDUIT SHOULD AVOID THE WET AREA, IF POSSIBLE.
4. SET PULLBOX AS FAR AWAY FROM MEMORIAL STONE AS POSSIBLE, SO AS TO NOT DISTRACT FROM IT.
5. DO NOT PLACE CONDUIT IN CUNDUIT SLEEVE ACROSS FIELD DRIVE.

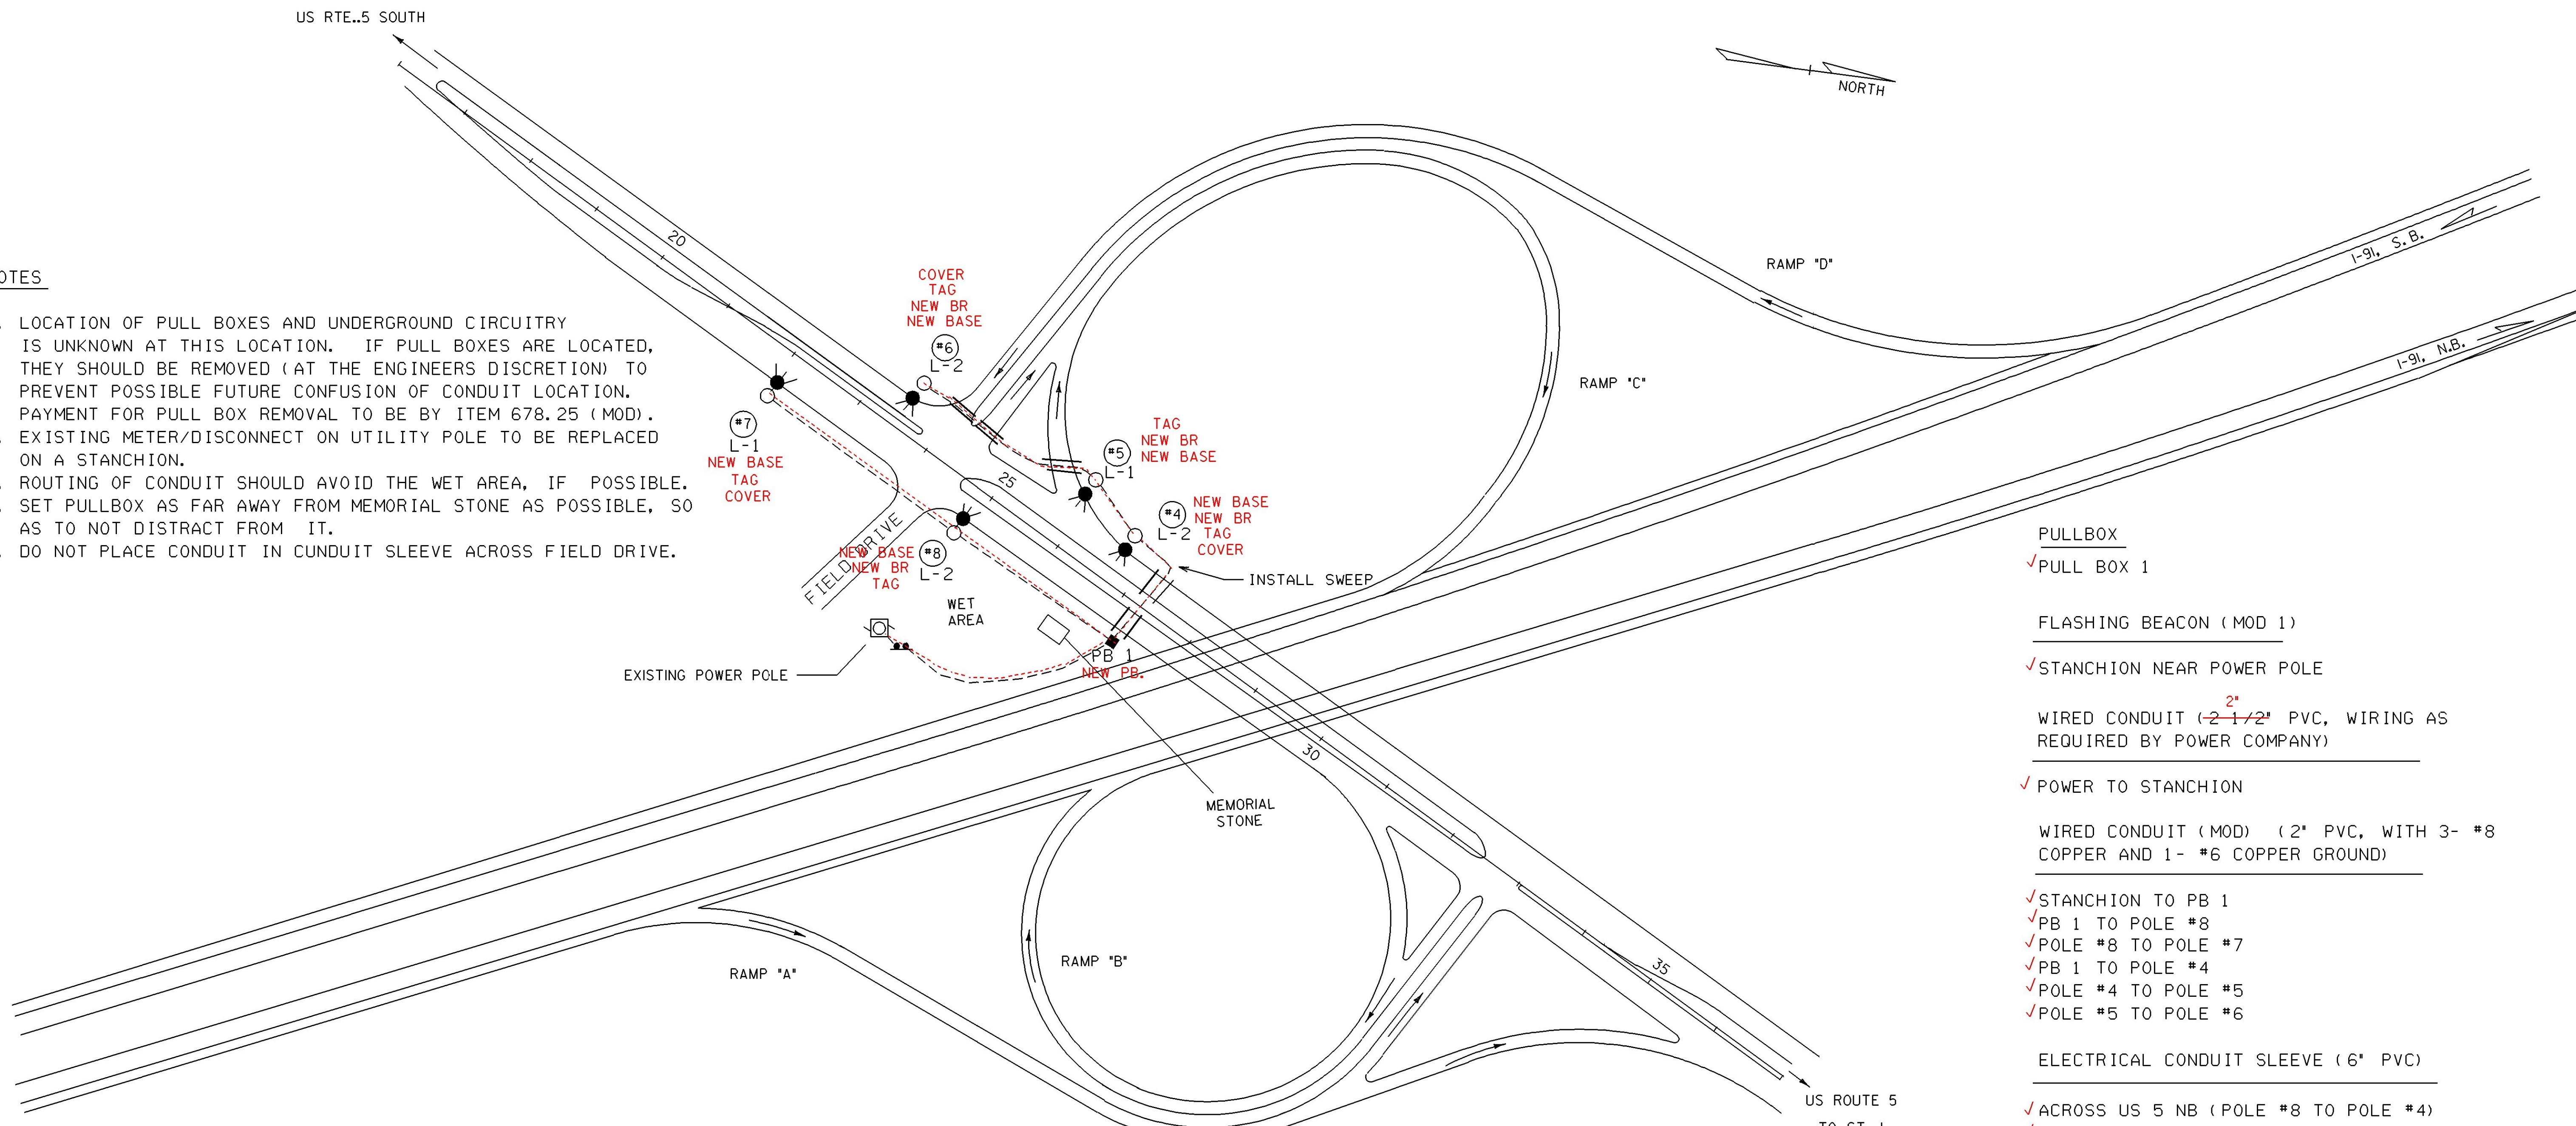

- PULLBOX
- ✓ PULL BOX 1

- FLASHING BEACON (MOD 1)
- ✓ STANCHION NEAR POWER POLE

- WIRED CONDUIT (-2 1/2" PVC, WIRING AS REQUIRED BY POWER COMPANY)
- ✓ POWER TO STANCHION

- WIRED CONDUIT (MOD) (2" PVC, WITH 3- #8 COPPER AND 1- #6 COPPER GROUND)
- ✓ STANCHION TO PB 1
- ✓ PB 1 TO POLE #8
- ✓ POLE #8 TO POLE #7
- ✓ PB 1 TO POLE #4
- ✓ POLE #4 TO POLE #5
- ✓ POLE #5 TO POLE #6

- ELECTRICAL CONDUIT SLEEVE (6" PVC)
- ✓ ACROSS US 5 NB (POLE #8 TO POLE #4)
- ✓ ACROSS US 5 SB (POLE #8 TO POLE #4)
- ✓ ACROSS RAMP C (POLE #5 TO POLE #6) [2 LOCATIONS]
- ✓ ACROSS RAMP D (POLE #5 TO POLE #6)

- REMOVE AND RESET CURB
- TO BE USED WITH ELECTRICAL CONDUIT SLEEVE, AS REQ'D

STREET LIGHTING LOCATIONS													
POLE NO.	INSTALL NEW T-BASE	LIGHT POLE TAG	HAND HOLE COVER	NEW LAMP REQ'D	REMOVE/RESET POLE	ELECT WIRING	NEW LUMINAIRE REQ'D	REMOVE POLE & BASE	EXIST. BREAK-AWAY	NEW LUMINAIRE WATTS TYPE	EXIST. MOUNT HEIGHT	NEW CONC. BASE	REMARKS
	679.23	679.21 MOD 3	679.21 MOD 2	679.50 MOD	679.25	678.24	679.50	679.25 MOD				679.21 MOD 1	
4	X ✓	X ✓	X ✓		X ✓	X ✓	X ✓		COUP	150 w. HPS	40	X ✓	NEW BASE ELEVATION TO BE APPROX. 12" HIGHER THAN EXISTING
5	X ✓	X ✓			X ✓	X ✓	X ✓		COUP	150 w. HPS	40		REGRADE GROUND NEAR POLE TO PROVIDE 1 1/4 INCH CLEARANCE BETWEEN TOP OF BASE AND GROUND LEVEL
6	X ✓	X ✓	X ✓		X ✓	X ✓	X ✓		COUP	150 w. HPS	40	X ✓	NEW BASE ELEVATION TO BE APPROX. 6" HIGHER THAN EXISTING
7		X ✓	X ✓		X ✓	X ✓	X ✓		COUP	150 w. HPS	40	X ✓	REMOVE COUPLING. SET POLE DIRECTLY ON NEW BASE WITH NO BREAKAWAY FEATURE
8	X ✓	X ✓			X ✓	X ✓	X ✓		COUP	150 w. HPS	40	X ✓	NEW BASE ELEVATION TO BE APPROX. 8" HIGHER THAN EXISTING

LEGEND

- EXIST. LIGHT POLE W/ NEW LUMINAIRE
- EXIST. UTILITY POLE
- NEW CIRCUITRY
- NEW STANCHION
- ELECTRICAL CONDUIT SLEEVE
- NEW PULLBOX

ARCHIVED
ON CADD

ST. JOHNSBURY- SOUTH, EXIT #20, I- 91

PREPARED BY RPD DATE 9-94
 MODIFIED BY EGF/P.G.J. DATE 4/97
 DESIGN SUPERVISOR ARK DATE
 PROJ.

STATEWIDE IM LITE (6)

Plot/94/290/10290.dgn/102908J
 PLOTTED:05-JAN-2000

TRAFFIC SHEET NO. 8 OF 37 SHEETS