



STATE OF VERMONT AGENCY OF TRANSPORTATION

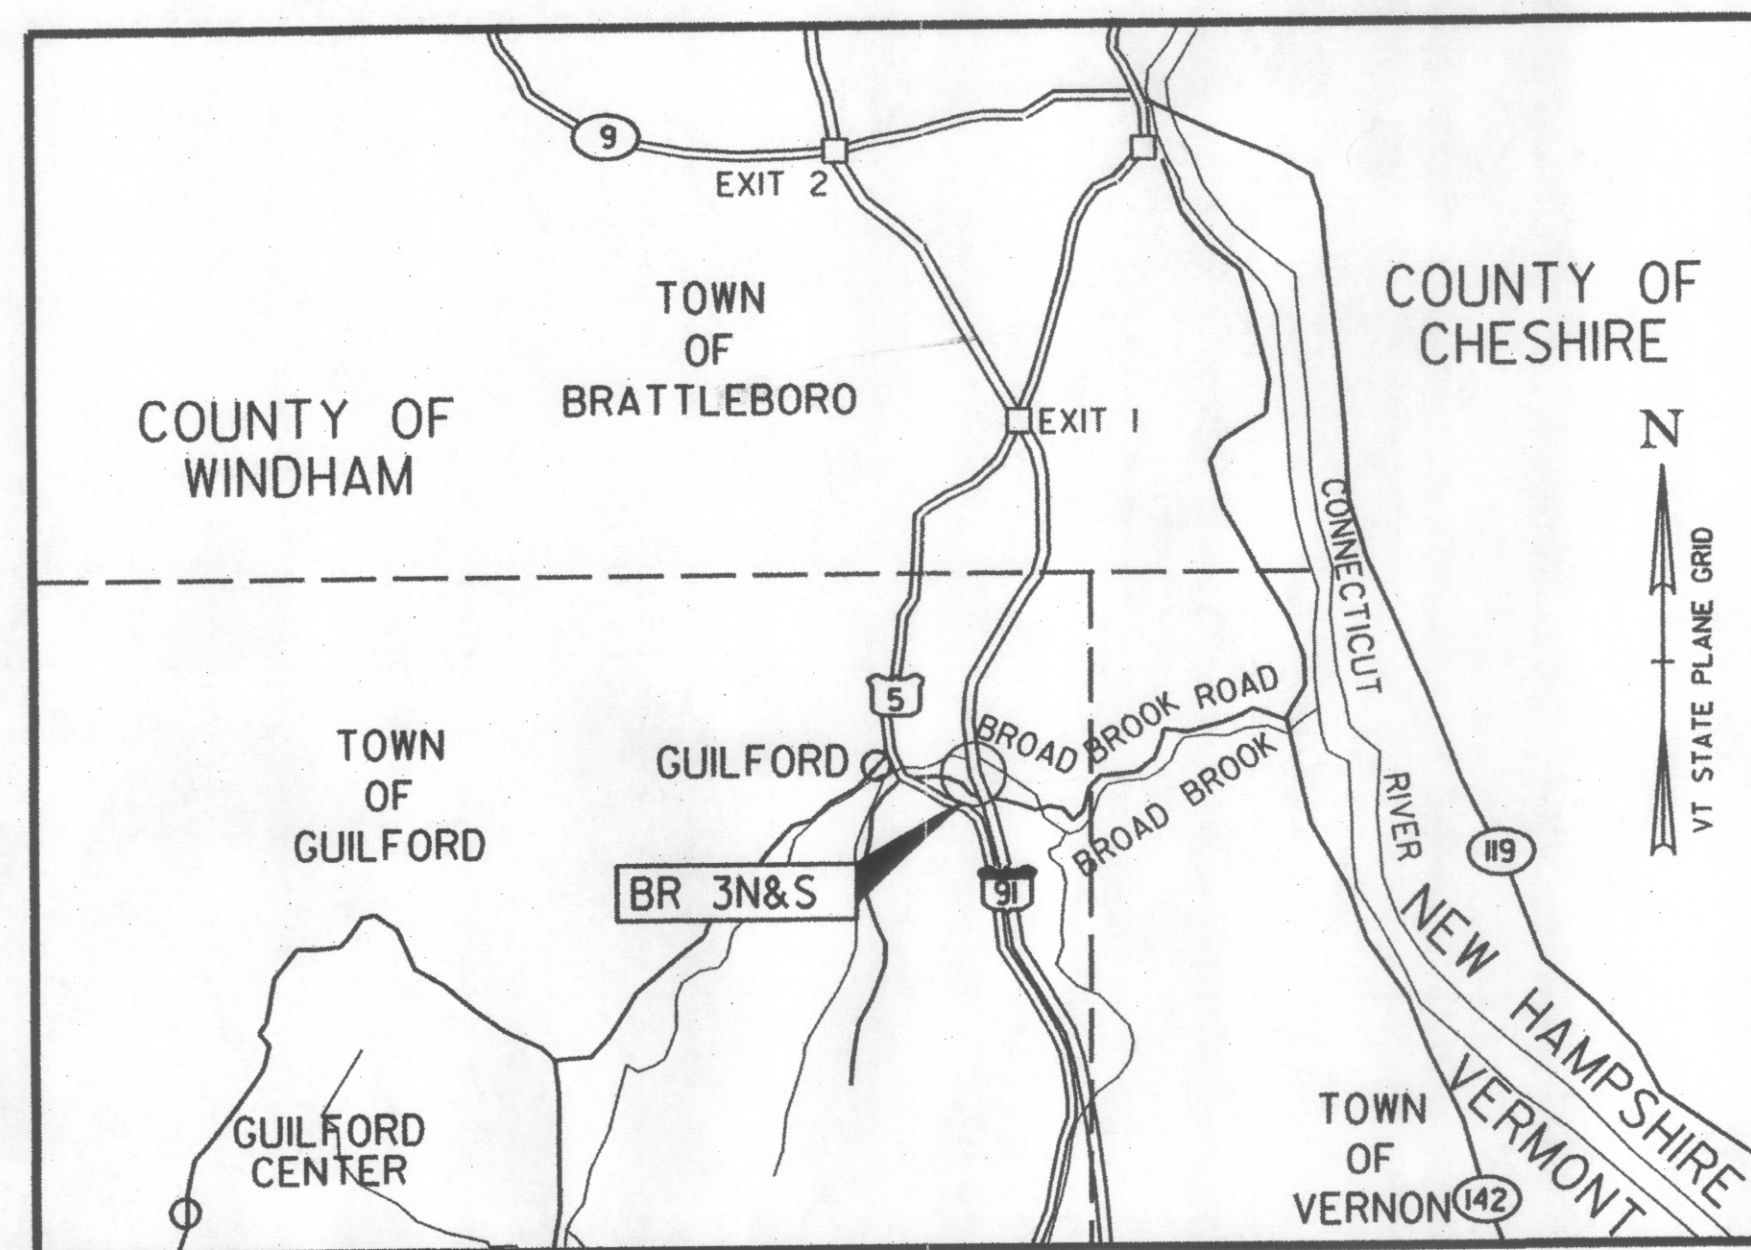

PROPOSED IMPROVEMENT BRIDGE PROJECT

**TOWN OF GUILFORD
COUNTY OF WINDHAM**

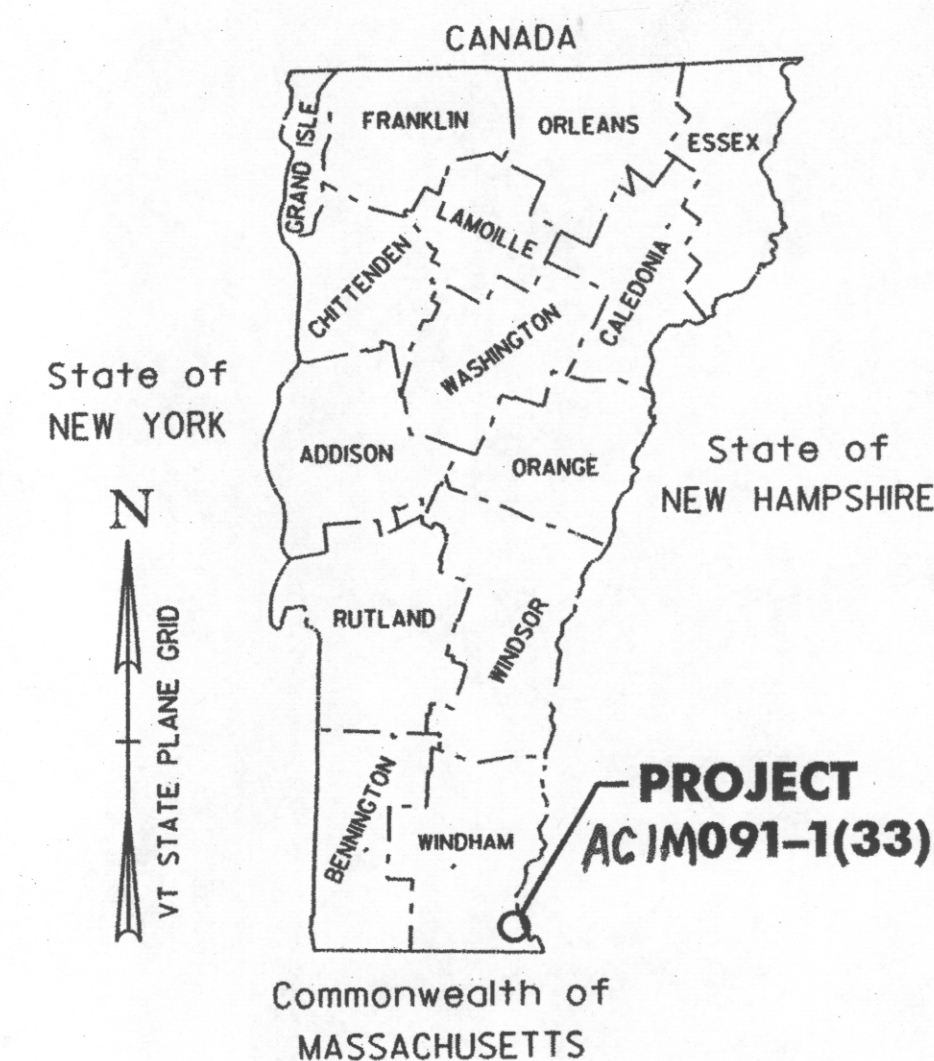

RECORD PLANS	
CONTRACTOR:	J. A. MCDONALD INC. - LYNDON CENTER, VT
RESIDENT ENGINEER:	CHAD GREENWOOD
CONSTRUCTION BEGAN:	AUGUST 28, 2008
CONSTRUCTION COMPLETE:	AUGUST 01, 2011
RECORD PLANS BY:	CHAD GREENWOOD & J. HYDE

I HEREBY CERTIFY THAT ALL THE CONSTRUCTION REQUIRED BY THIS SET OF DRAWINGS HAS BEEN ACCOMPLISHED AS INDICATED HEREIN.

BY Chad Greenwood RESIDENT ENGINEER
DATE 6/26/13

NOTE: Any further information concerning final quantities, amounts or other details relative to this project may be found at Central Files in the electronic archives.

ROUTE NO.: I-91
BRIDGE NO.: 3N&S


PROJECT LOCATION: BR 3N&S OVER BROAD BROOK AND BROAD BROOK ROAD (MM 6.00)

PROJECT DESCRIPTION: INSTALL TRAFFIC CONTROL, REHABILITATE AND WIDEN NORTHBOUND BRIDGE AND APPROACHES, REHABILITATE SOUTHBOUND BRIDGE, REMOVE TRAFFIC CONTROL

LENGTH OF ROADWAY: NORTHBOUND: 1686.78' SOUTHBOUND: 191.78'
BROAD BROOK ROAD: 200.00'

LENGTH OF STRUCTURES: BR 3N 258.22' BR 3S 258.22'

TOTAL LENGTH OF PROJECT: 1945.00'

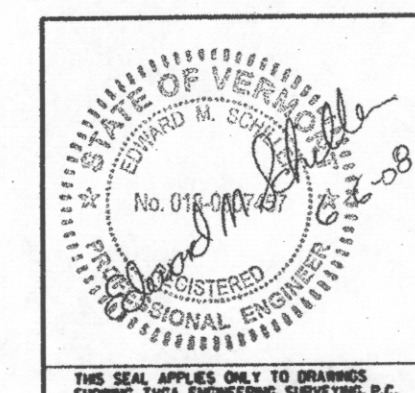

CONVENTIONAL SYMBOLS



COUNTY LINE	
TOWN LINE	
LIMITS OF ACCESS	
POINT OF ACCESS	
FENCE LINE	
STONE WALL	
TRAVELED WAY	
GUARD RAIL	
RAILROAD	
SURVEY LINE	
CULVERT	
POWER POLE	
TELEPHONE POLE	
TREES	
CONTROL OF ACCESS	
PROPERTY LINE	
R.O.W. TAKING LINE	
SLOPE RIGHTS	
TOP OF CUT	
TOE OF SLOPE	

SURVEYED BY : VSE
SURVEYED DATE : AUGUST 2000

DATUM

VERTICAL NAVD 88
HORIZONTAL NAD 83

THESE PLANS ARE SUBJECT TO SUCH ENGINEERING CHANGES AS MAY BE REQUIRED BY THE FEDERAL HIGHWAY ADMINISTRATION OR THE DIRECTOR OF PROGRAM DEVELOPMENT. CONSTRUCTION IS TO BE CARRIED ON IN ACCORDANCE WITH THESE PLANS AND THE STANDARD SPECIFICATIONS FOR CONSTRUCTION DATED 2006, AS APPROVED BY THE FEDERAL HIGHWAY ADMINISTRATION ON JUNE 15, 2006 USE ON THIS PROJECT, INCLUDING ALL SUBSEQUENT REVISIONS AND SUCH REVISED SPECIFICATIONS AND SPECIAL PROVISIONS AS ARE INCORPORATED IN THESE PLANS.

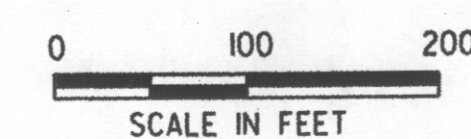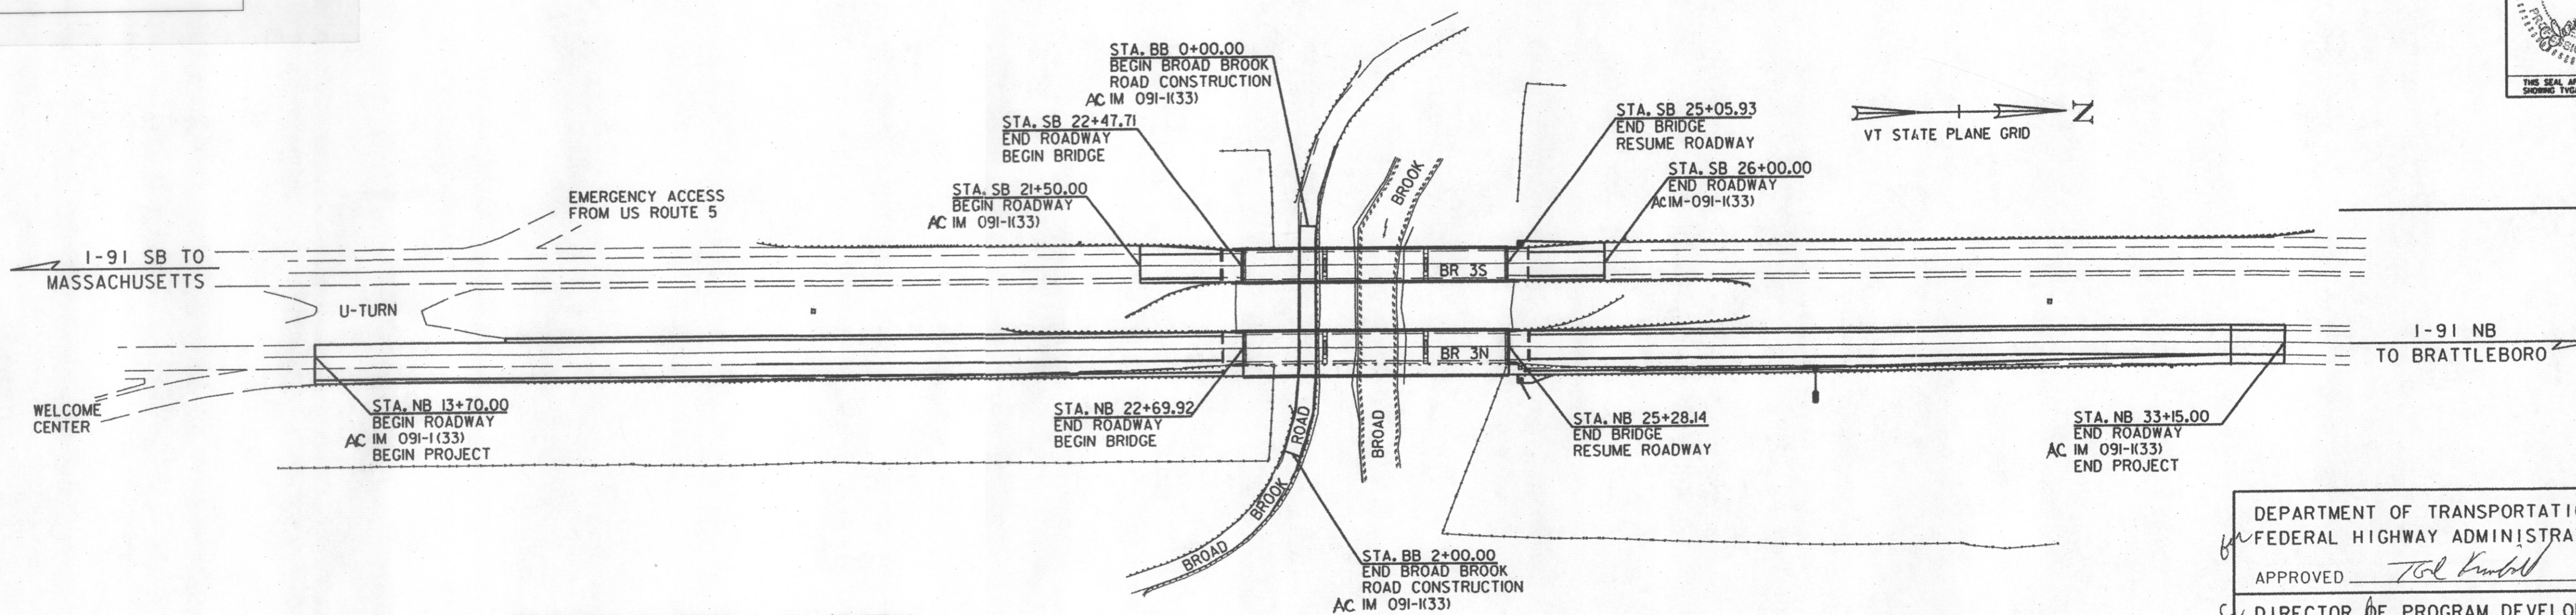

DEPARTMENT OF TRANSPORTATION FEDERAL HIGHWAY ADMINISTRATOR	
APPROVED <u>TGL</u>	DATE <u>6-20-2008</u>
DIRECTOR OF PROGRAM DEVELOPMENT	
APPROVED <u>James V. Bell</u>	DATE <u>6-9-2008</u>
PROJECT MANAGER : SHERWARD G. FARNSWORTH	
PROJECT NAME :	GUILFORD
PROJECT NUMBER :	AC IM 091-1(33)
SHEET 1 OF 114 SHEETS	

TVA TVGA ENGINEERING,
SURVEYING, P.C.