


PHASE 1 - STAGE A TRAFFIC CONTROL PLAN

LEGEND

- ////// PAVEMENT MARKING REMOVAL
- ===== TEMPORARY TRAFFIC BARRIER
- DIRECTION OF TRAFFIC FLOW WITH DETOUR IN PLACE
- CROSSOVER ALIGNMENT
- EXISTING GUARD RAIL
- ⊞ EXISTING DROP INLET
- APPROXIMATE CULVERT LOCATION
- REFLECTORIZED PLASTIC DRUM
- TYPE I DELINEATOR (YELLOW)
- TYPE I DELINEATOR (WHITE)
- TUBE MARKER
- ⊞ TYPE III BARRICADE
- ⊞ TYPE III (MOD) BARRICADE
- ⊞ SINGLE POST SIGN
- ⊞ DOUBLE POST SIGN

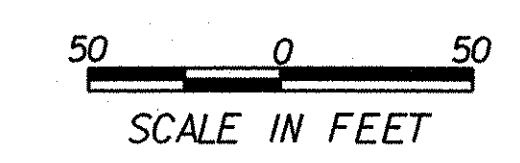

TVGA TVGA ENGINEERING, SURVEYING, P.C.

**STATE OF VERMONT
AGENCY OF TRANSPORTATION**

Town Of	GUILFORD	Bridge No.	3N&S
Highway No.	I-91	Log Sta.	
		Surv. Sta.	
I-91 OVER BROAD BROOK & BROAD BROOK ROAD			
PHASE 1 TRAFFIC CONTROL PLANS (2 OF 6)			
Designed By	T.C. GAWENUS	Drawn By	R.A. BOTZENHART
Checked By	P.W. SZUSTAK	Bridge Design Supervisor	J.P. HALSTEAD
Date	01/03	Date	01/03
PROJECT	GUILFORD	PROJECT NO.	IM 091-1(33)
TVGA CAD Drawing No.	tcp-4.dgn	Date	05/22/08
Bridge Sheet No.		Sheet	13 of 14