


**PHASE 1 - STAGE A TRAFFIC CONTROL PLAN**

**PORTABLE CHANGEABLE MESSAGE BOARD**

- PHASE 1 CROSSOVER IN PLACE 1 MILE
- PHASE 2 REDUCE SPEED AHEAD

**LEGEND**

- PAVEMENT MARKING REMOVAL
- TEMPORARY TRAFFIC BARRIER
- DIRECTION OF TRAFFIC FLOW WITH DETOUR IN PLACE
- CROSSOVER ALIGNMENT
- EXISTING GUARD RAIL
- EXISTING DROP INLET
- APPROXIMATE CULVERT LOCATION
- REFLECTORIZED PLASTIC DRUM
- TYPE I DELINEATOR (YELLOW)
- TYPE I DELINEATOR (WHITE)
- TUBE MARKER
- TYPE III BARRICADE
- TYPE III (MOD) BARRICADE
- SINGLE POST SIGN
- DOUBLE POST SIGN
- PORTABLE CHANGEABLE MESSAGE SIGN

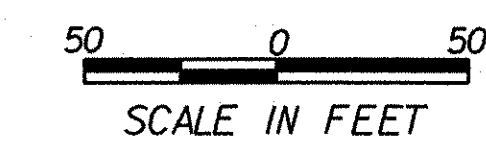

**TVE** TVGA ENGINEERING, SURVEYING, P.C.

**STATE OF VERMONT  
AGENCY OF TRANSPORTATION**

Town Of	GUILFORD	Bridge No.	<b>3N&amp;S</b>
Highway No.	I-91	Log Sta.	
		Surv. Sta.	
I-91 OVER BROAD BROOK & BROAD BROOK ROAD			
<b>PHASE 1 TRAFFIC CONTROL PLANS (6 OF 6)</b>			
Designed By	T.C. GAWENUS	Drawn By	R.A. BOTZENHART
Checked By	Date	Bridge Design Supervisor	
J.P. HALSTEAD	01/03	J.P. HALSTEAD	Date 01/03
PROJECT	GUILFORD	PROJECT NO.	IM 091-I(33)
TVGA CAD Drawing No.	tcp-7A.dgn	Date	05/22/08
Bridge Sheet No.		Sheet	16A of 114