


FRAMING PLAN (3S)
SCALE: 3/32" = 1'-0"

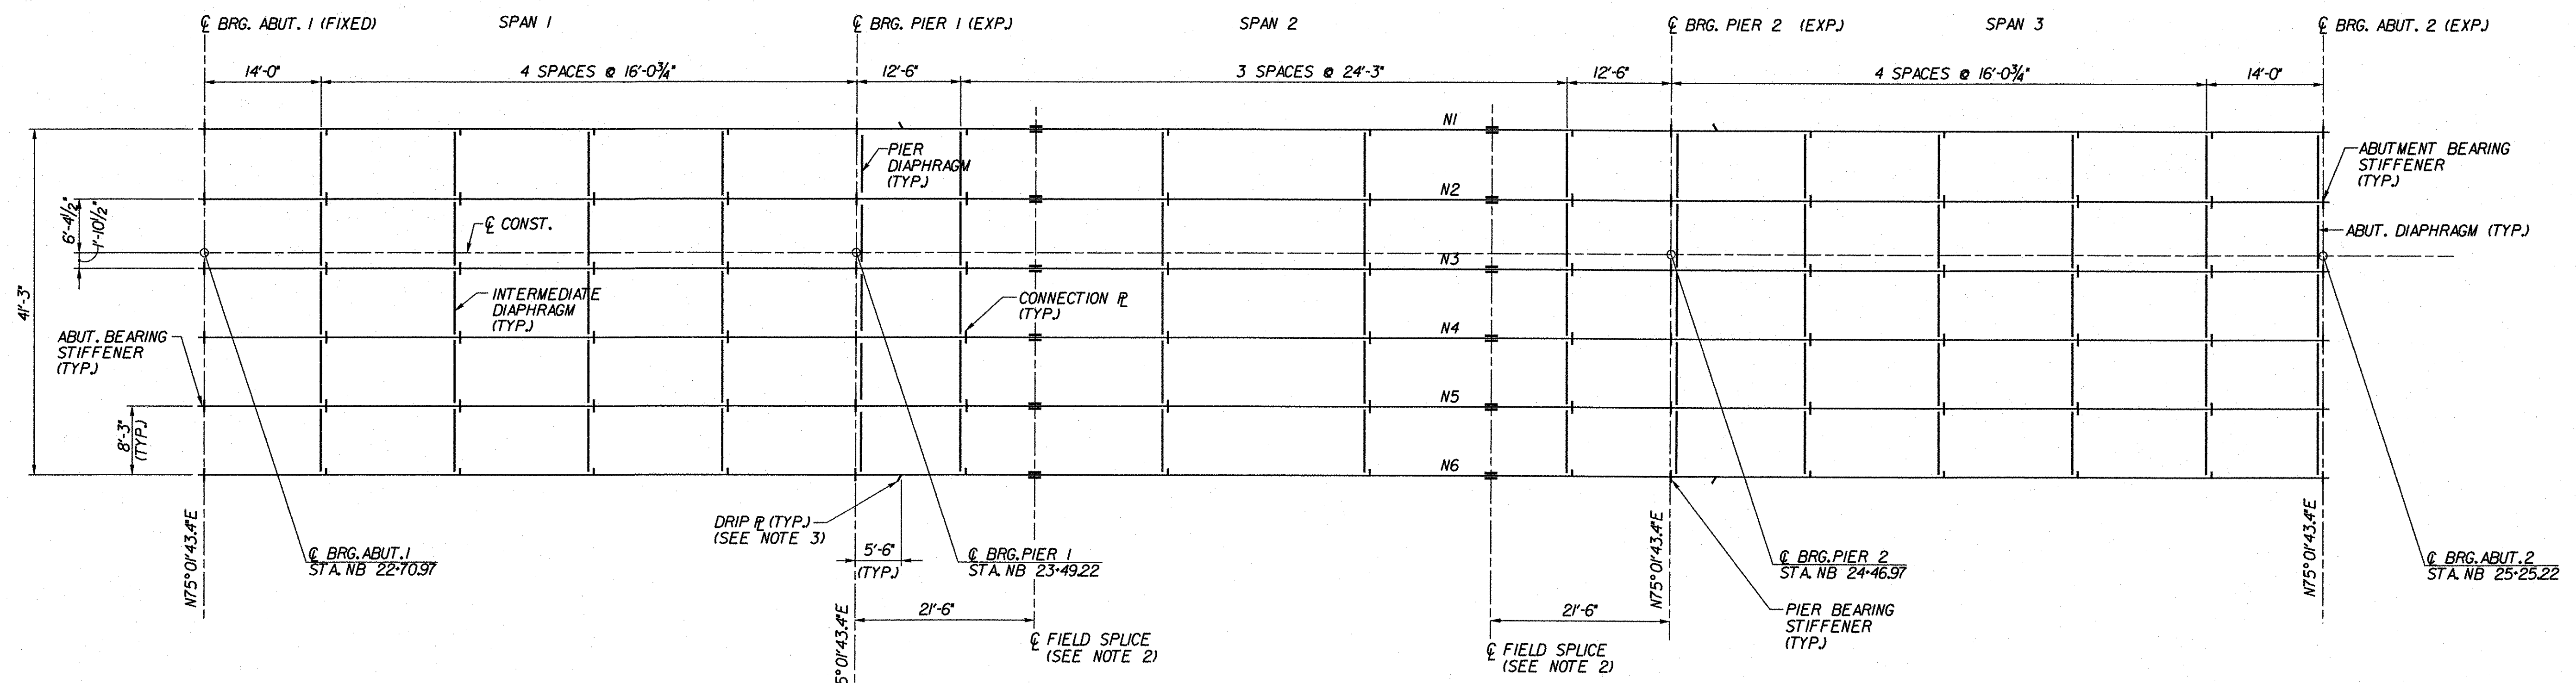

FRAMING PLAN (3N)
SCALE: 3/32" = 1'-0"

NOTES:

1. FOR PLATE GIRDER AND DIAPHRAGM DETAILS, SEE STEEL DETAILS (3N&S), BRIDGE SHEET BR124.
2. FOR FIELD SPlice DETAILS, SEE SPlice DETAILS (3N&S), BRIDGE SHEET BR125.
3. FOR DRIP PLATE DETAIL, SEE TYPICAL BRIDGE DETAILS (3N&S), BRIDGE SHEET BR129.

**STATE OF VERMONT
AGENCY OF TRANSPORTATION**

| | | | |
|--|-------------|--------------------------|-----------------|
| Town Of | GUILFORD | Bridge No. | 3N&S |
| Highway No. | I-91 | Log Sta. | |
| | | Surv. Sta. | |
| I-91 OVER BROAD BROOK & BROAD BROOK ROAD | | | |
| FRAMING PLANS (3N&S) | | | |
| Designed By | M. J. MOZER | Drawn By | G.K. MORZE |
| Checked By | Date | Bridge Design Supervisor | |
| P.W. SZUSTAK | 01/03 | J.P. HALSTEAD | Date 01/03 |
| PROJECT | GUILFORD | PROJECT NO. | IM 091-1(33) |
| TVGA CAD Drawing No. G FRPLAN | | Date 04/28/08 | |
| Bridge Sheet No. | BR121 | Sheet | 47 of 114 |