



TYPICAL SECTION BETWEEN GIRDERS
SCALE: 3" = 1'-0"

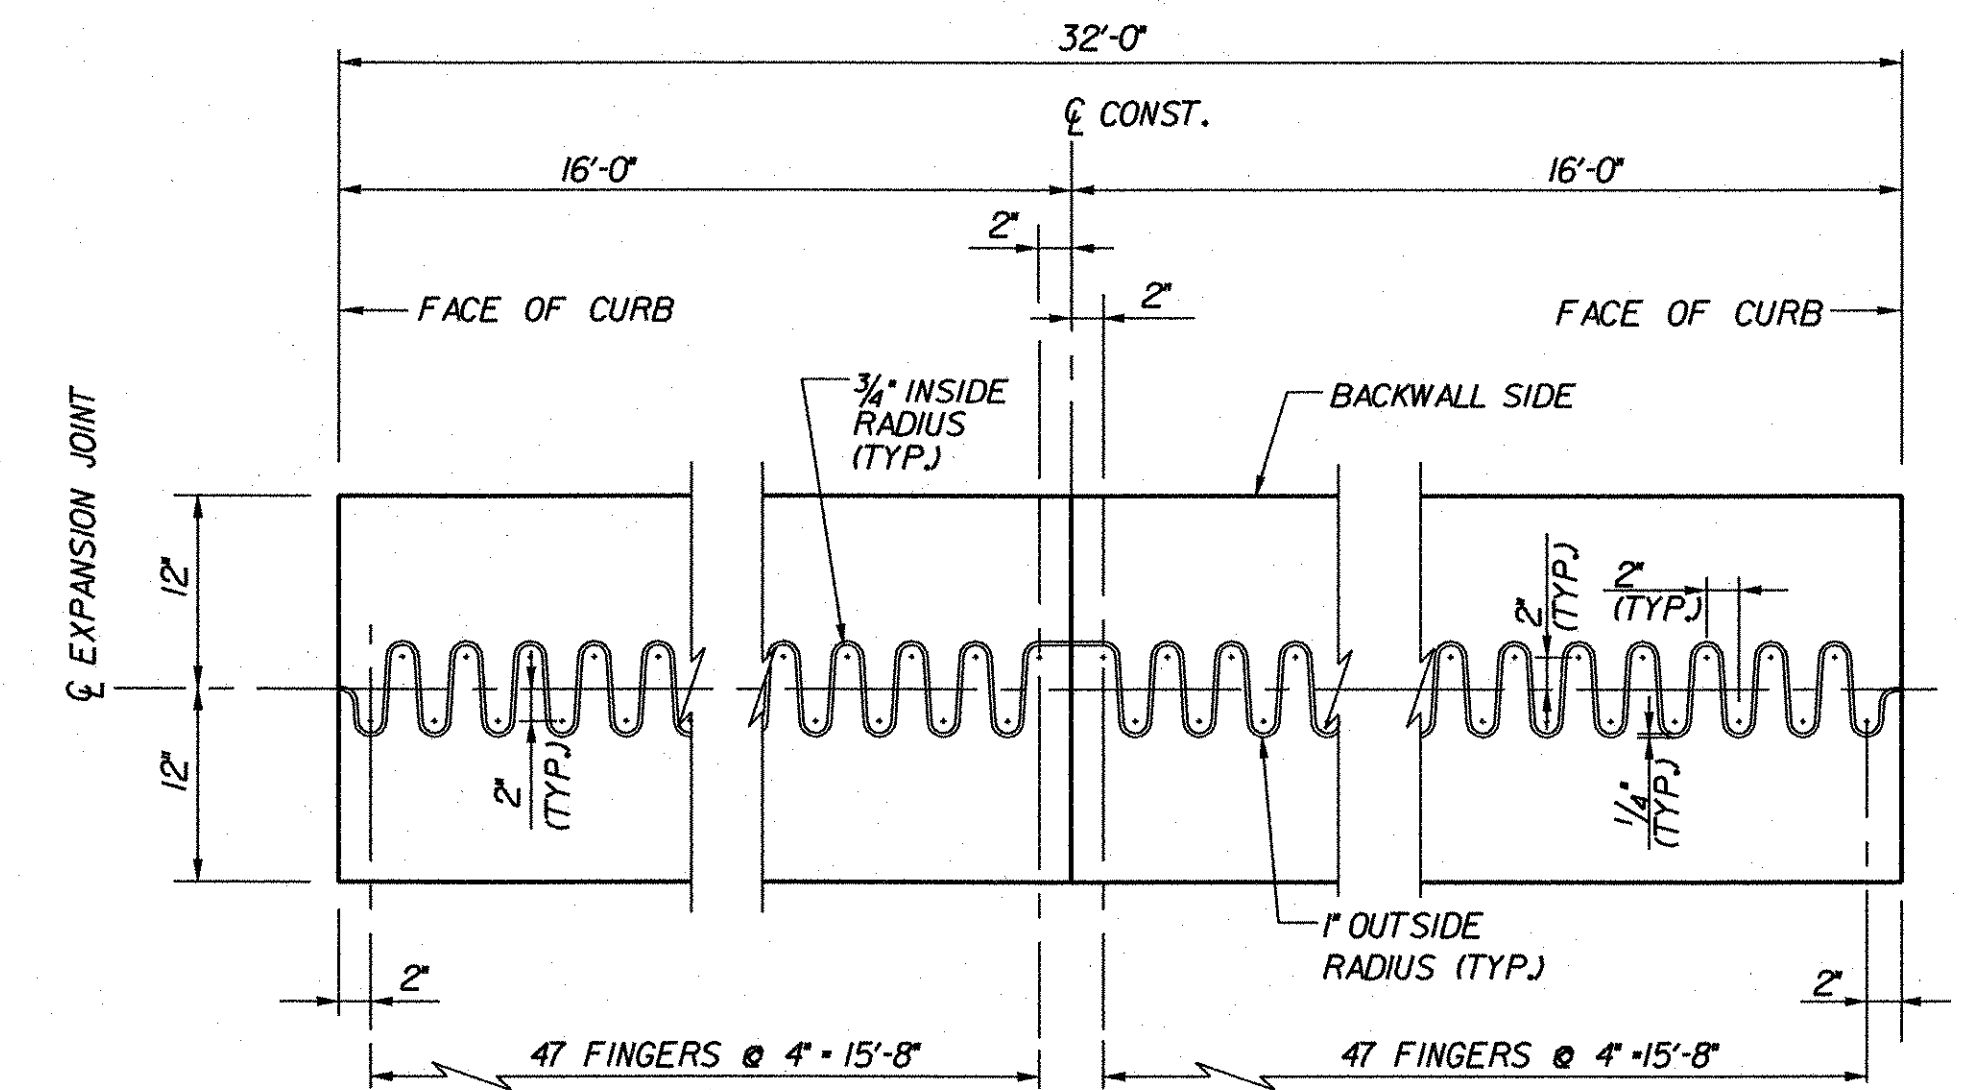

CUTTING DETAIL (3S)
SCALE: 1" = 1'-0"

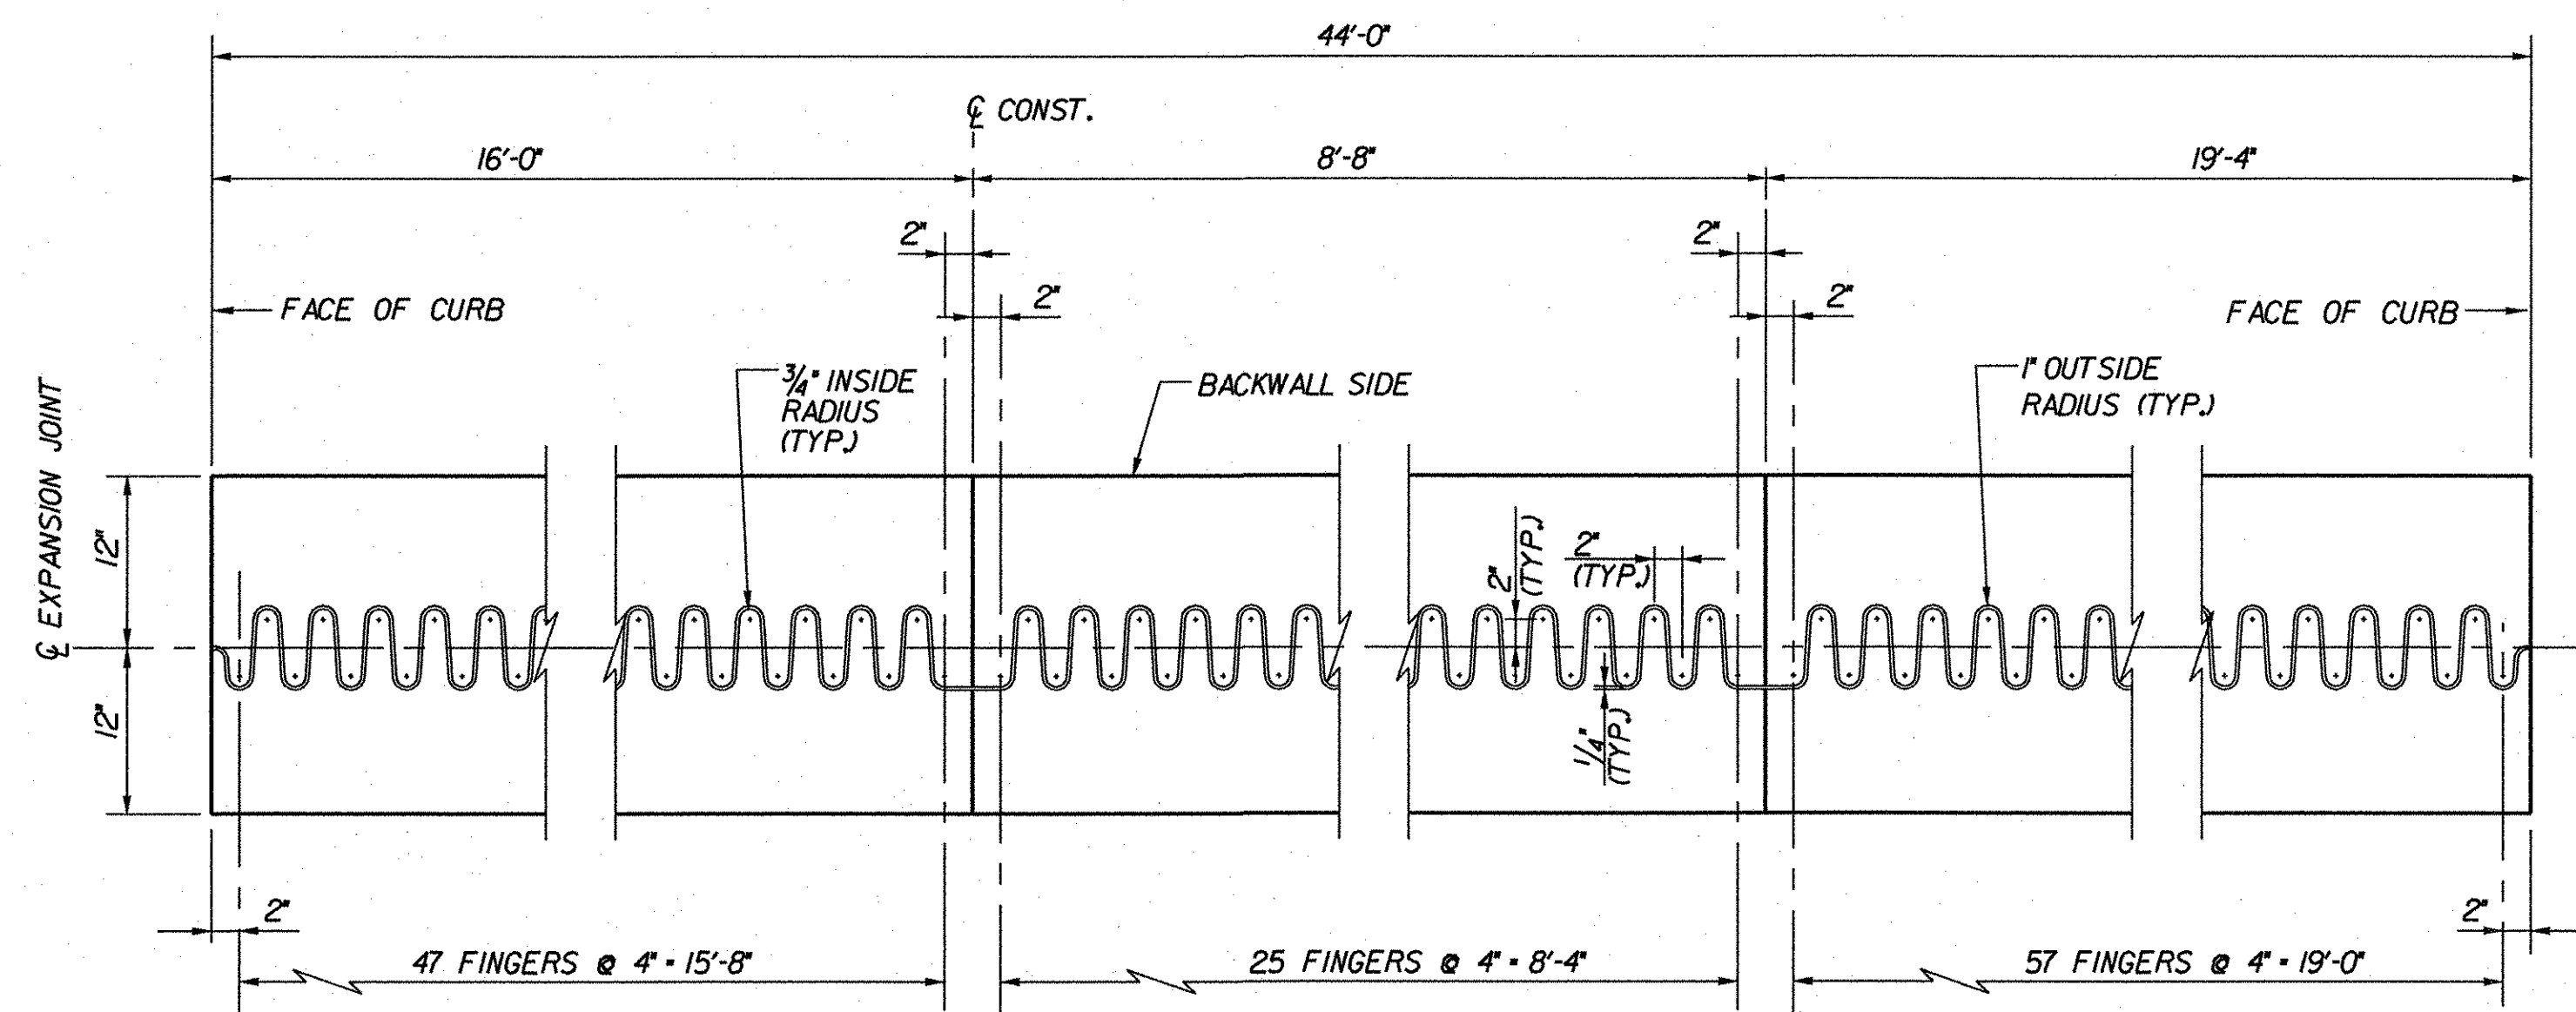

CUTTING DETAIL (3N)
SCALE: 1" = 1'-0"

NOTES:

- FOR FINGER JOINT NOTES, SEE FINGER JOINT DETAILS (2 OF 2) BRIDGE SHEET BR127A.

**STATE OF VERMONT
AGENCY OF TRANSPORTATION**

Town Of	GUILFORD	Bridge No.	3N&S
Highway No.	I-91	Log Sta.	
		Surv. Sta.	
I-91 OVER BROAD BROOK & BROAD BROOK ROAD			
FINGER JOINT DETAILS (1 OF 2) (3N&S)			
Designed By	M.J. MOZER	Drawn By	G.K. MORZE
Checked By	Date	Bridge Design Supervisor	
P.W. SZUSTAK	01/03	J.P. HALSTEAD	Date 01/03
PROJECT	GUILFORD	PROJECT NO.	IM 091-1(33)
TVGA CAD Drawing No.	G-FJTD.dgn	Date	05/22/08
Bridge Sheet No.	BR127	Sheet	53 of 114