


CURTAINWALL PLAN (FIXED) (3N)

SCALE: 1/2" = 1'-0"

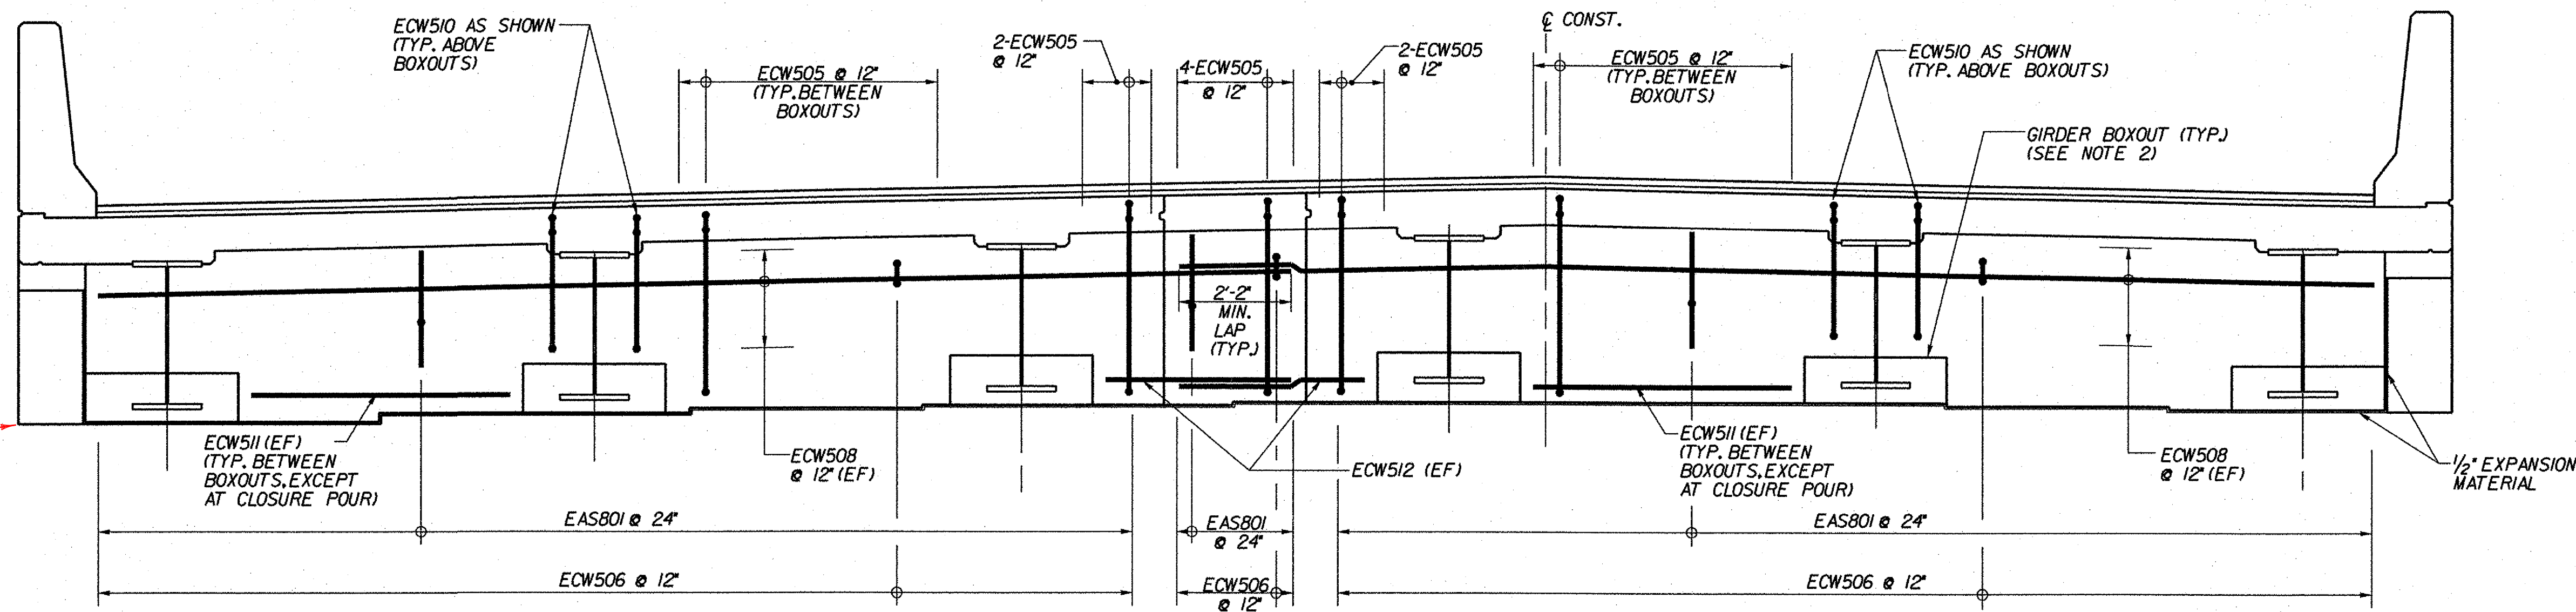

CURTAINWALL ELEVATION (3N)

SCALE: 1/2" = 1'-0"

ADDED WATER STOP BETWEEN CURTAINWALL AND BRIDGE SEAT

NOTES:

1. FOR DETAILS OF DECK REINFORCEMENT, SEE DECK REINFORCEMENT (3N), BRIDGE SHEET BR116.
2. FOR SECTION A-A, B-B AND BOXOUT DETAILS, SEE ABUTMENT 2 CURTAINWALL DETAILS (3S), BRIDGE SHEET BR146.
3. CURTAINWALL CLOSURE POUR SHALL BE POURED CONTINUOUSLY WITH DECK CLOSURE POUR. FOR FURTHER INFORMATION, SEE STAGED CONSTRUCTION DETAILS (1 OF 2) (3N), BRIDGE SHEET BR112.

**STATE OF VERMONT
AGENCY OF TRANSPORTATION**

Town Of	GUILFORD	Bridge No.	3N
Highway No.	I-91	Log Sta.	
		Surv. Sta.	
I-91NB OVER BROAD BROOK & BROAD BROOK ROAD			
ABUTMENT 1 CURTAINWALL DETAILS (3N)			
Designed By	M.J. MOZER	Drawn By	G.K. MORZE
Checked By	P.W. SZUSTAK	Bridge Design Supervisor	J.P. HALSTEAD
Date	01/03	Date	01/03
PROJECT	GUILFORD	PROJECT NO.	IM 091-1(33)
		Date	04/28/08
		Sheet	61 of 114