 


NOTES:

- 1. STREAM BANK SLOPES UP TO ELEVATION 359.6 SHALL BE STABILIZED WITH TYPE III STONE FILL.
- 2. UNCLASSIFIED EXCAVATION SHALL BE APPROXIMATE TO THAT OF TYPE III STONE FILL.
- 3. QUALITY ASSURANCE SHALL BE APPROXIMATE TO THAT OF TYPE III STONE FILL. SEE GENERAL NOTES, BRIDGE SHEET 800.
- 4. ERY BANKS FOR UNCLASSIFIED EXCAVATION SHALL EXTEND TO EL. 359.6, ANY EXCAVATION ABOVE THIS ELEVATION SHALL BE FOR UNDER FIRM 20337, UNCLASSIFIED EXCAVATION.

**STATE OF VERMONT
AGENCY OF TRANSPORTATION**

Project No.	0131
Highway No.	1-8 OVER BROAD BROOK & BROAD BROOK ROAD
Sheet No.	3M45
Scale	1" = 20'
Checked by	J.P. HUSTON
Drawn by	J.P. HUSTON
Project No.	0131
Project Name	1-8 OVER BROAD BROOK & BROAD BROOK ROAD
Project No.	0131
Project Name	1-8 OVER BROAD BROOK & BROAD BROOK ROAD
Project No.	0131
Project Name	1-8 OVER BROAD BROOK & BROAD BROOK ROAD



TVA ENGINEERING & SURVEYING P.C.
1000 Main Street, Montpelier, VT 05602