



**END CONSTRUCTION
MATCH EXISTING BCP
STA. NB 33+15.00**

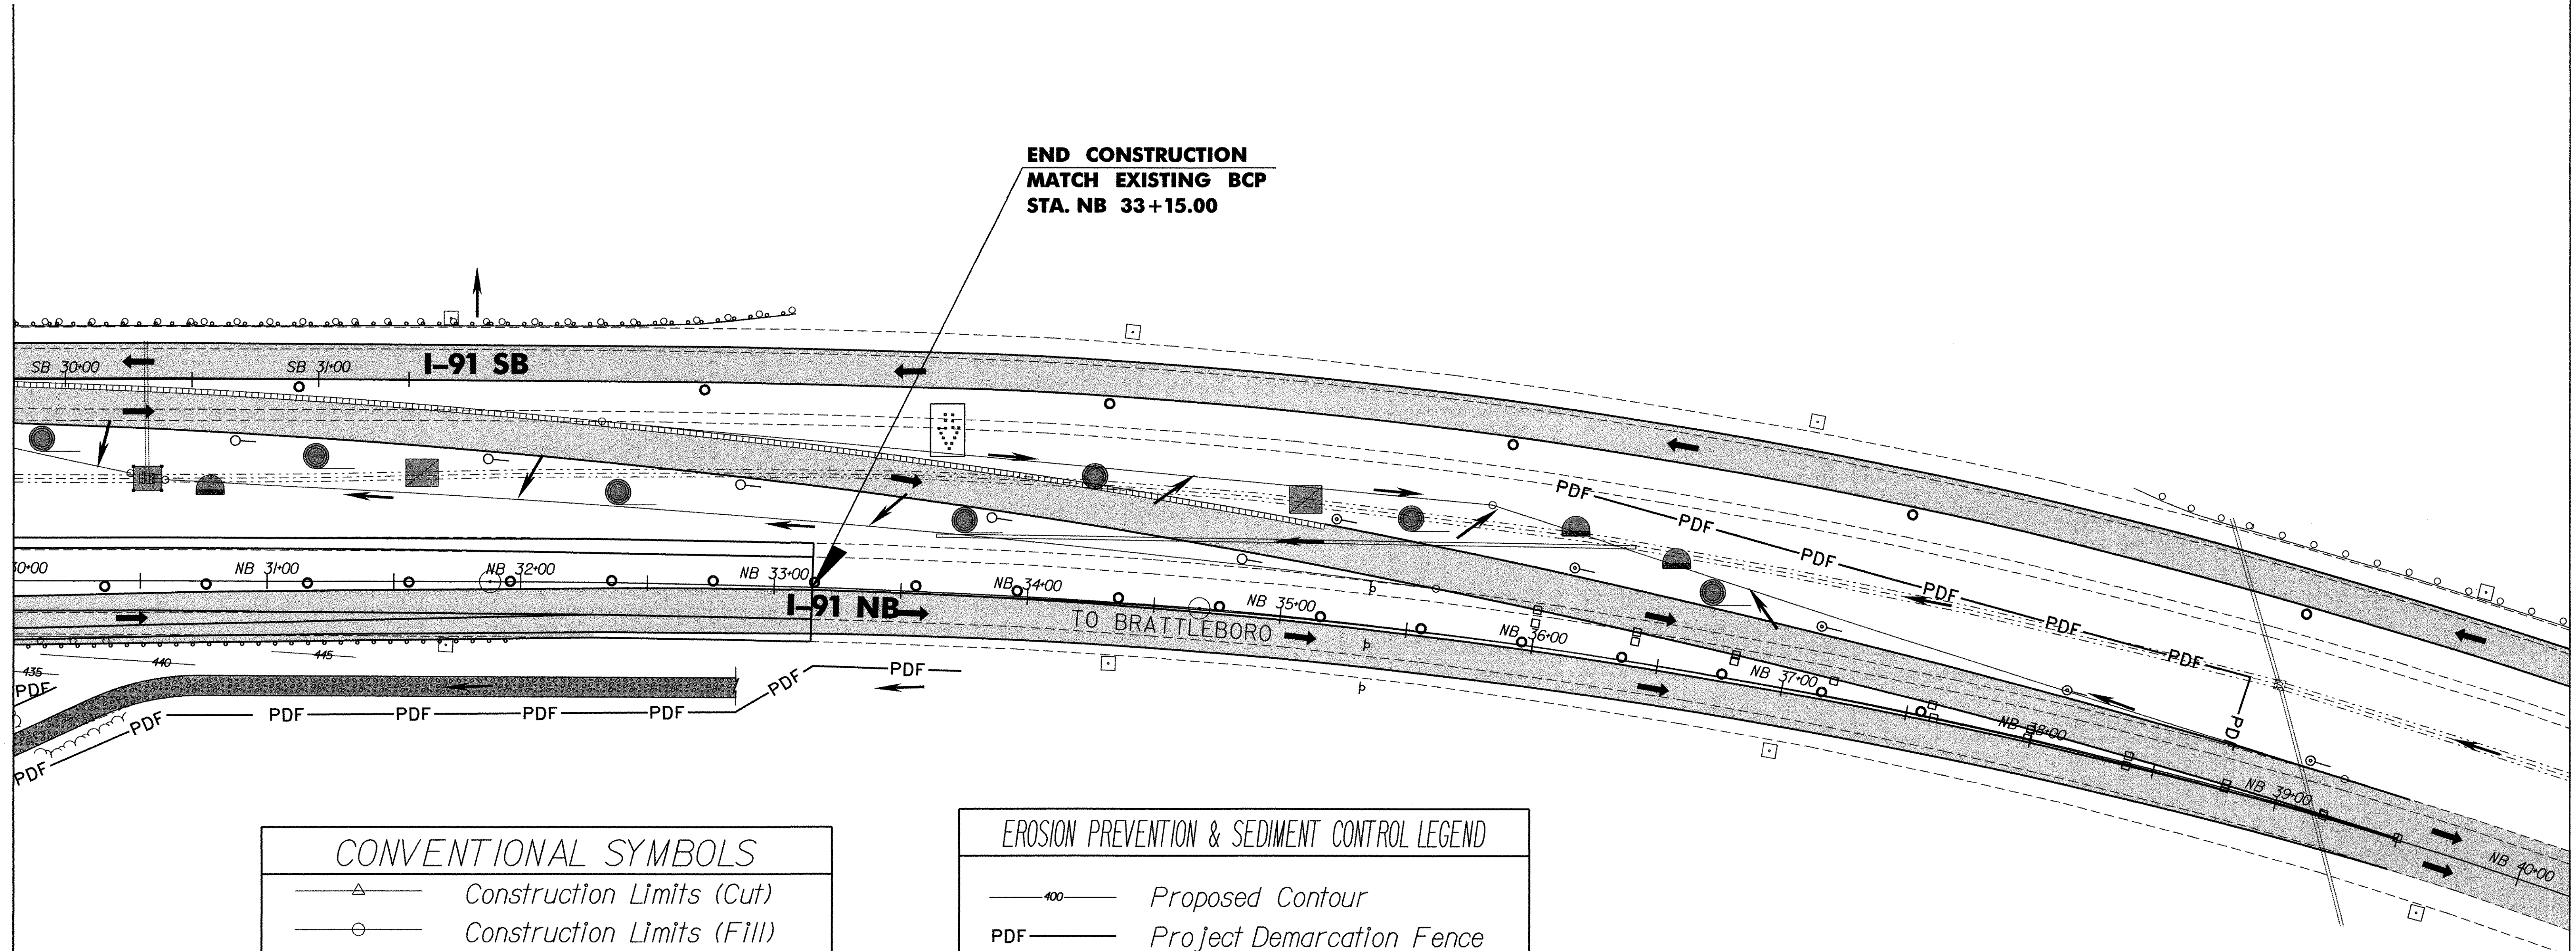

CONVENTIONAL SYMBOLS	
	Construction Limits (Cut)
	Construction Limits (Fill)
	Fence
	Existing Contour
	Guard Rail
	Stone Fill
	Traffic Flow

EROSION PREVENTION & SEDIMENT CONTROL LEGEND	
	Proposed Contour
	Project Demarcation Fence
	Silt Fence
	Runoff Flow Direction
	Inlet Protection Device, Type I
	Stone Check Dam, Type I
	Temporary Erosion Matting
	Surface Roughening

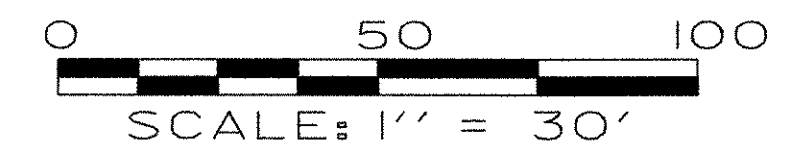

EPSC - PHASE 1 /STAGE B	
PROJECT NAME:	GUILFORD
PROJECT NUMBER:	IM 091-(133)
FILE NAME:	95a176/str/sal76epsclB.dgn
PROJECT LEADER:	Farnsworth
DESIGNED BY:	STRI
PLOT DATE:	11-JUN-2008
DRAWN BY:	Weeber
CHECKED BY:	Farnsworth
SHEET	93C OF 114