
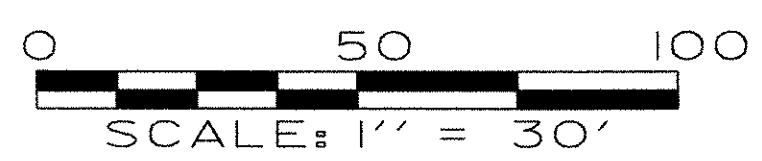


LEGEND	
	Existing Pavement
	New Pavement

CONVENTIONAL SYMBOLS	
	Wooded Area
	Edge of Roadway
	Fence
	Guard Rail
	Drainage Pipe
	Ditch
	Edge of River
	Runoff Flow Direction
	Water Line
	Sewer Line
	Underground Telephone Line

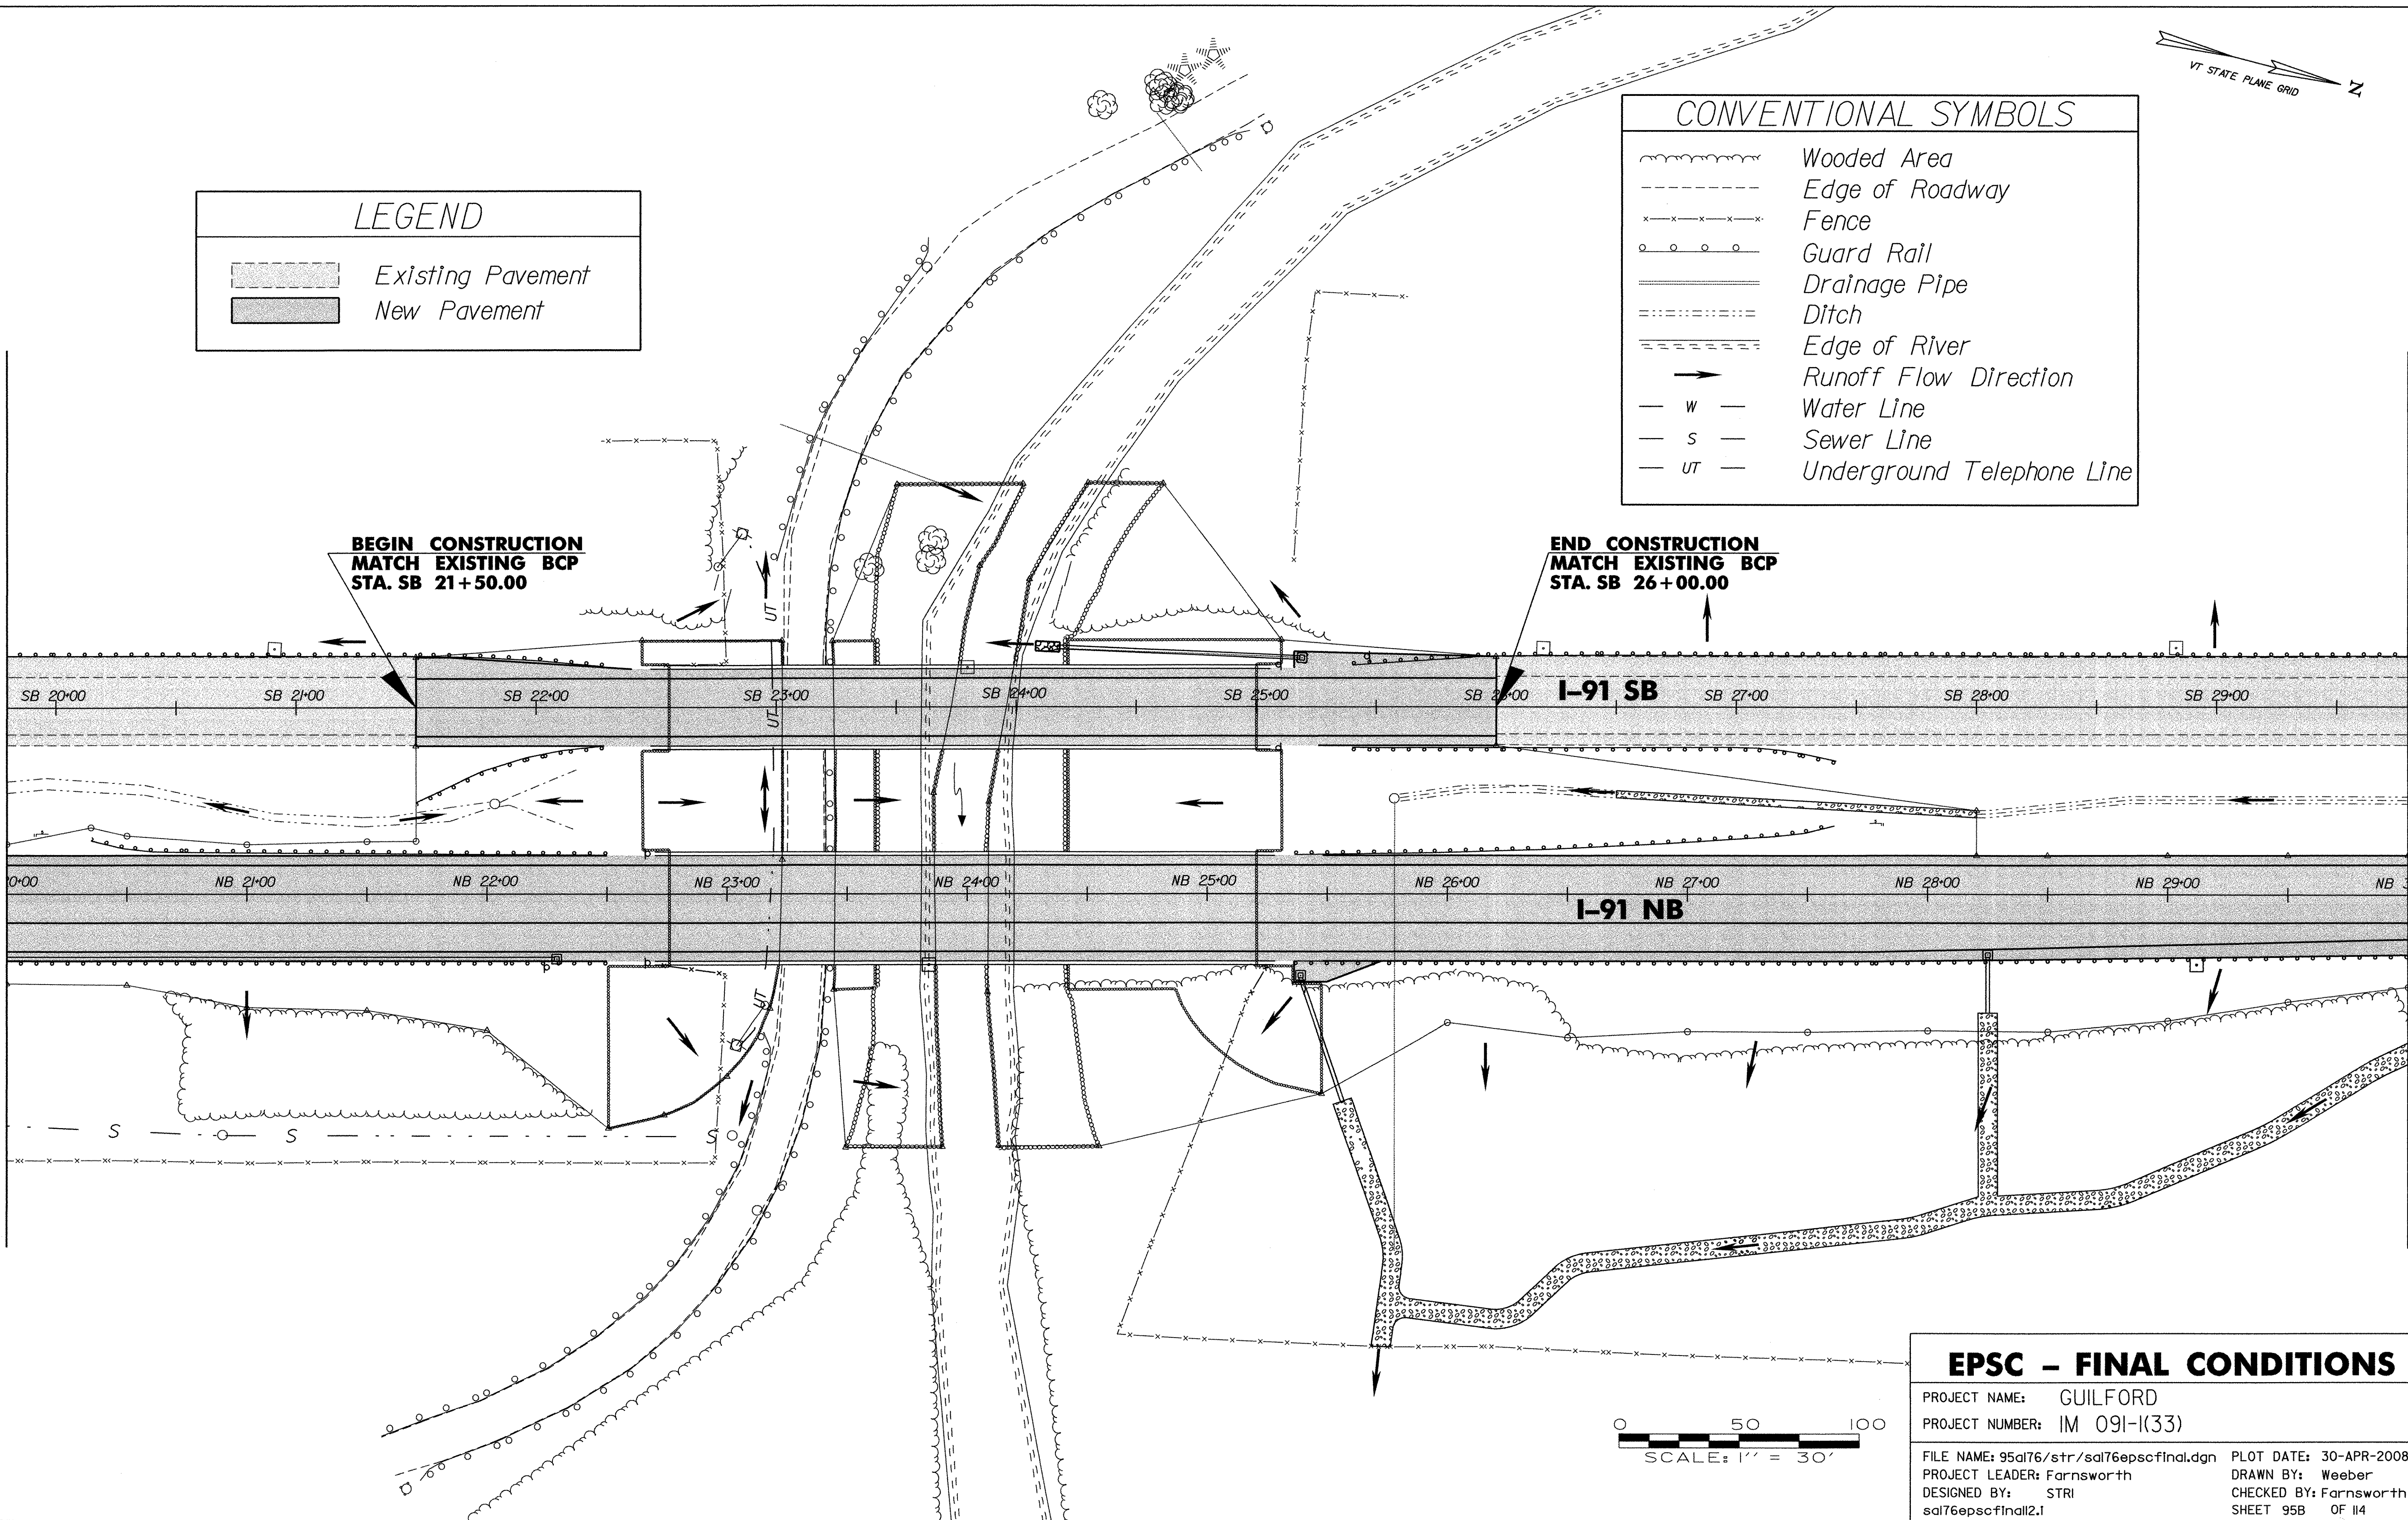

**EPSC - FINAL CONDITIONS**

PROJECT NAME: GUILFORD	PLOT DATE: 30-APR-2008
PROJECT NUMBER: IM 091-I(33)	DRAWN BY: Weeber
FILE NAME: 95a176/str/sal76epscfinal.dgn	CHECKED BY: Farnsworth
PROJECT LEADER: Farnsworth	SHEET 95B OF 114
DESIGNED BY: STRI	